



122+00

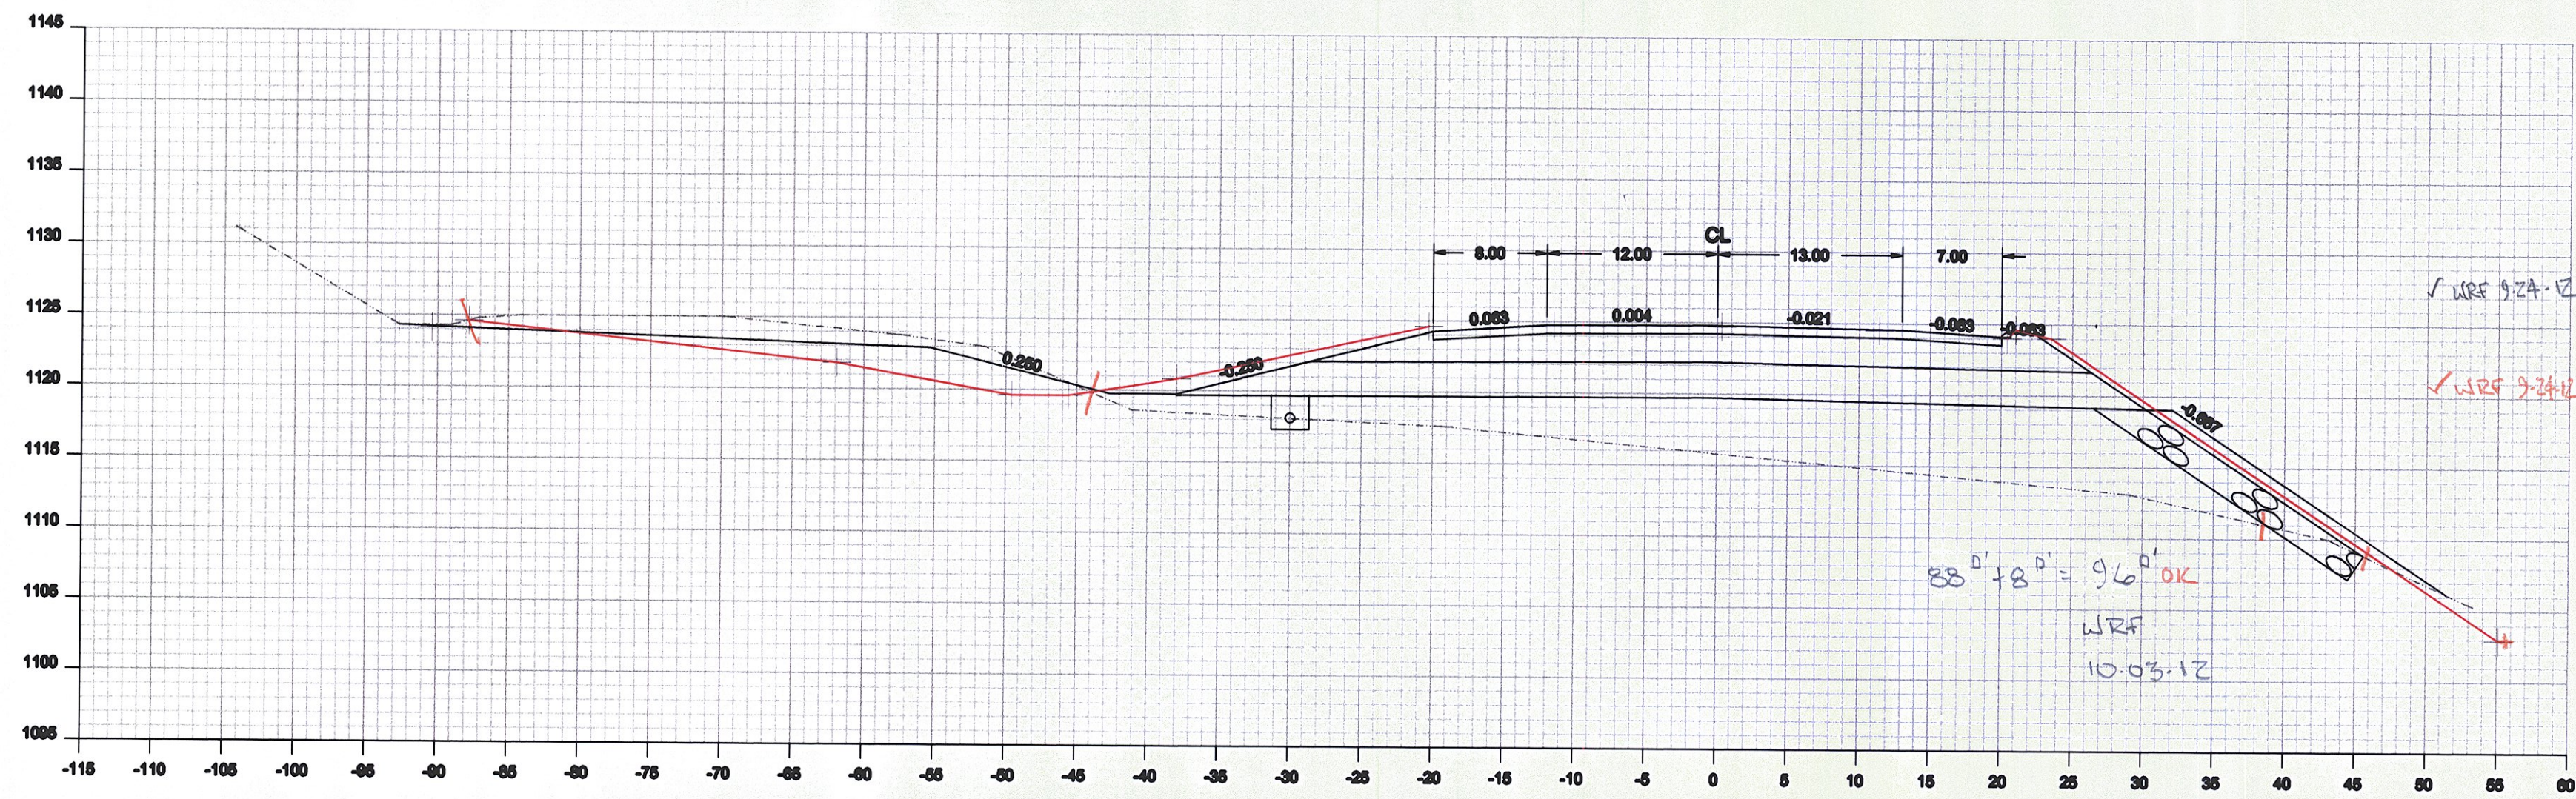

122+00

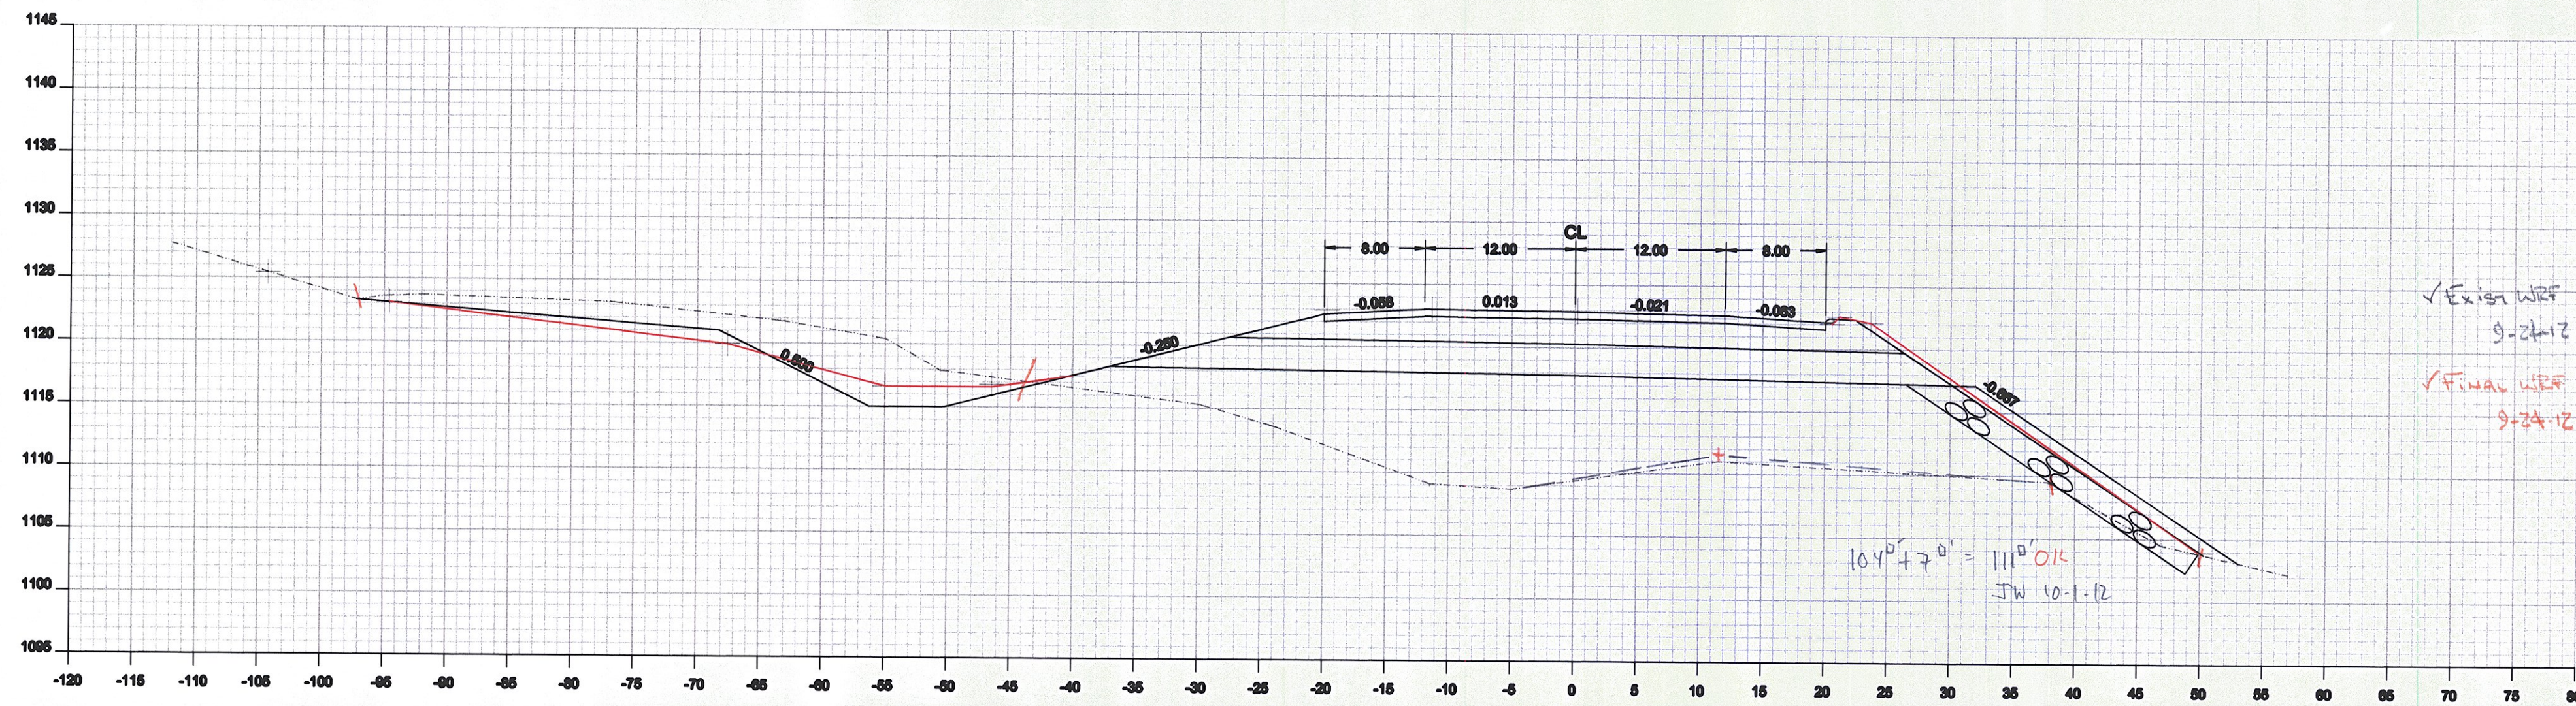

121+00

Drawing:	Section 121+00 - 122+00
Project:	Cabot Danville
Drawn By:	JMR
Date:	09-18-2012
Checked By:	
Date:	
Scale:	1 : 10
Sheet:	of