



152+50

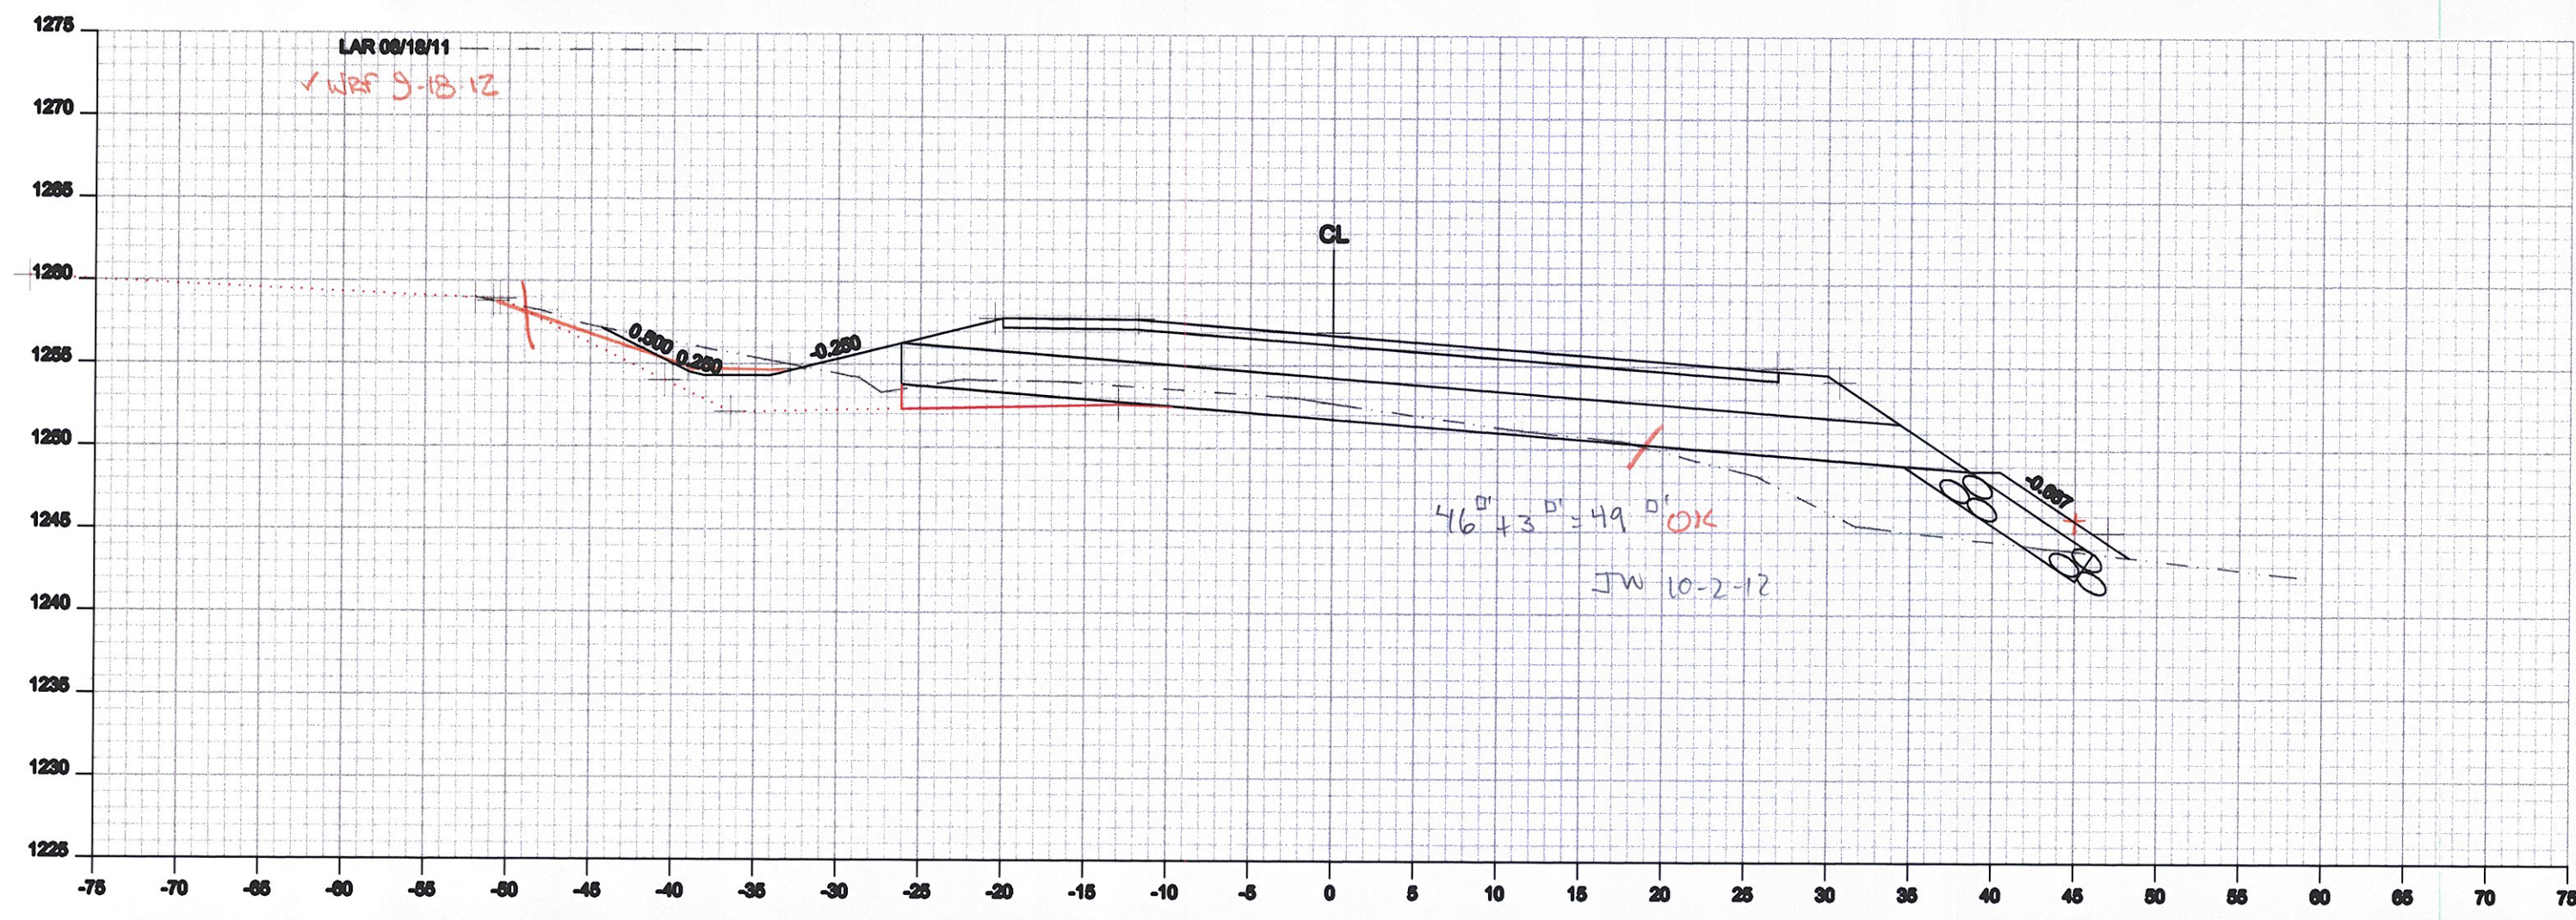

152+00

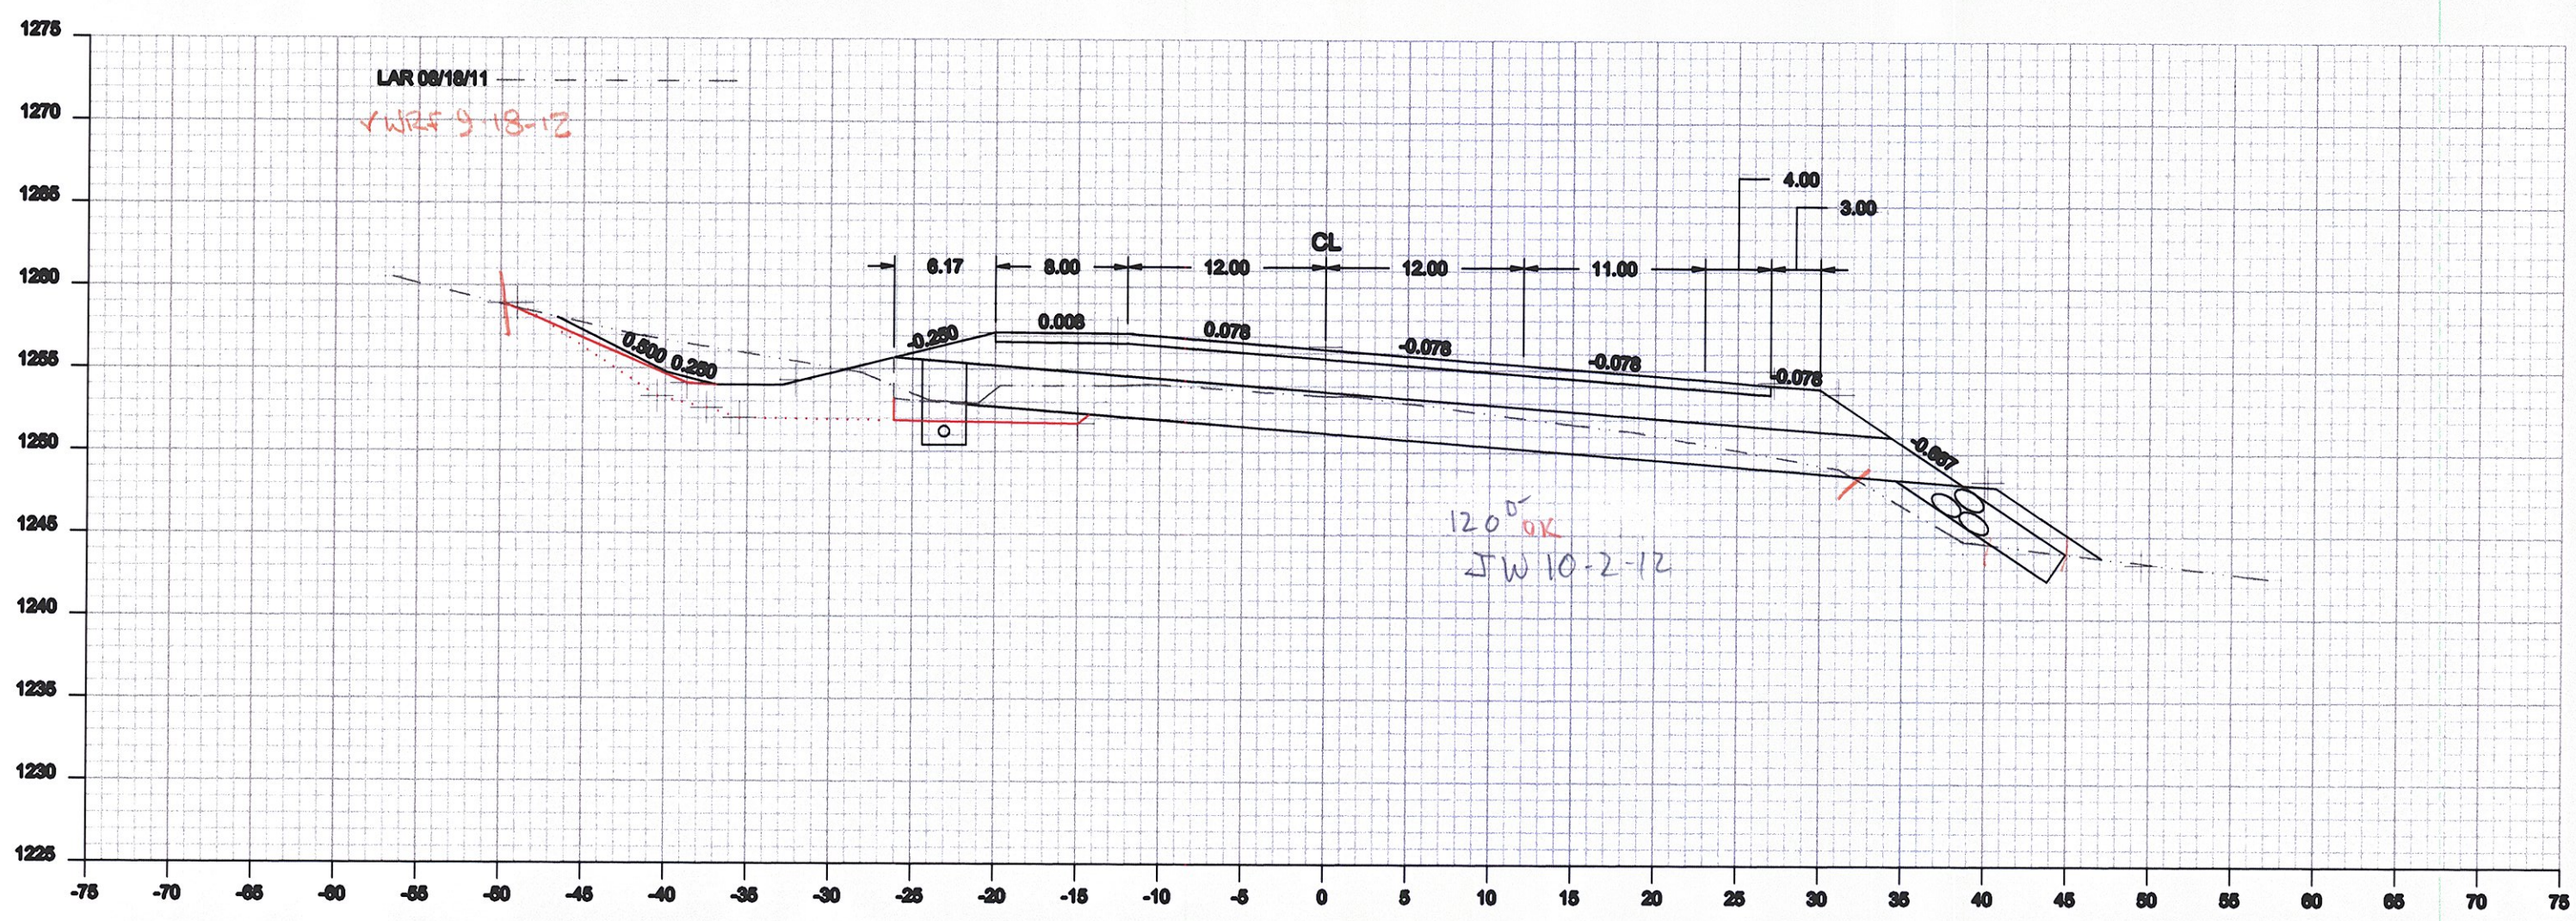

151+50

Drawing: Cross Section 151+50 - 152+50	
Project: Cabot Danville	
Drawn By: JMR	Checked By:
Date: 09-12-2012	Date:
Scale: 1:10	Sheet: of