



159+50

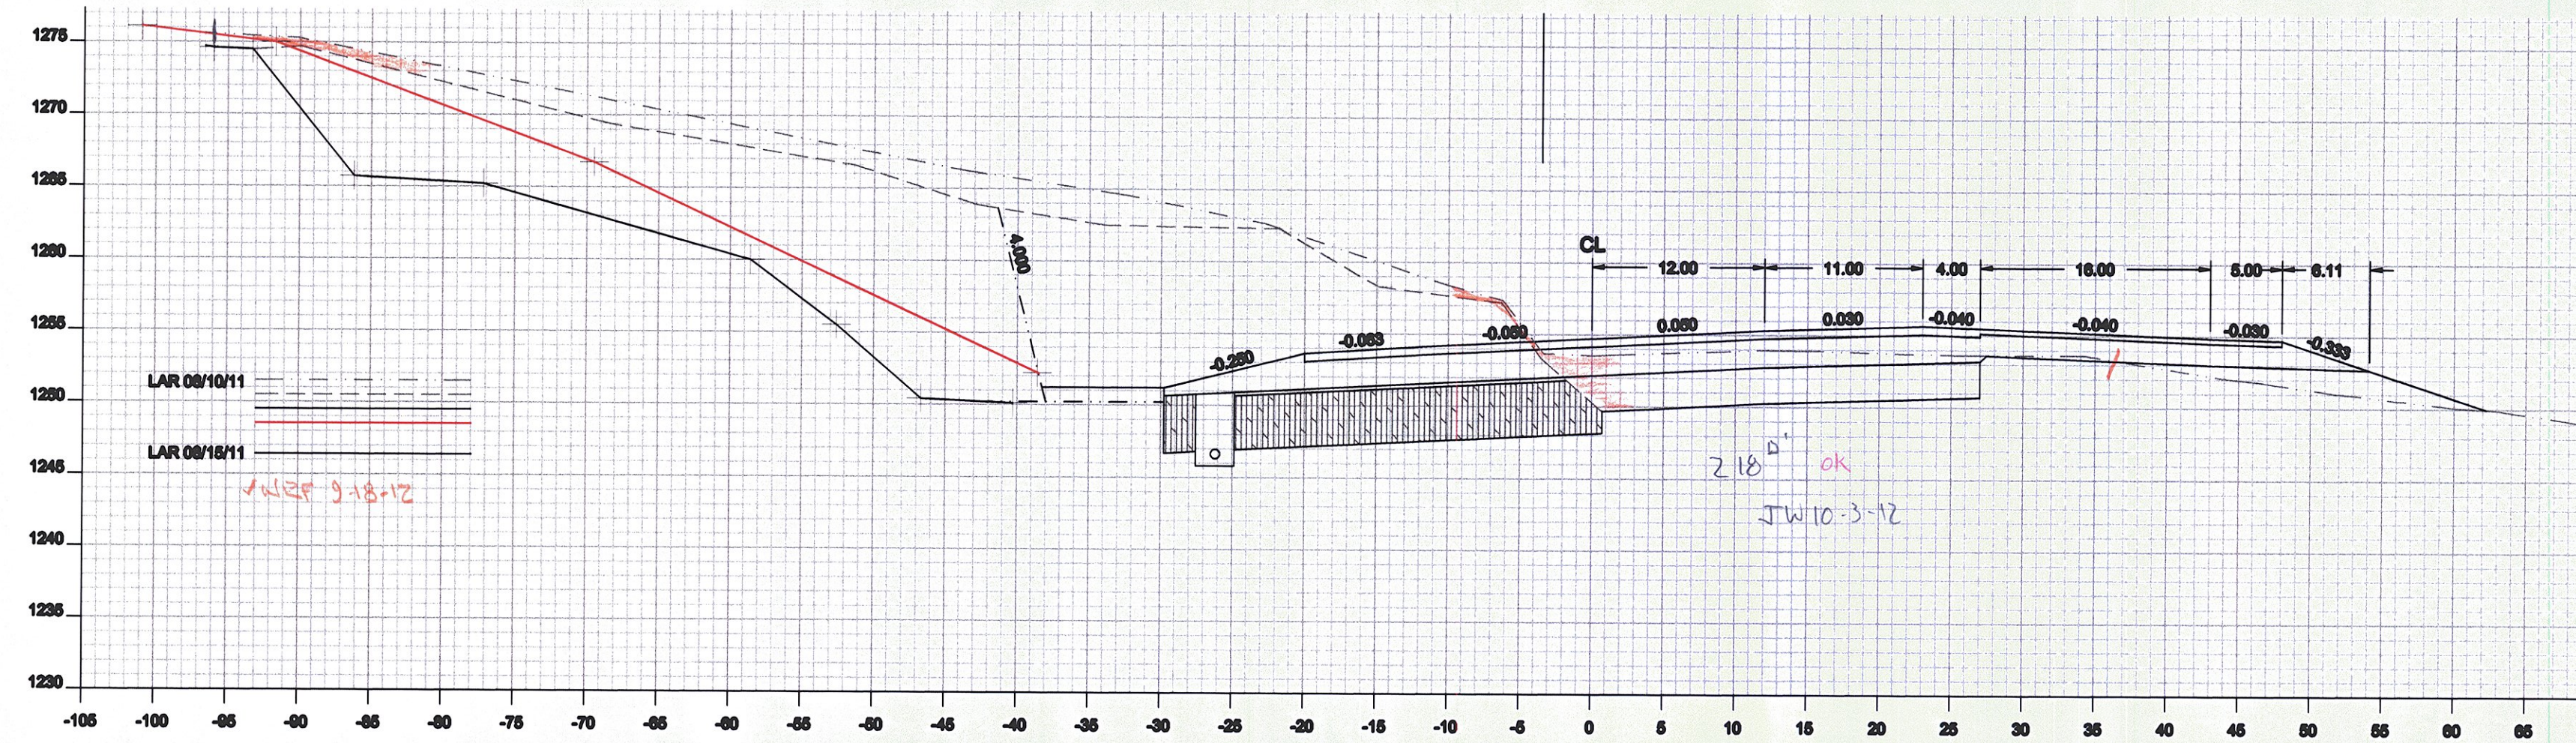

159+25

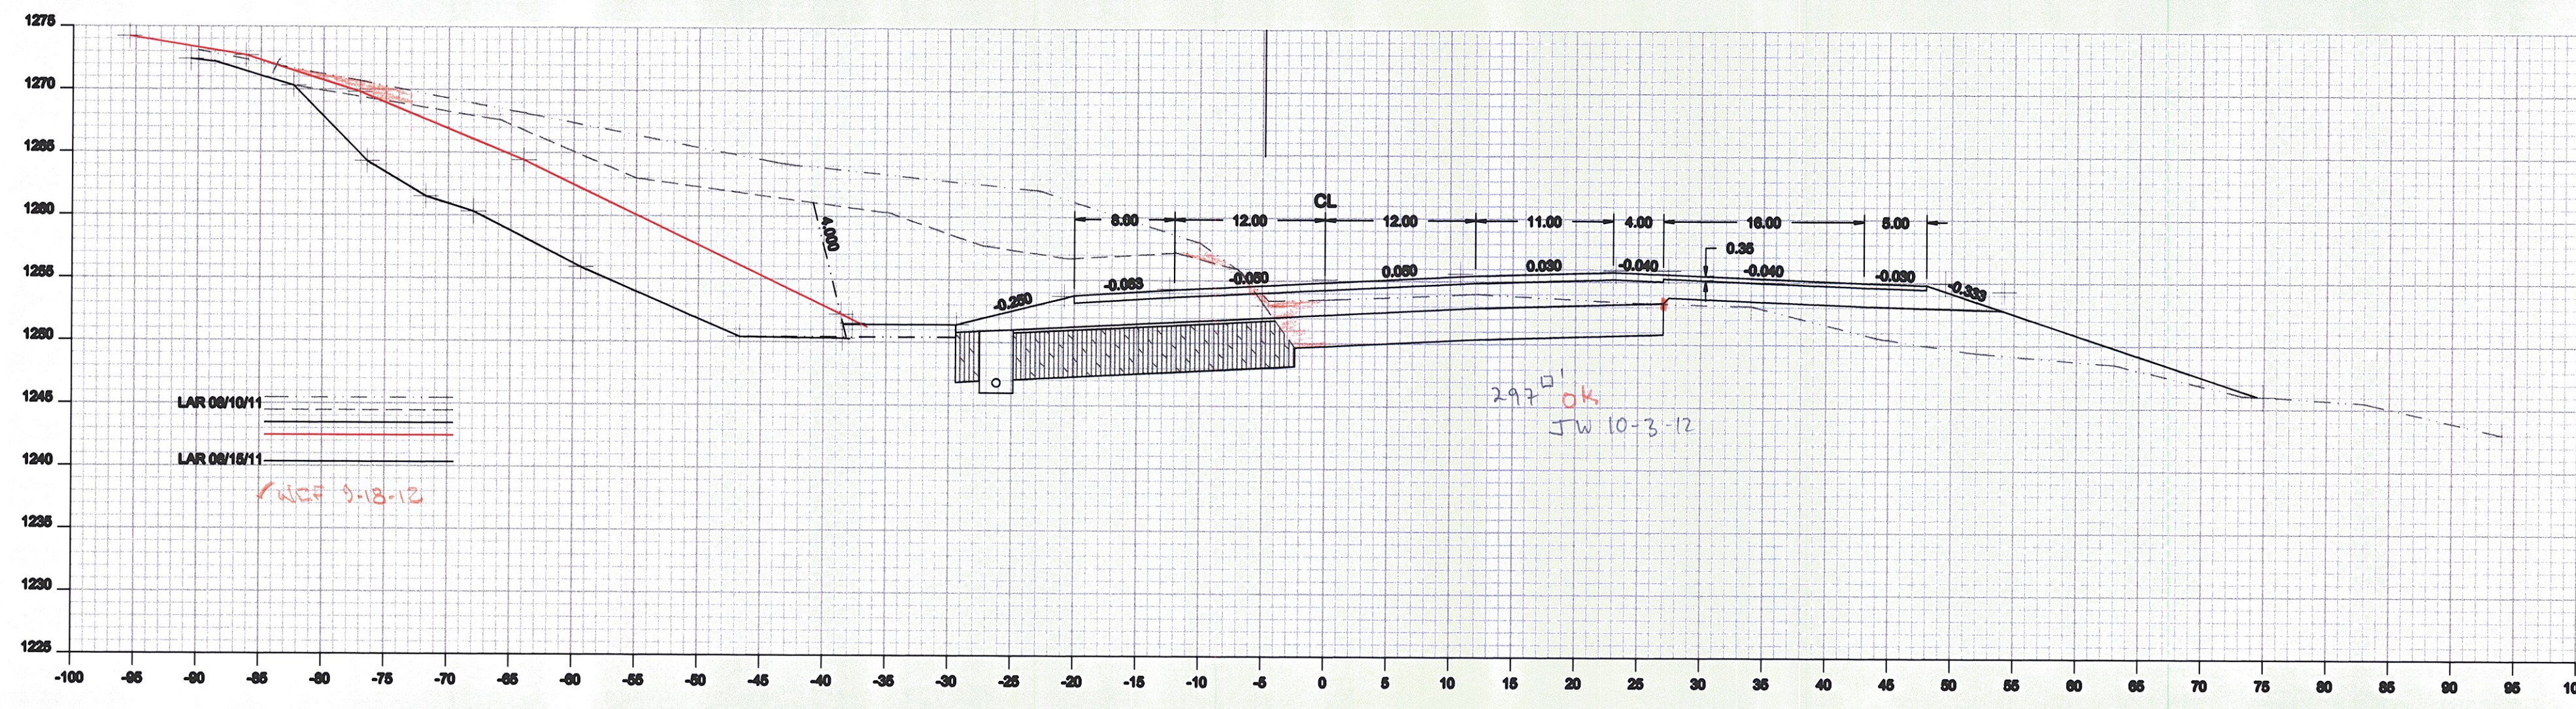

159+00