



164+28  
Skewed

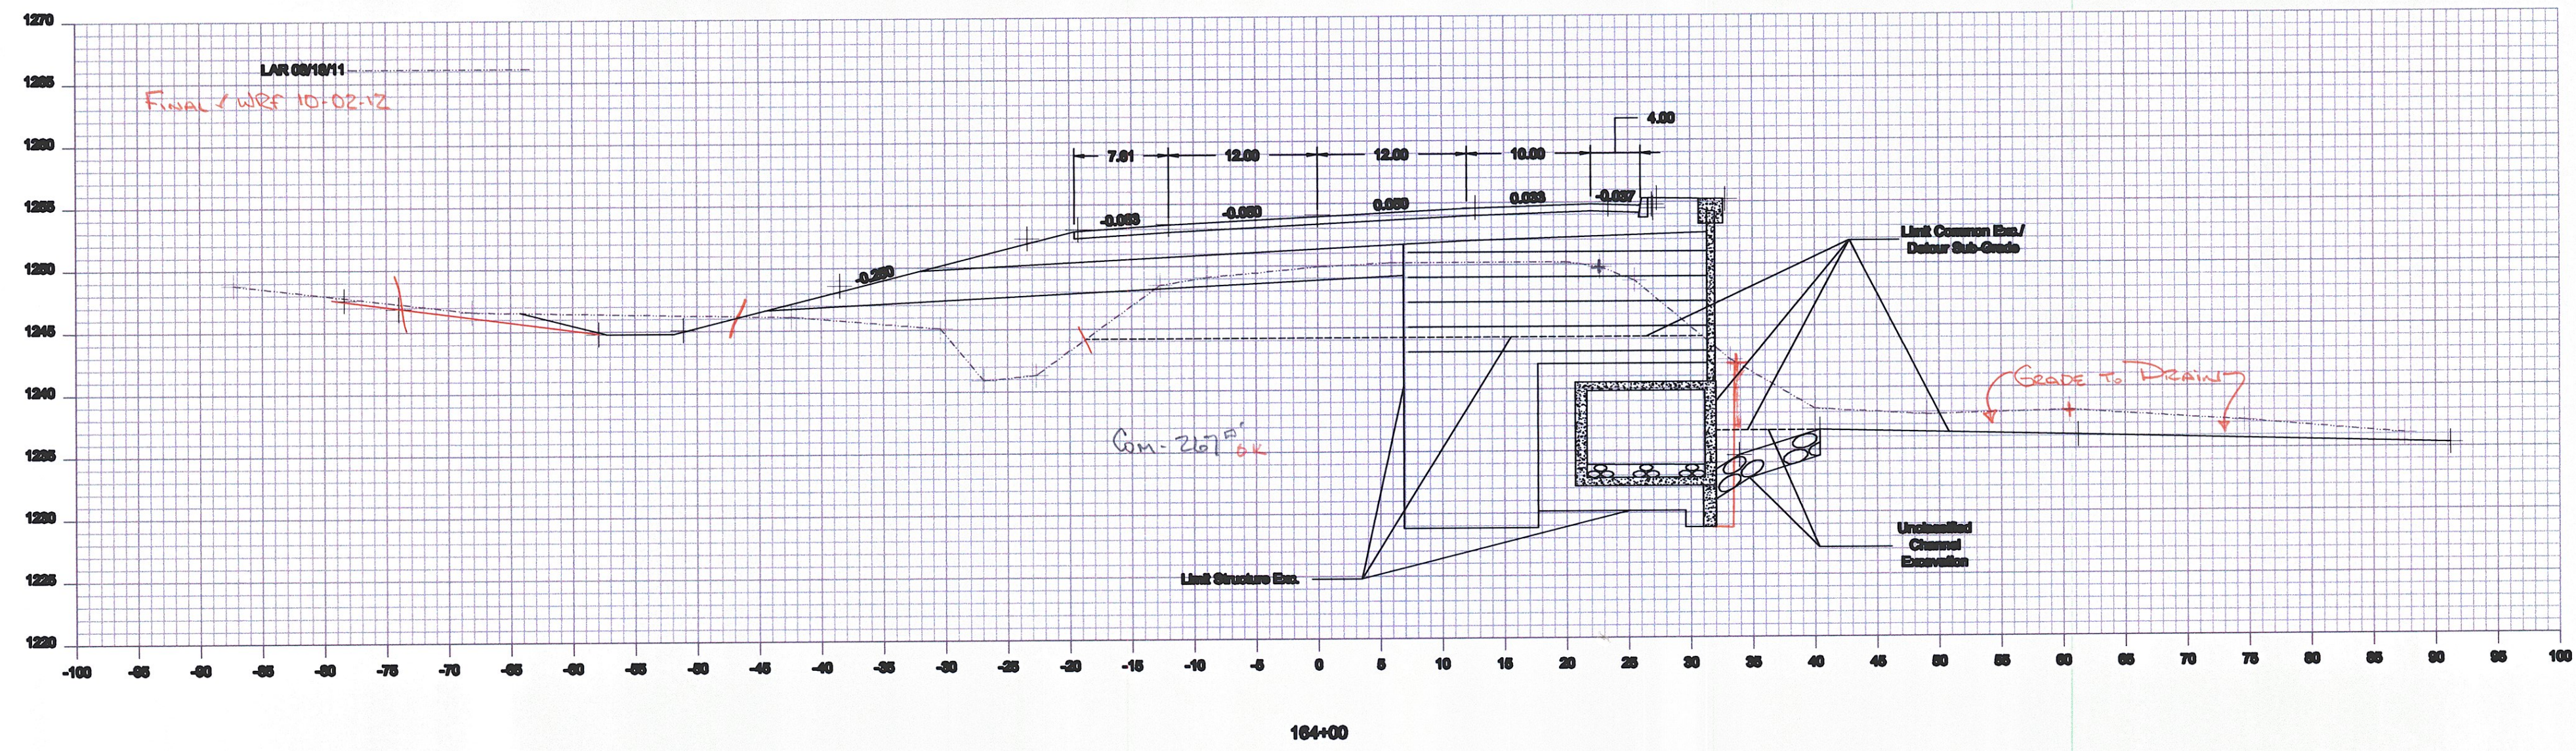

164+00

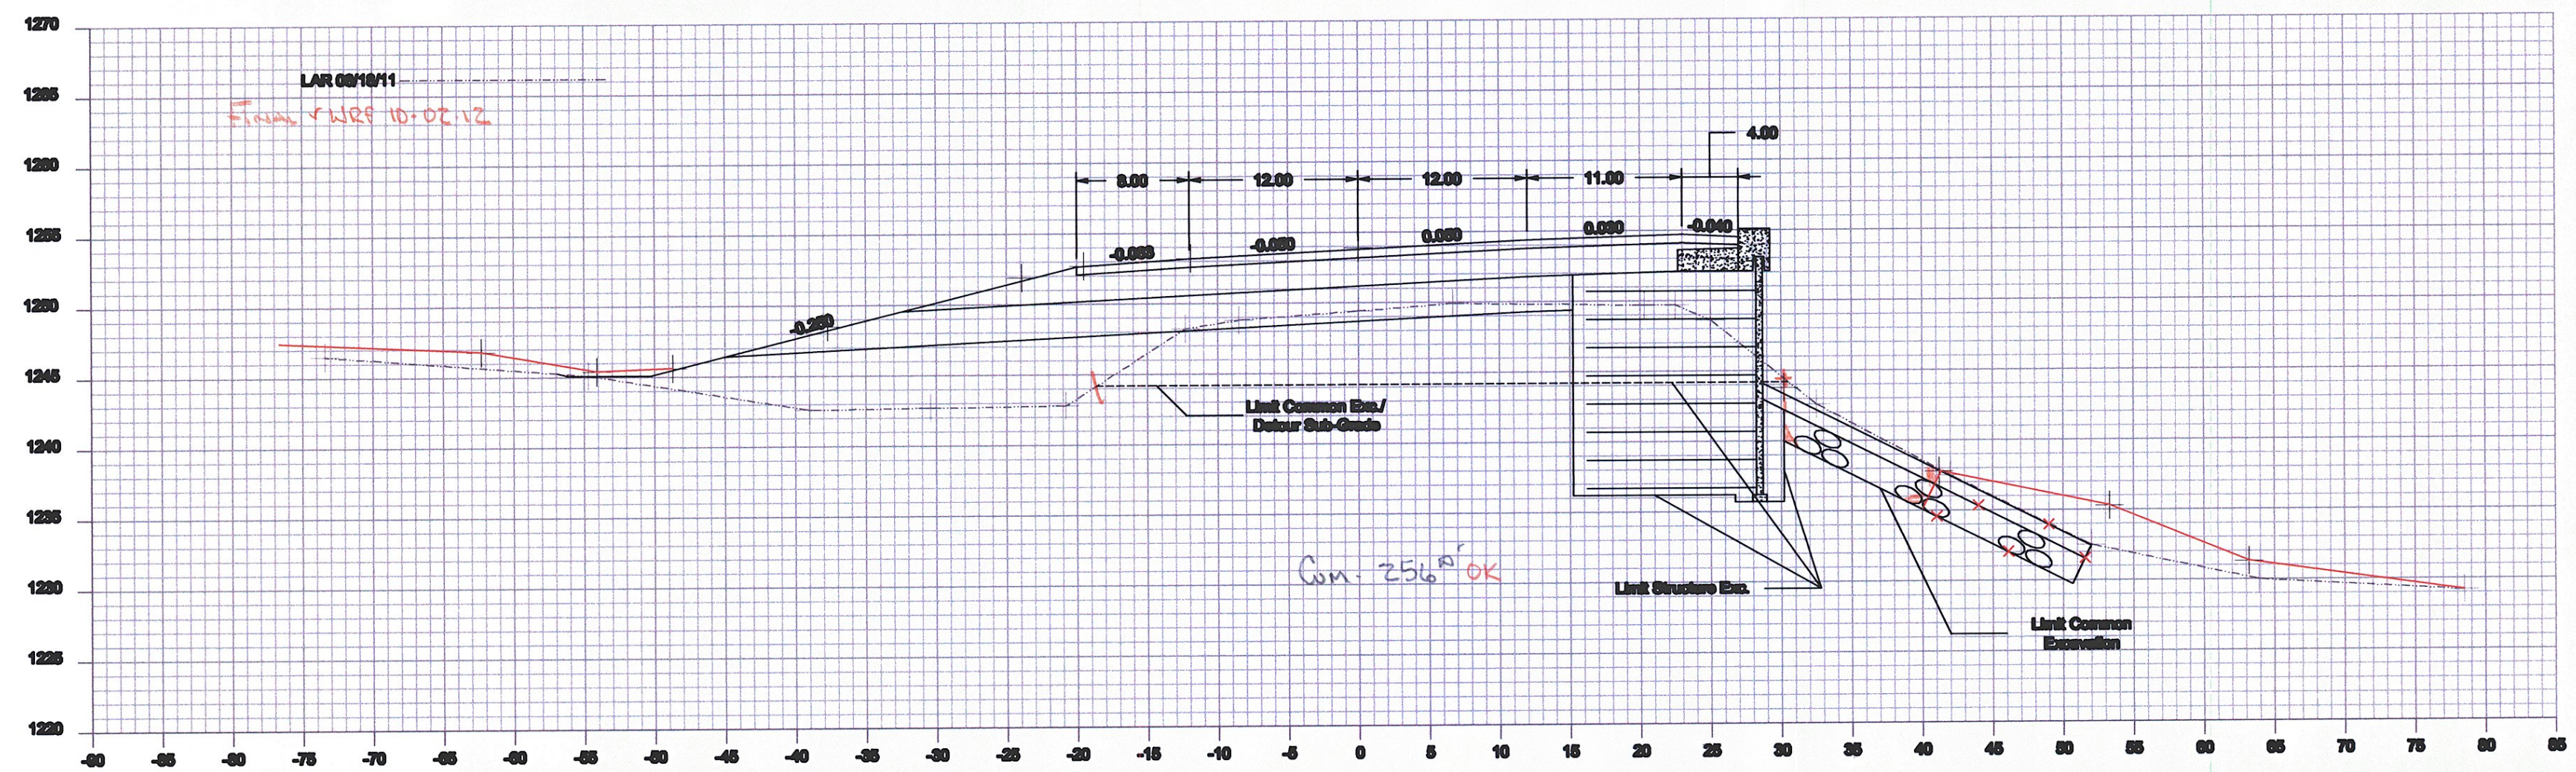

163+00