



165+50

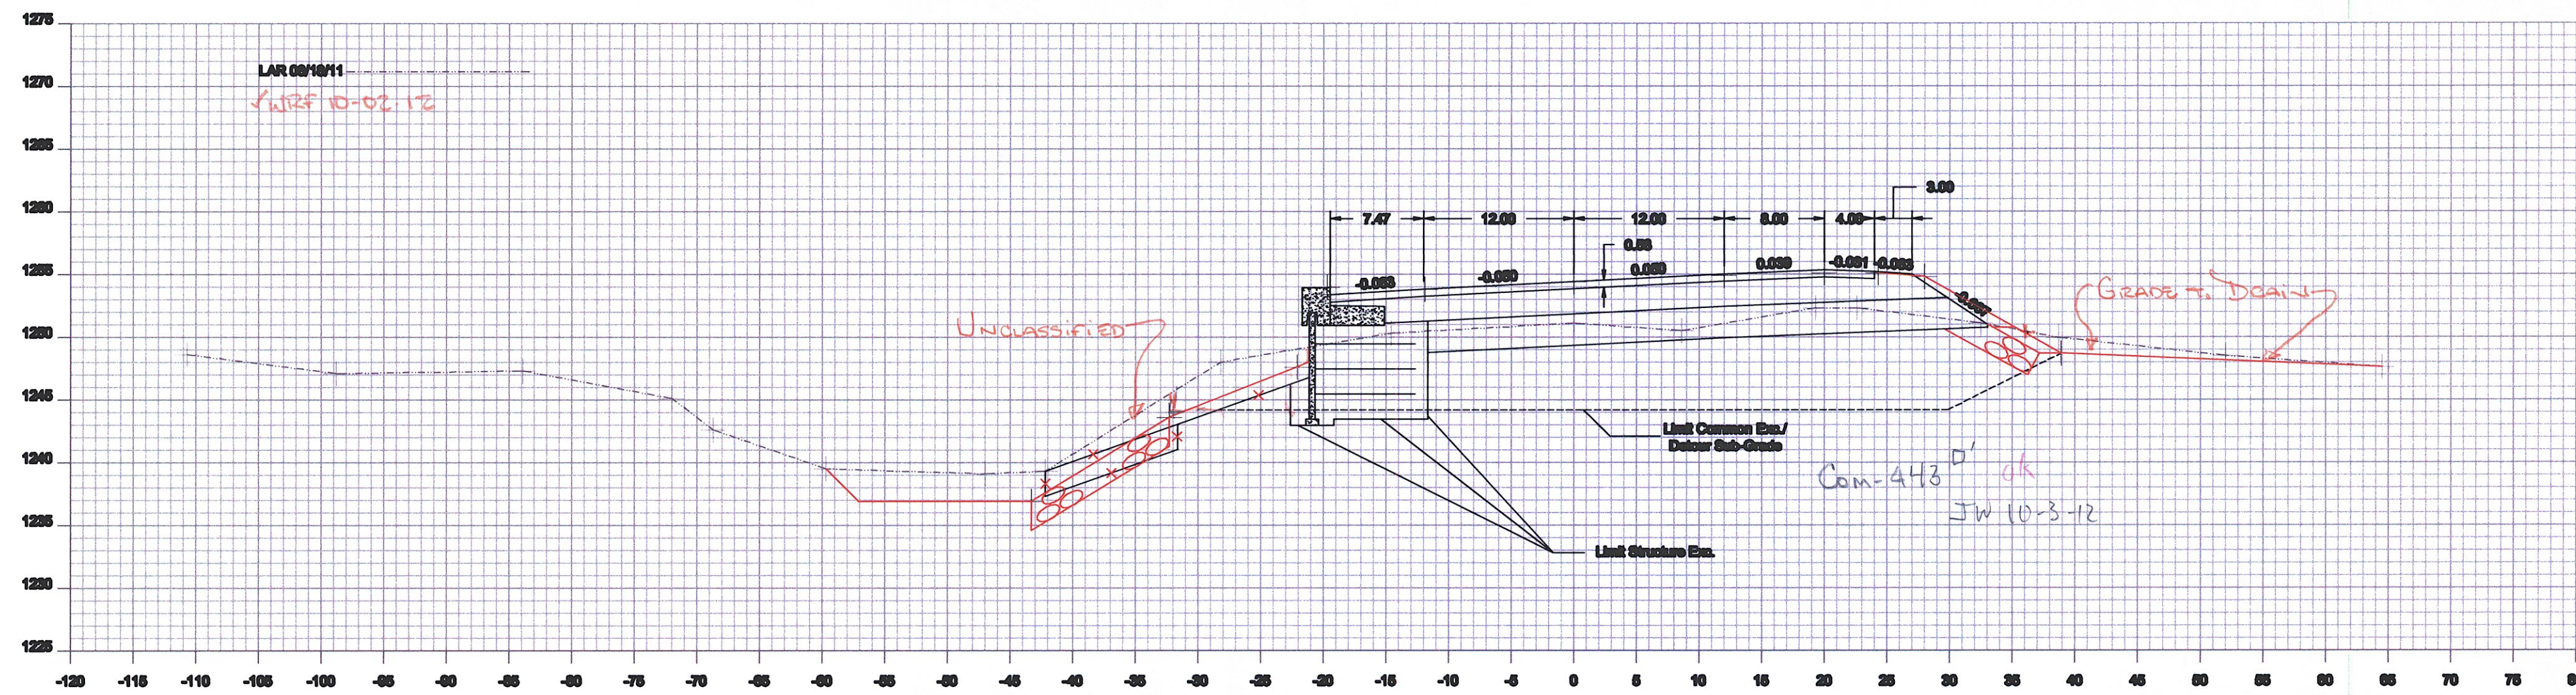

165+00

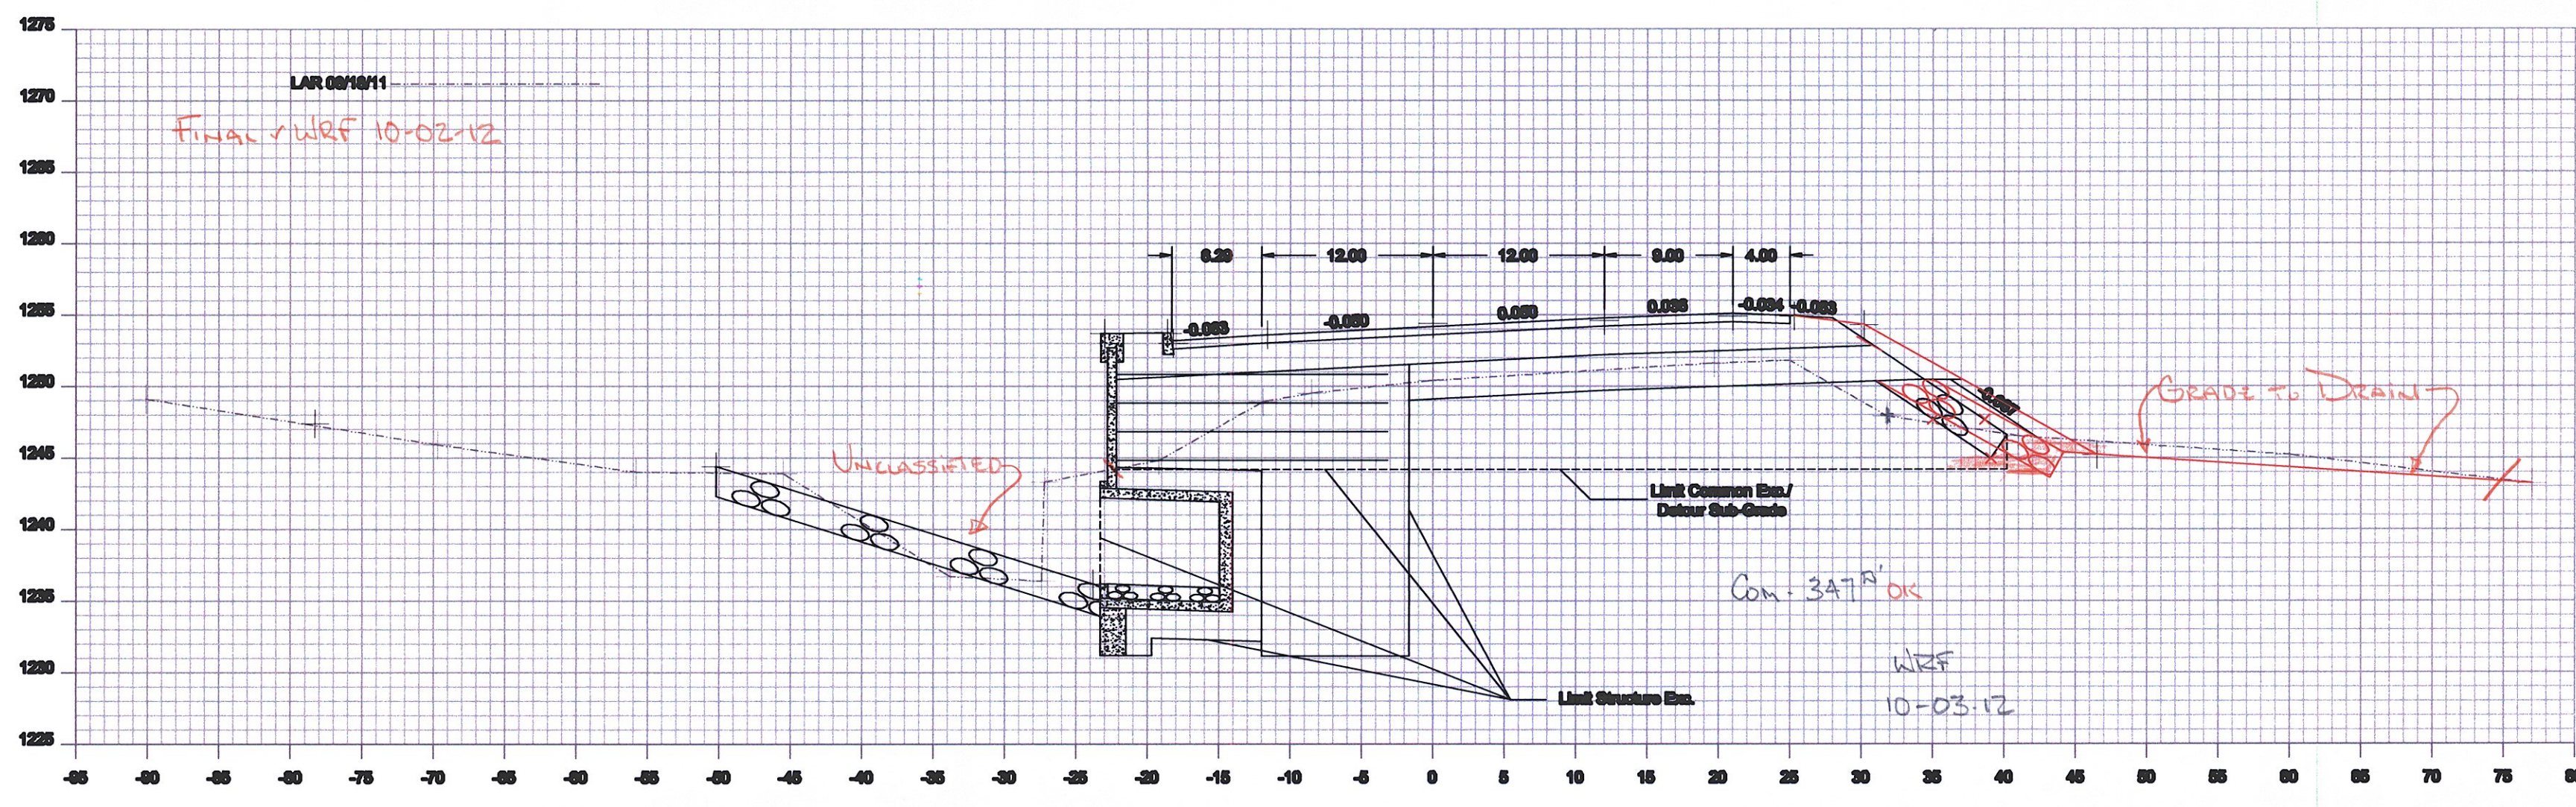

164+00

Drawing: Cross Section 164+50 - 165+50
 Project: Cabot Damville
 Drawn By: JMR
 Date: 09-26-2012
 Scale: 1:10
 Checked By:
 Date:
 Sheet: of