



168+50

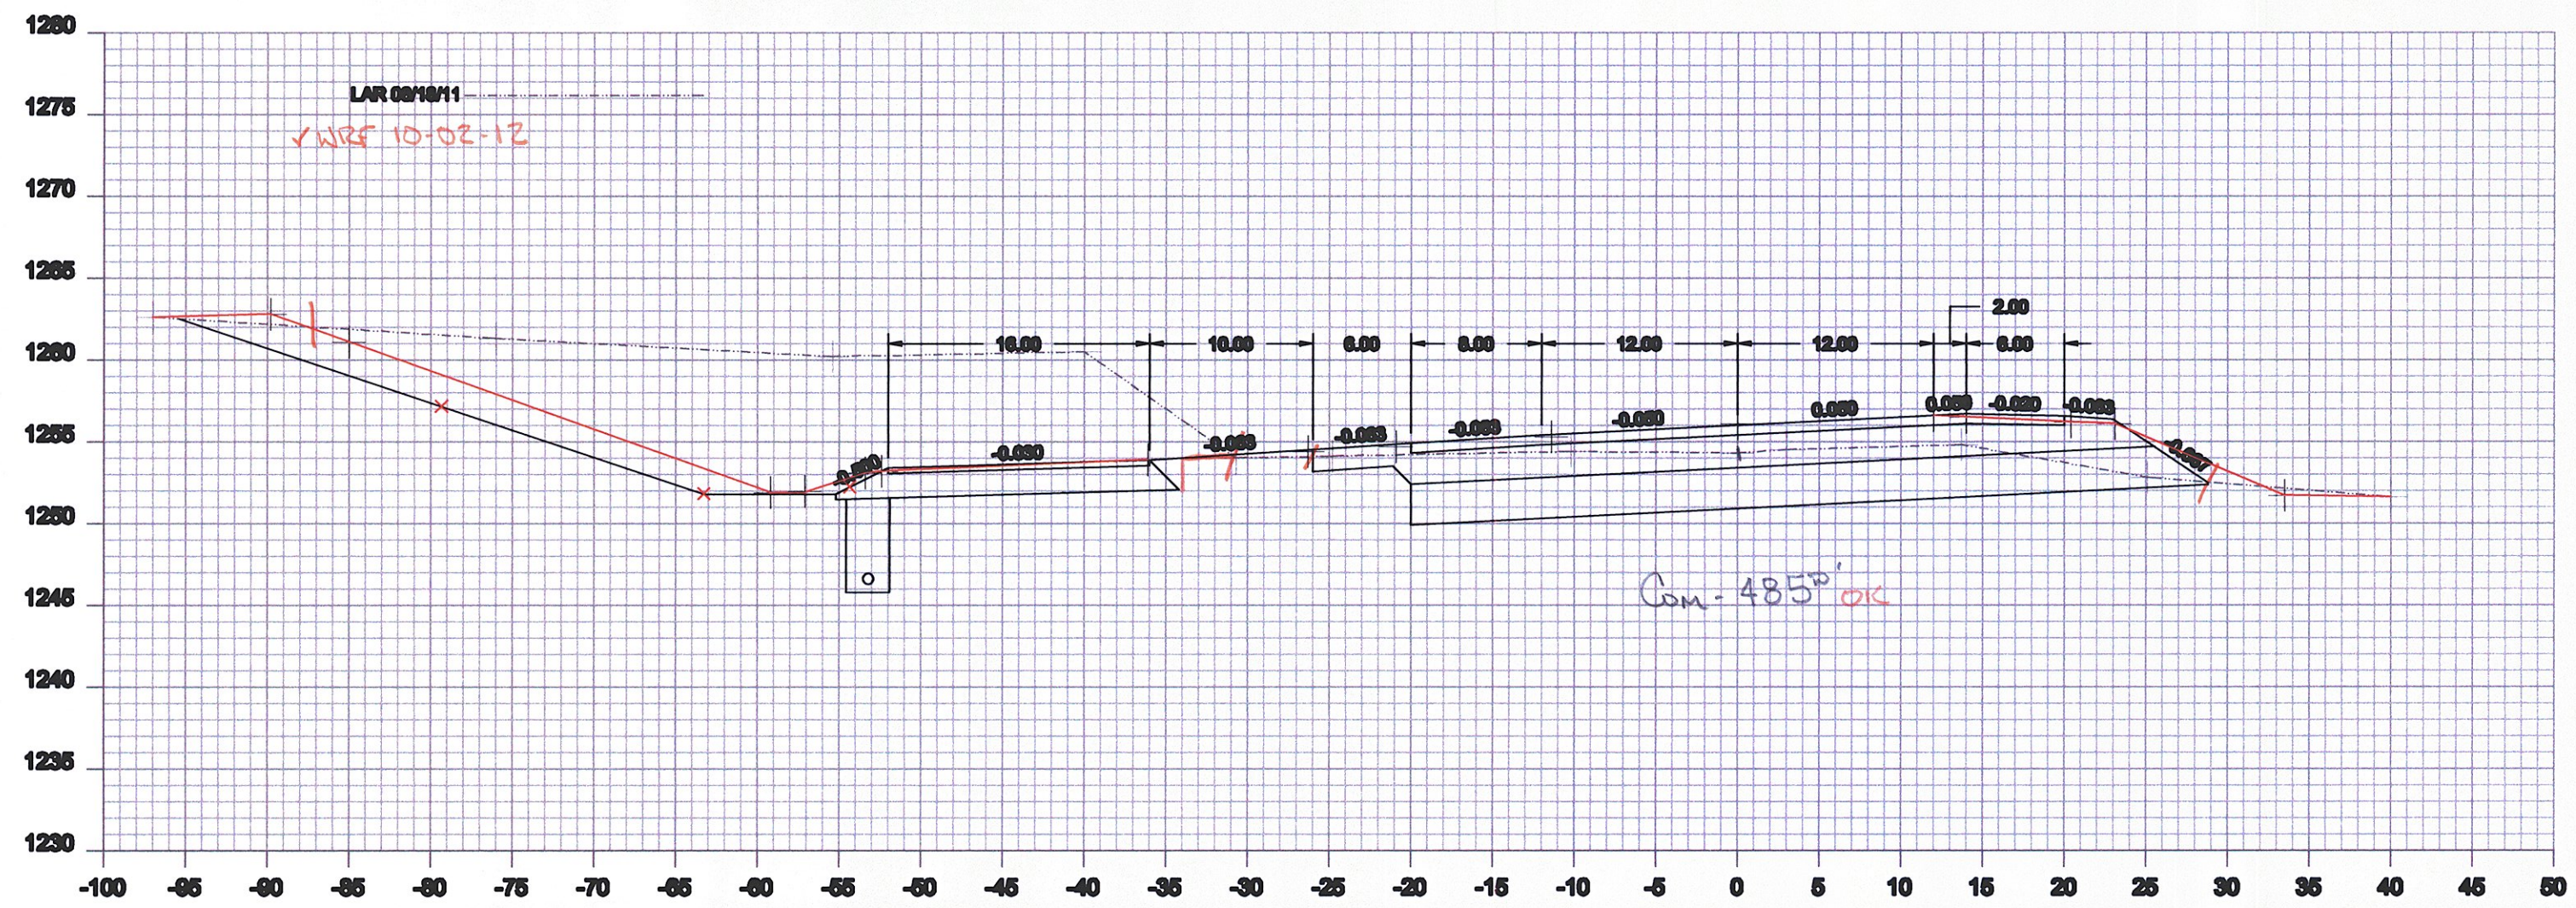

168+00

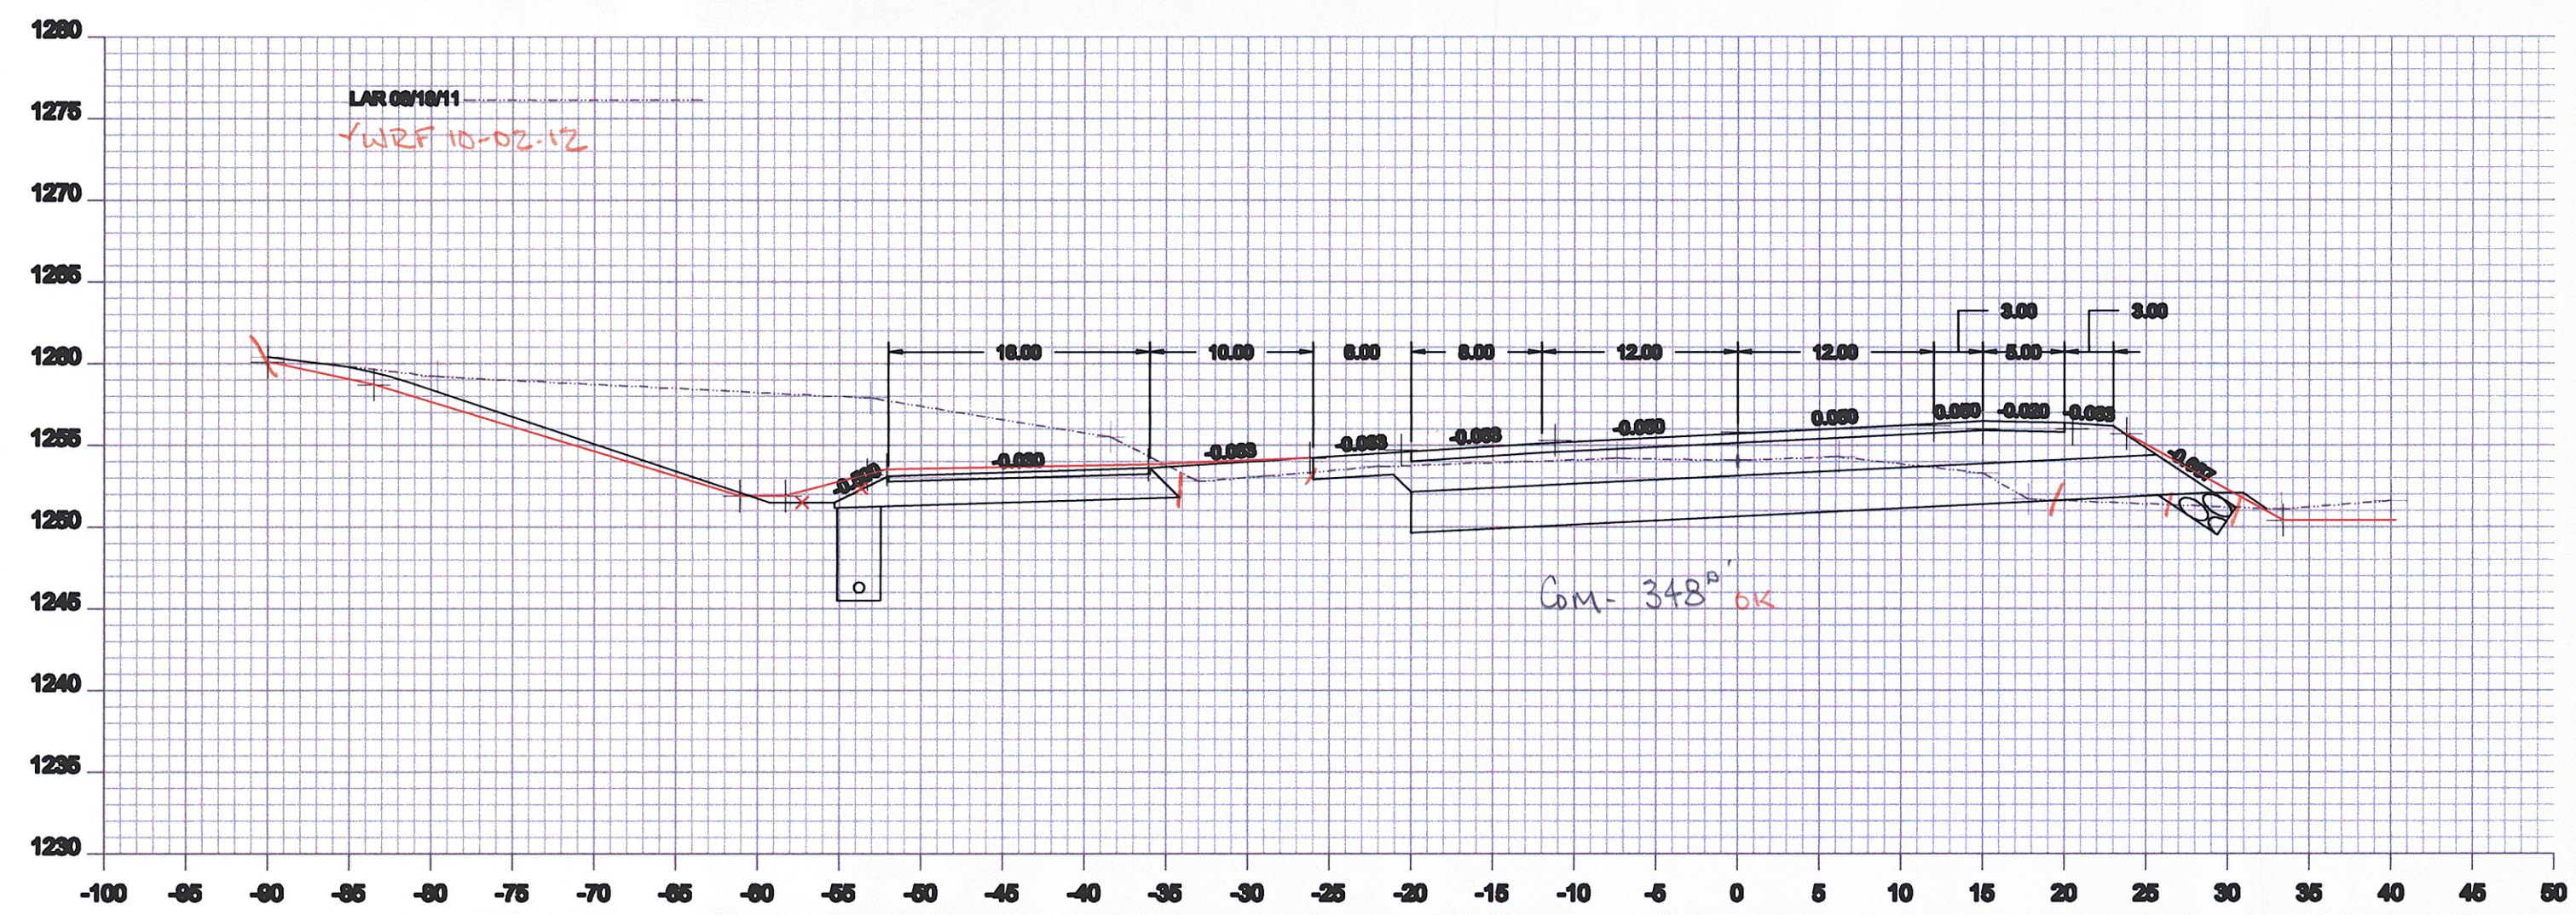

167+50

Drawing: Cross Section 167+50 - 168+50	
Project: Cabot Damville	
Drawn By: JMR	Checked By:
Date: 09-26-2012	Date:
Scale: 1 : 10	Sheet: of