


169+50

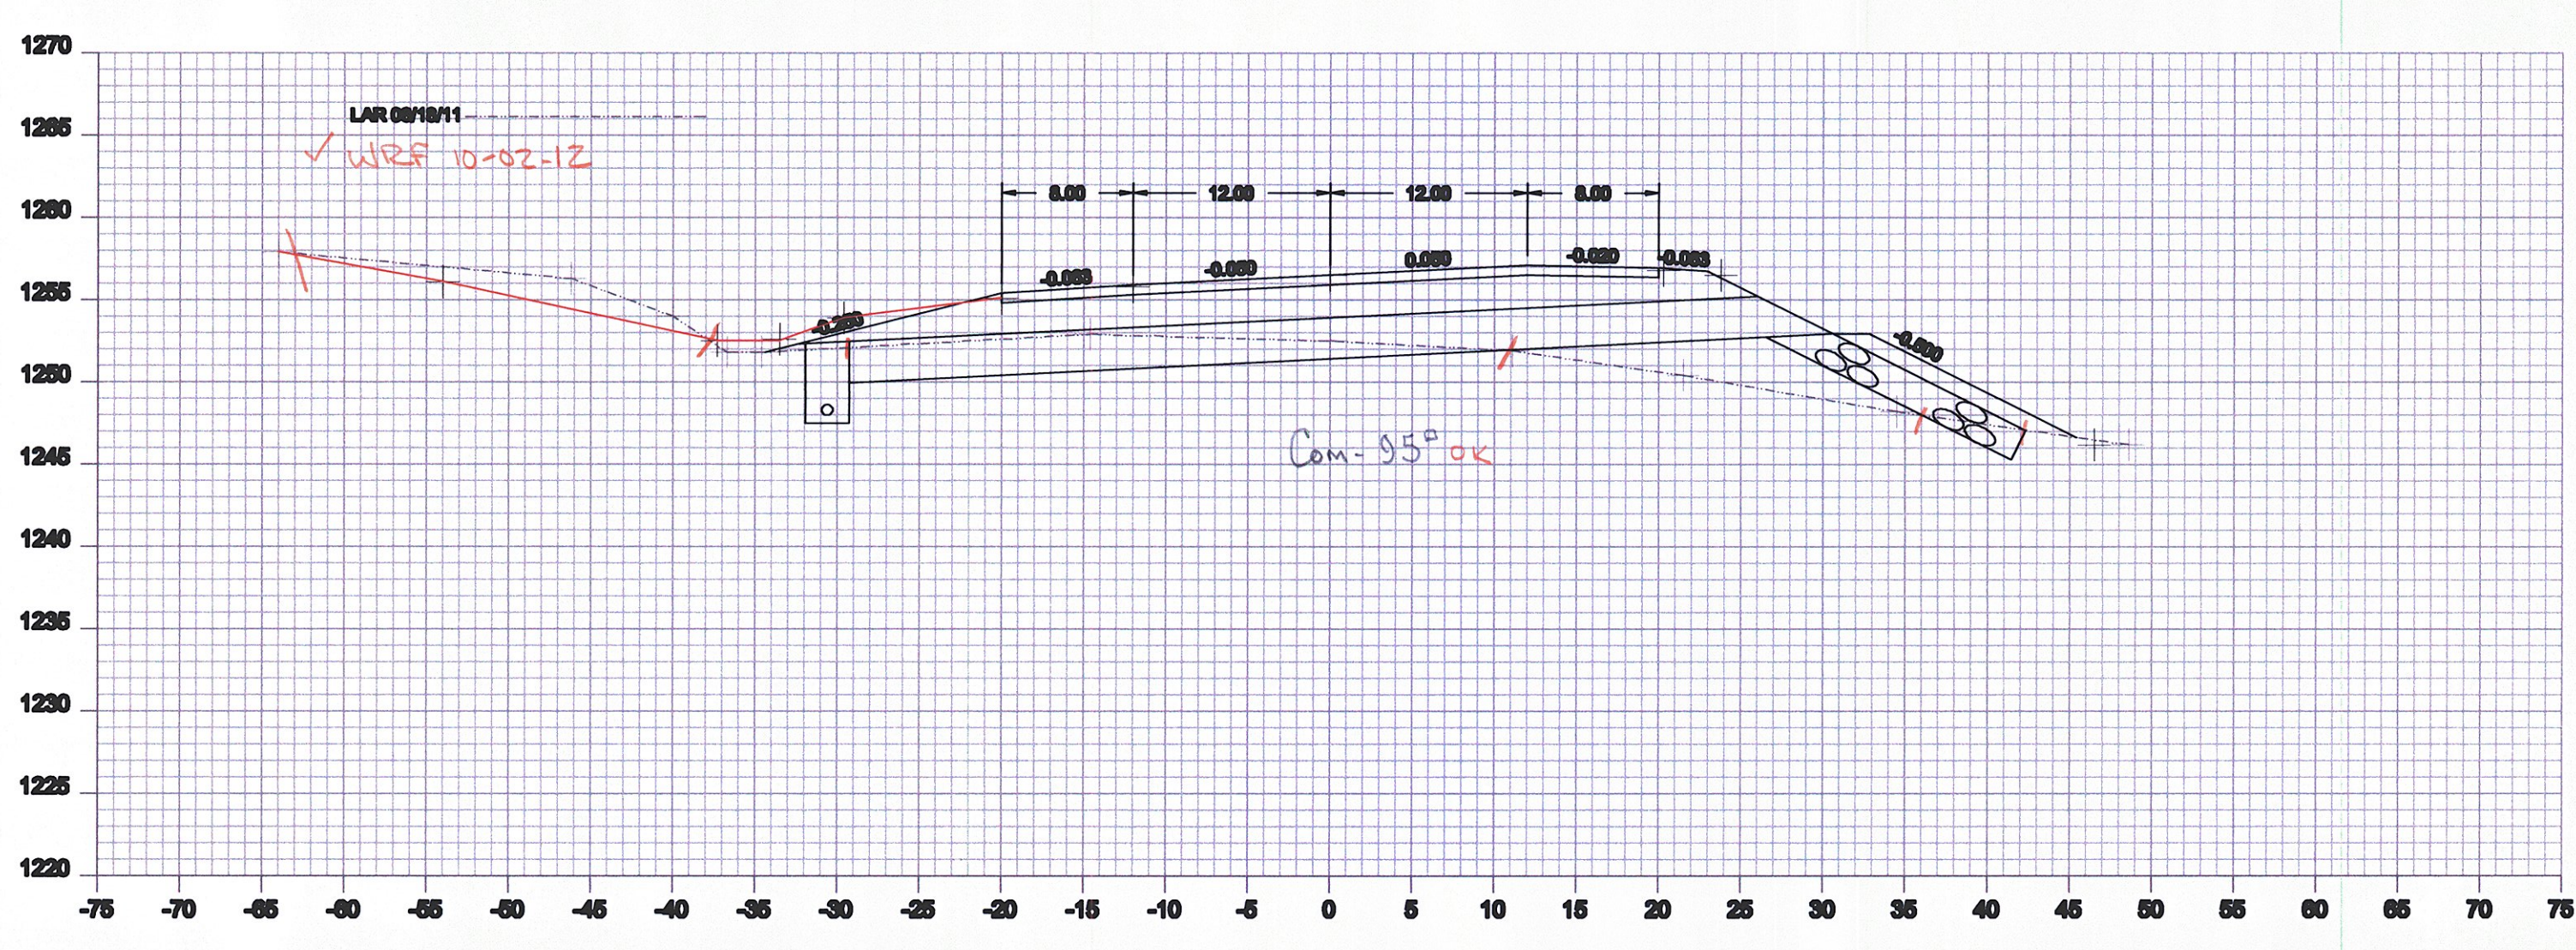

169+00