



171+00

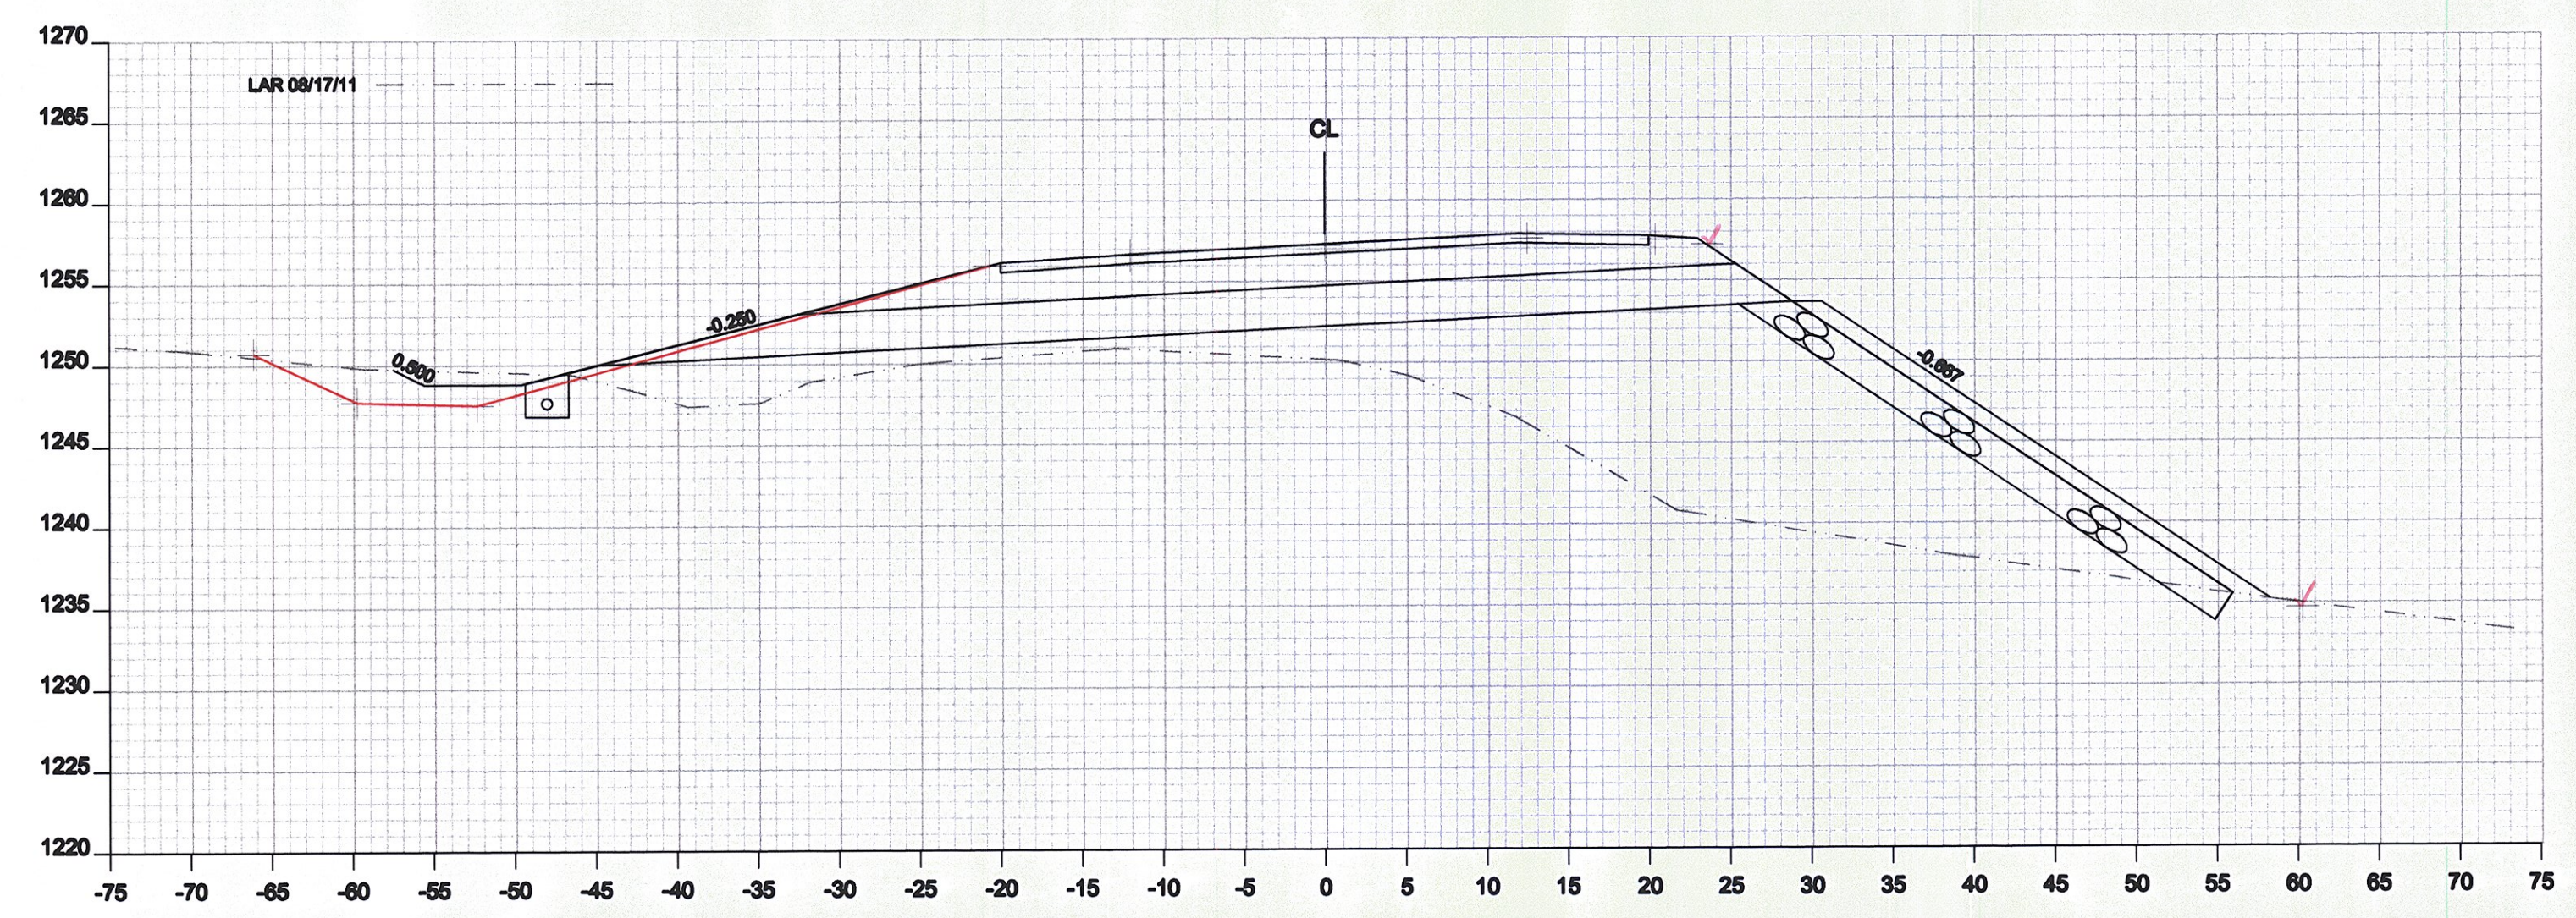

170+50

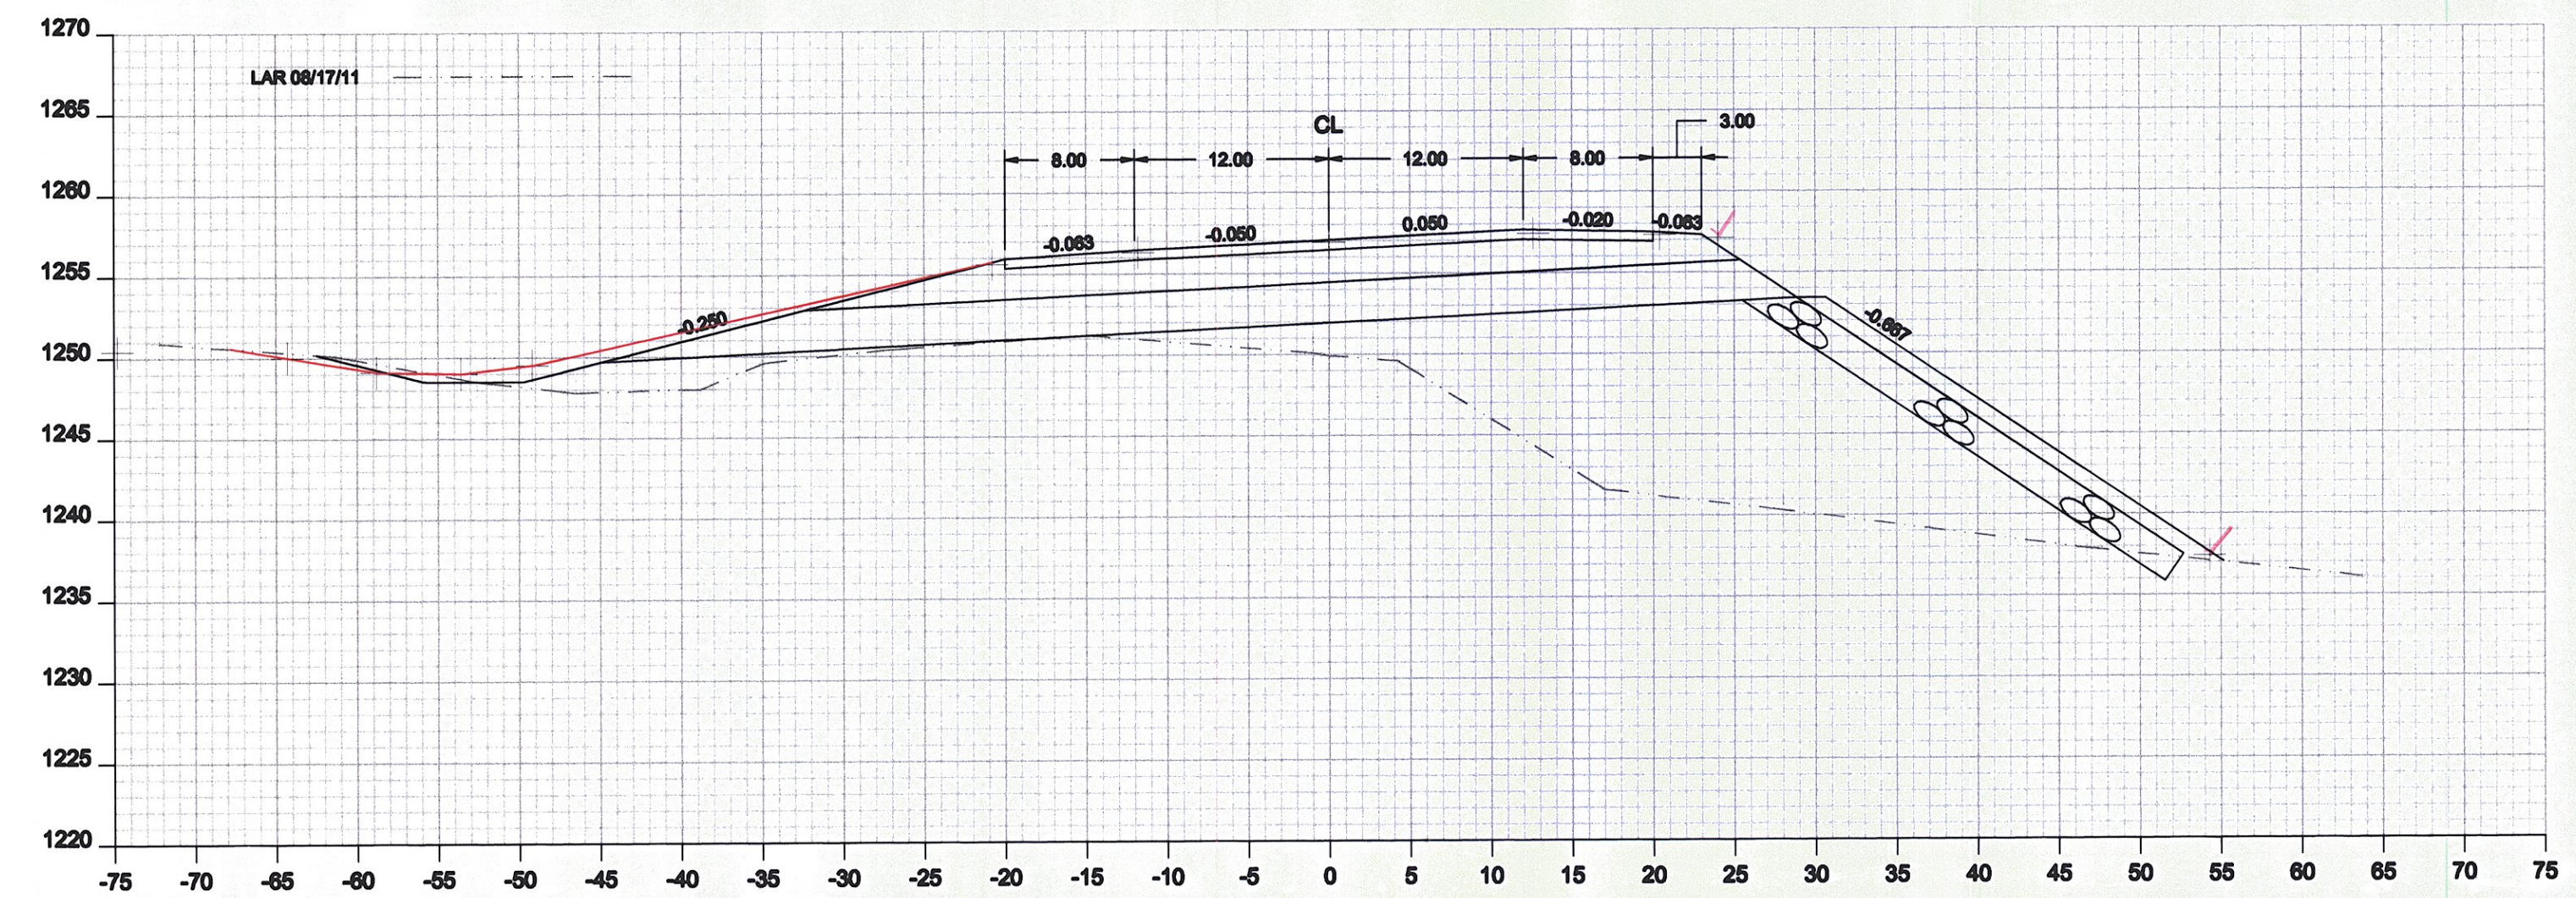

170+00

✓ from 205 12-19-11  
 ✓ Area 205 12-21-11