



172+50

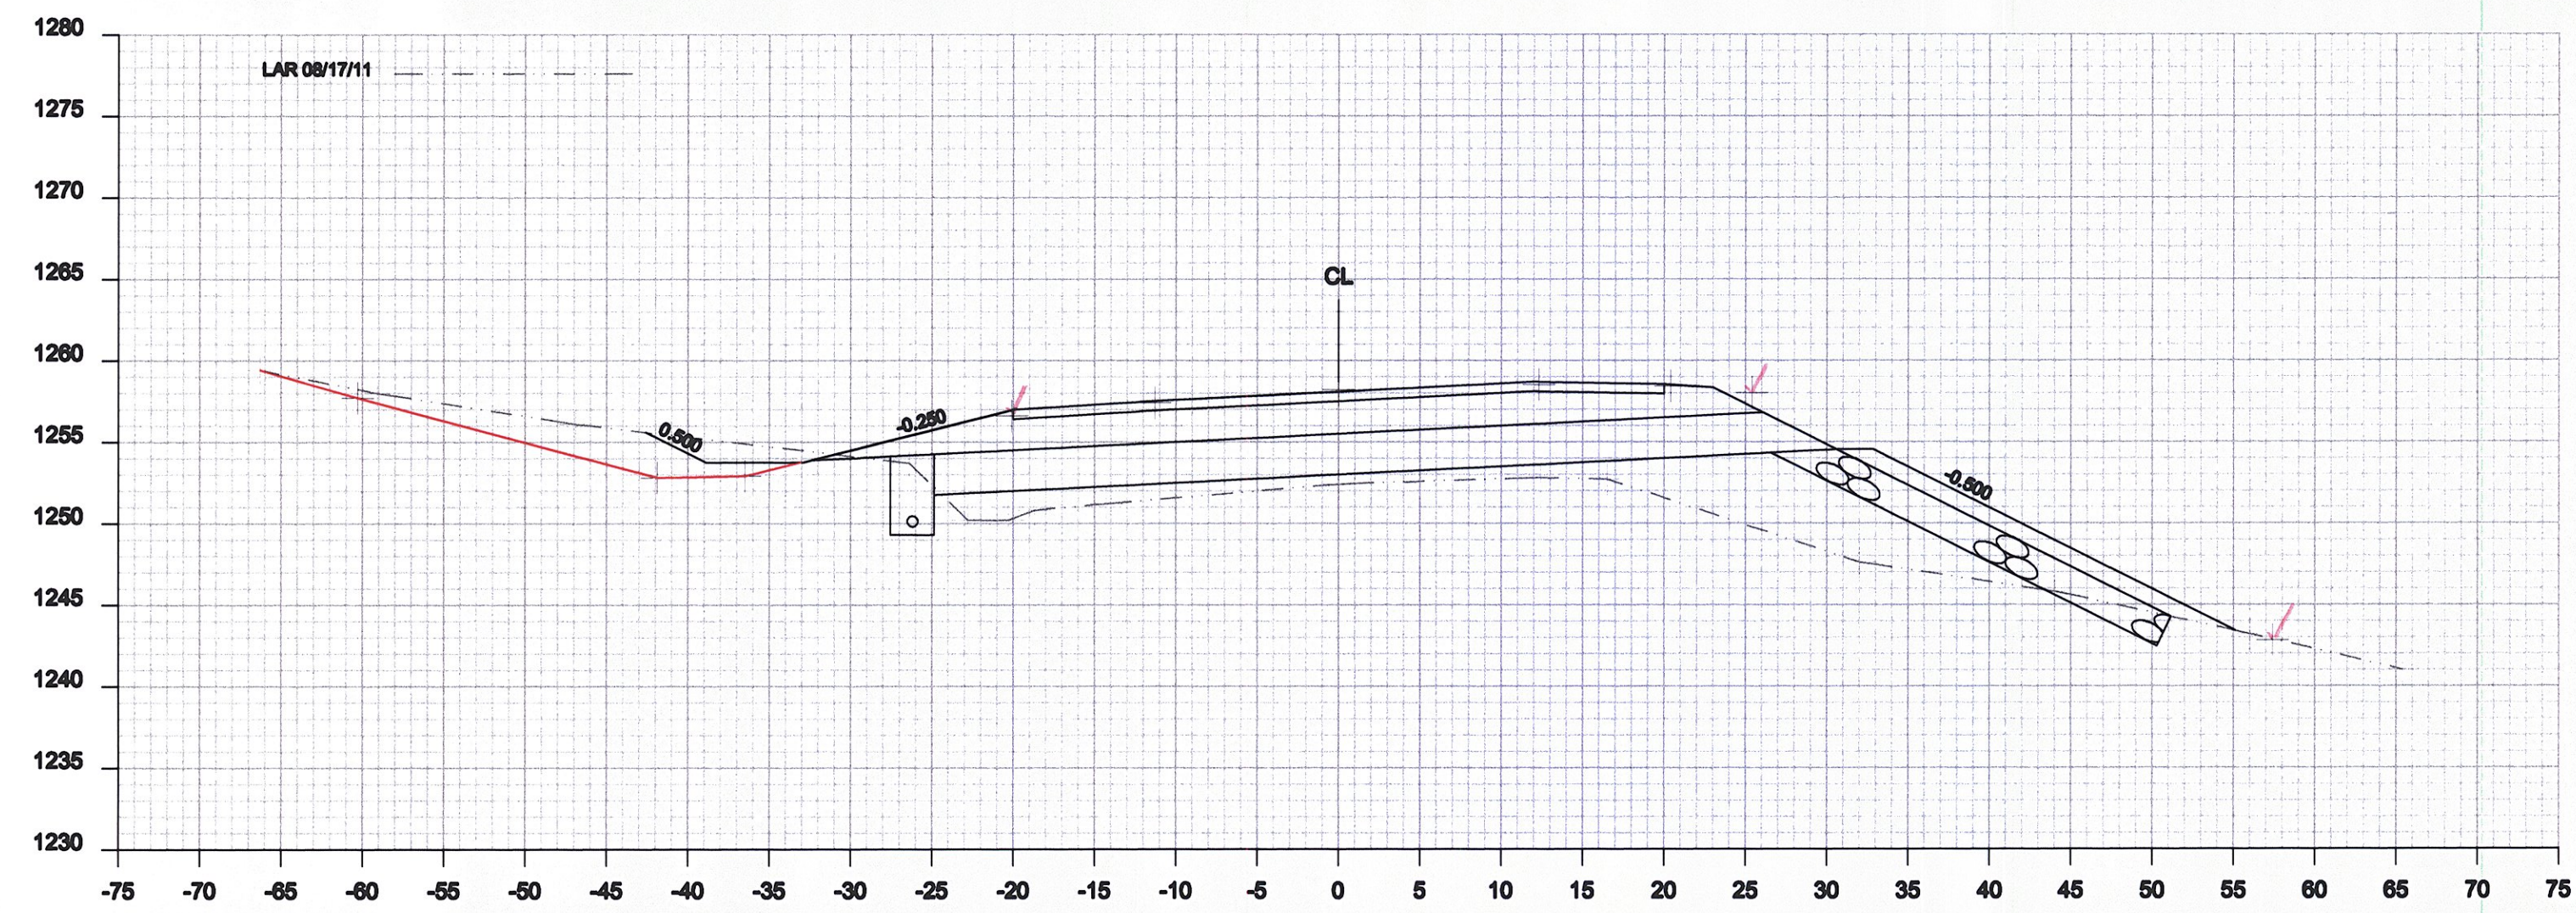

172+00

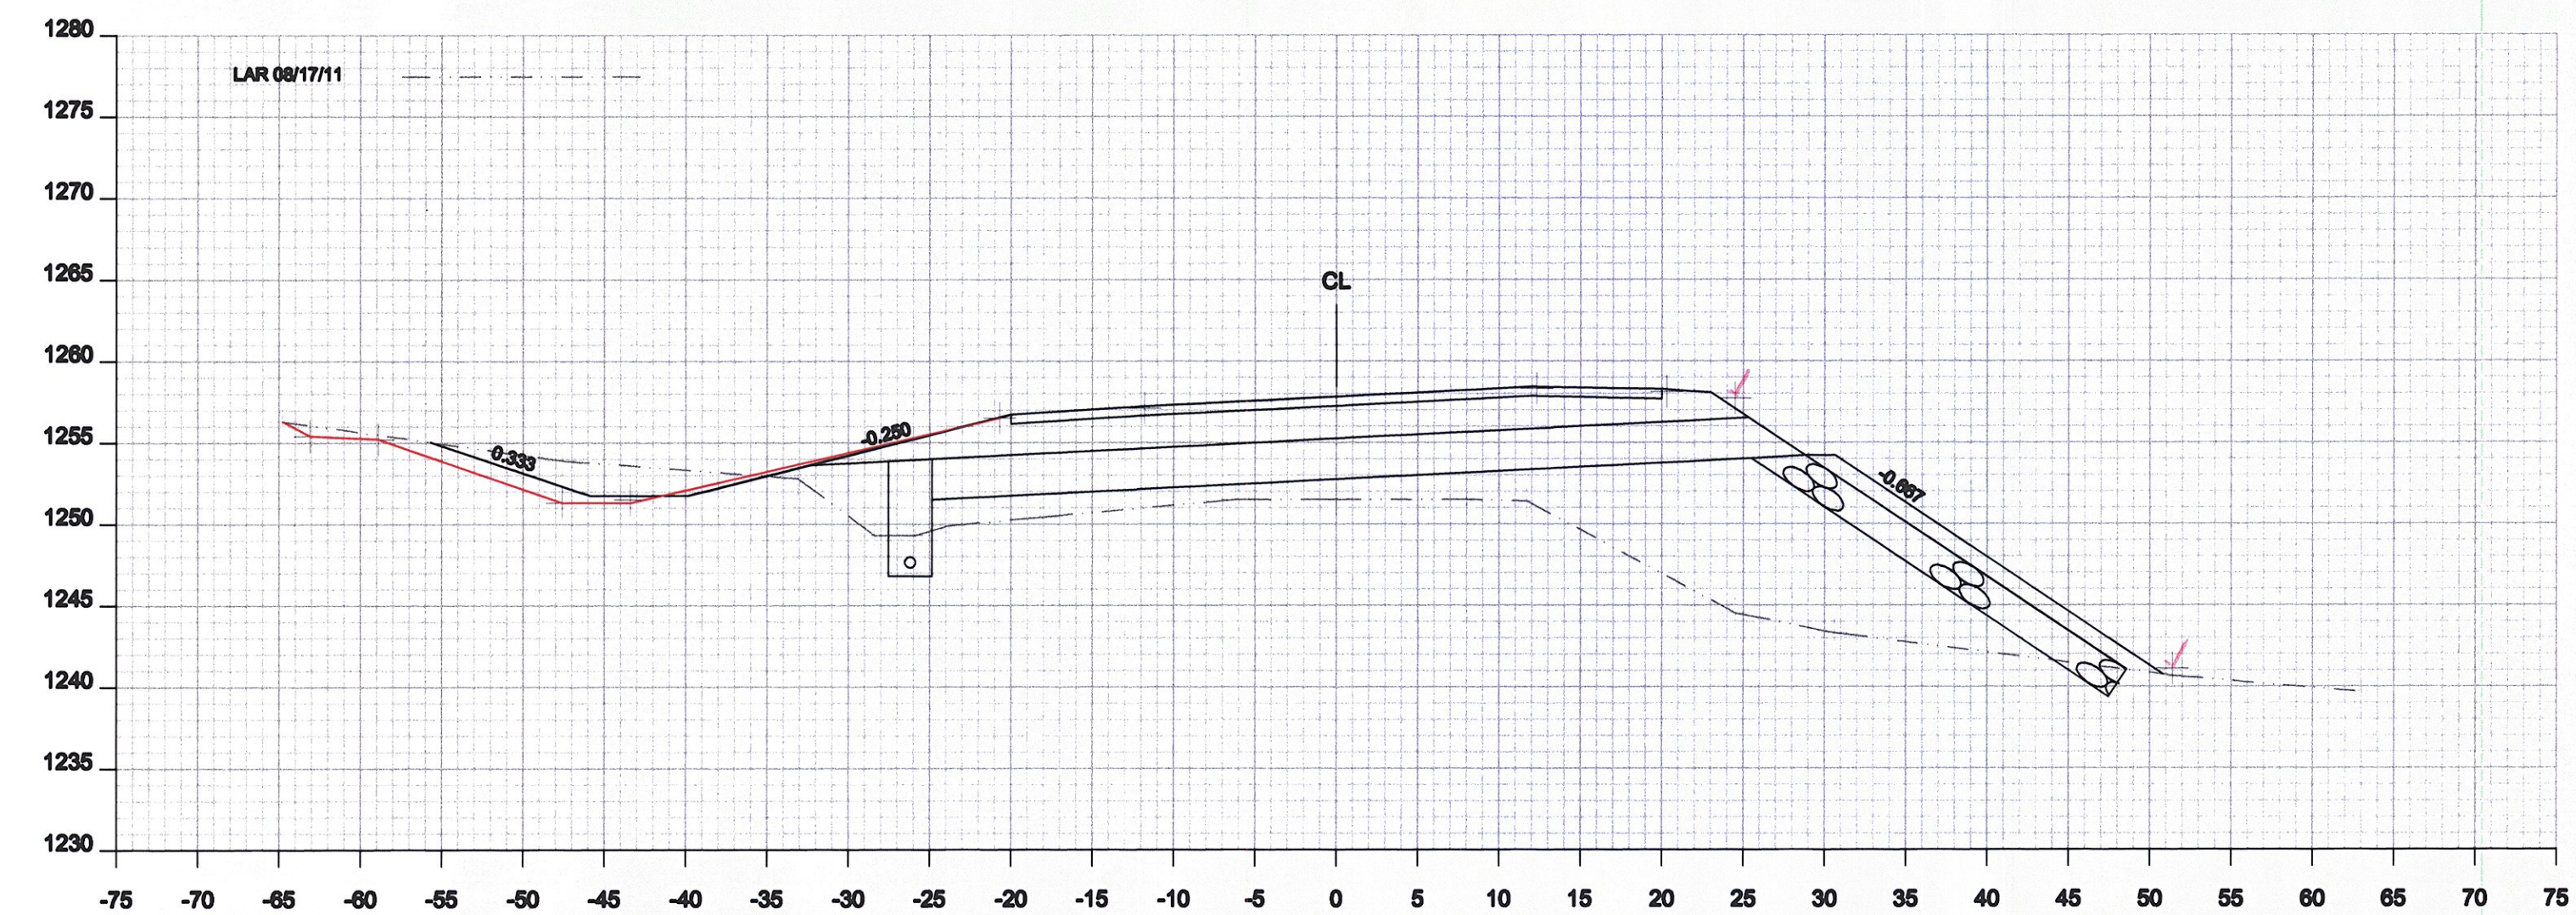

171+50

✓ Pct 12-19-11
 ✓ Area 12-21-11