



174+00

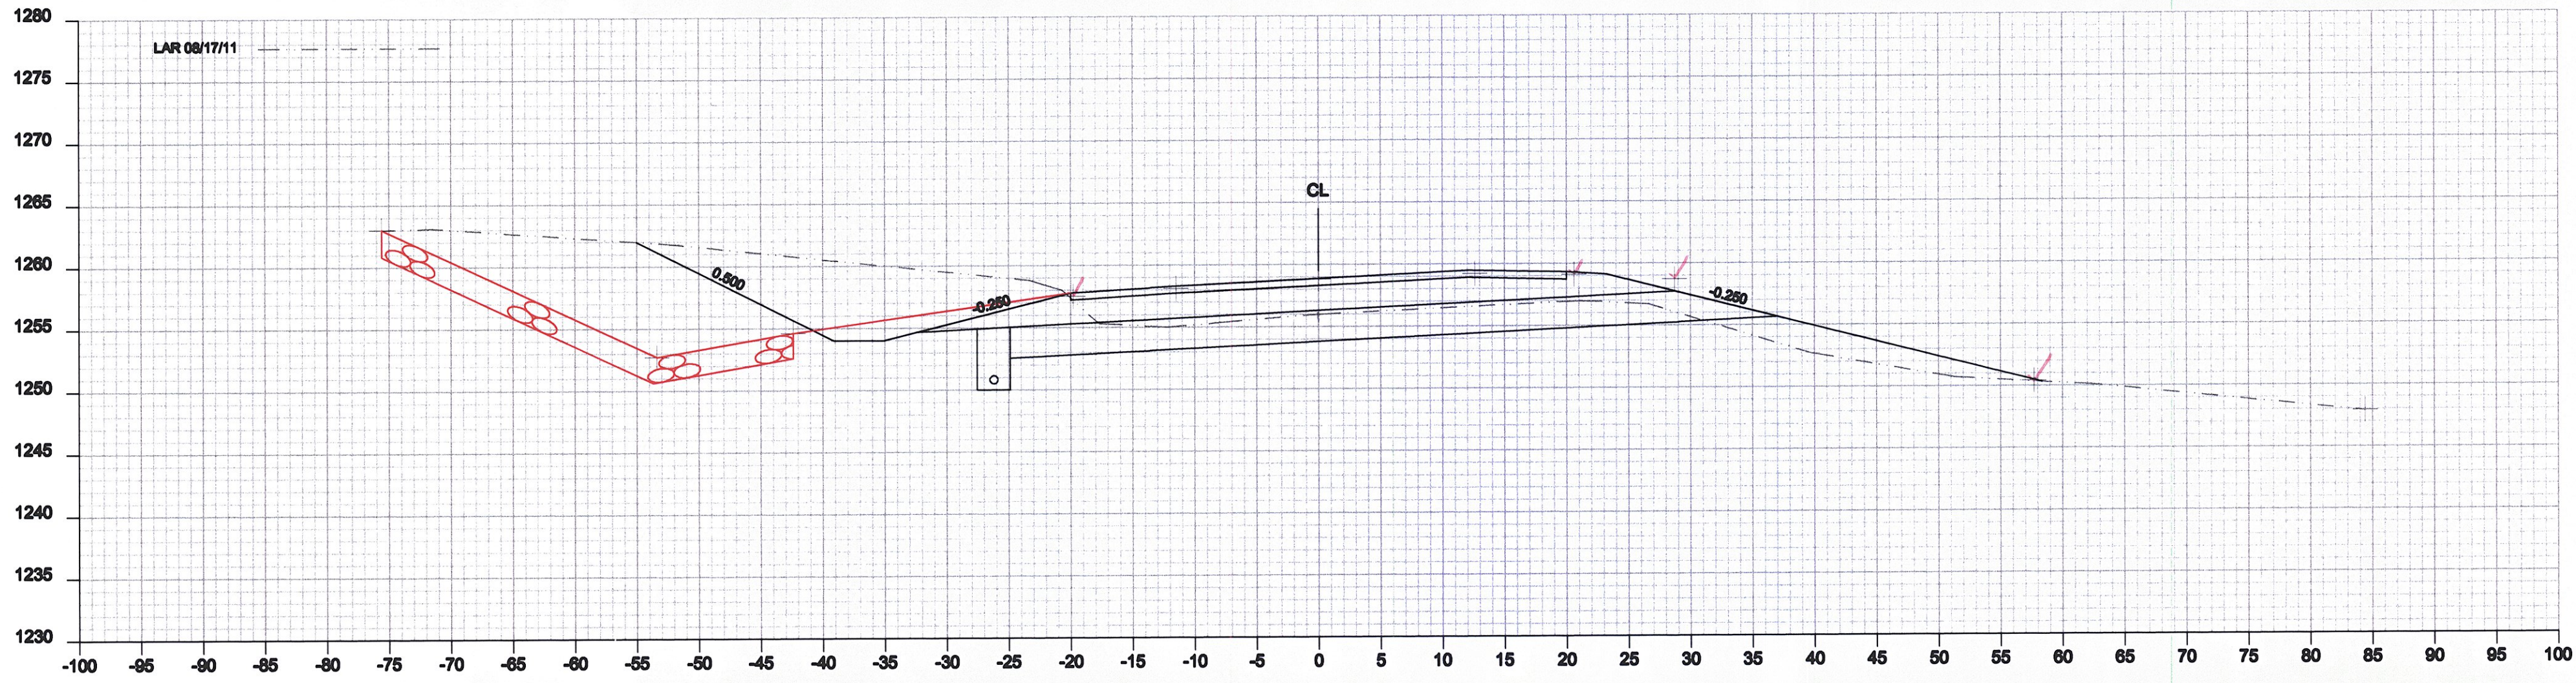

173+50

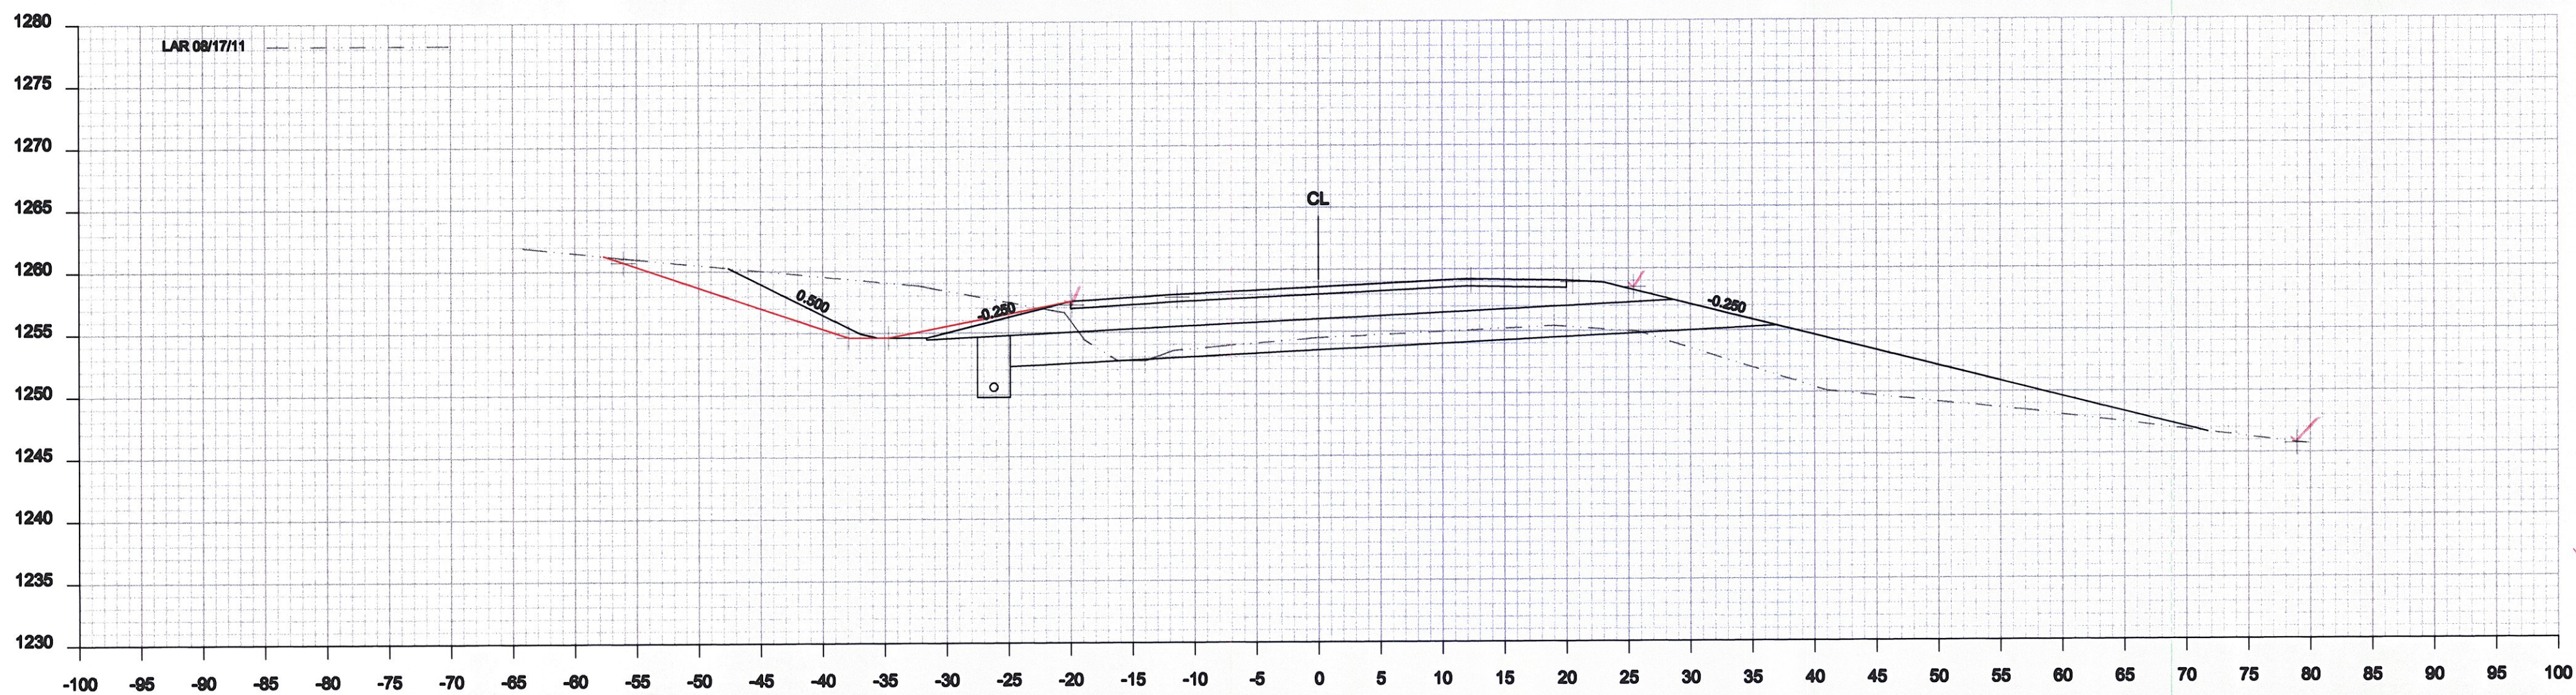

173+00

✓ P07 12-19 11  
✓ Area 12 21-11

Drawing: Cross Section 173+00 - 174+00	
Project: Cabot Danville	
Drawn By: JMR	Checked By:
Date: 12-16-2011	Date:
Scale: 1:10	Sheet: of