



175+50

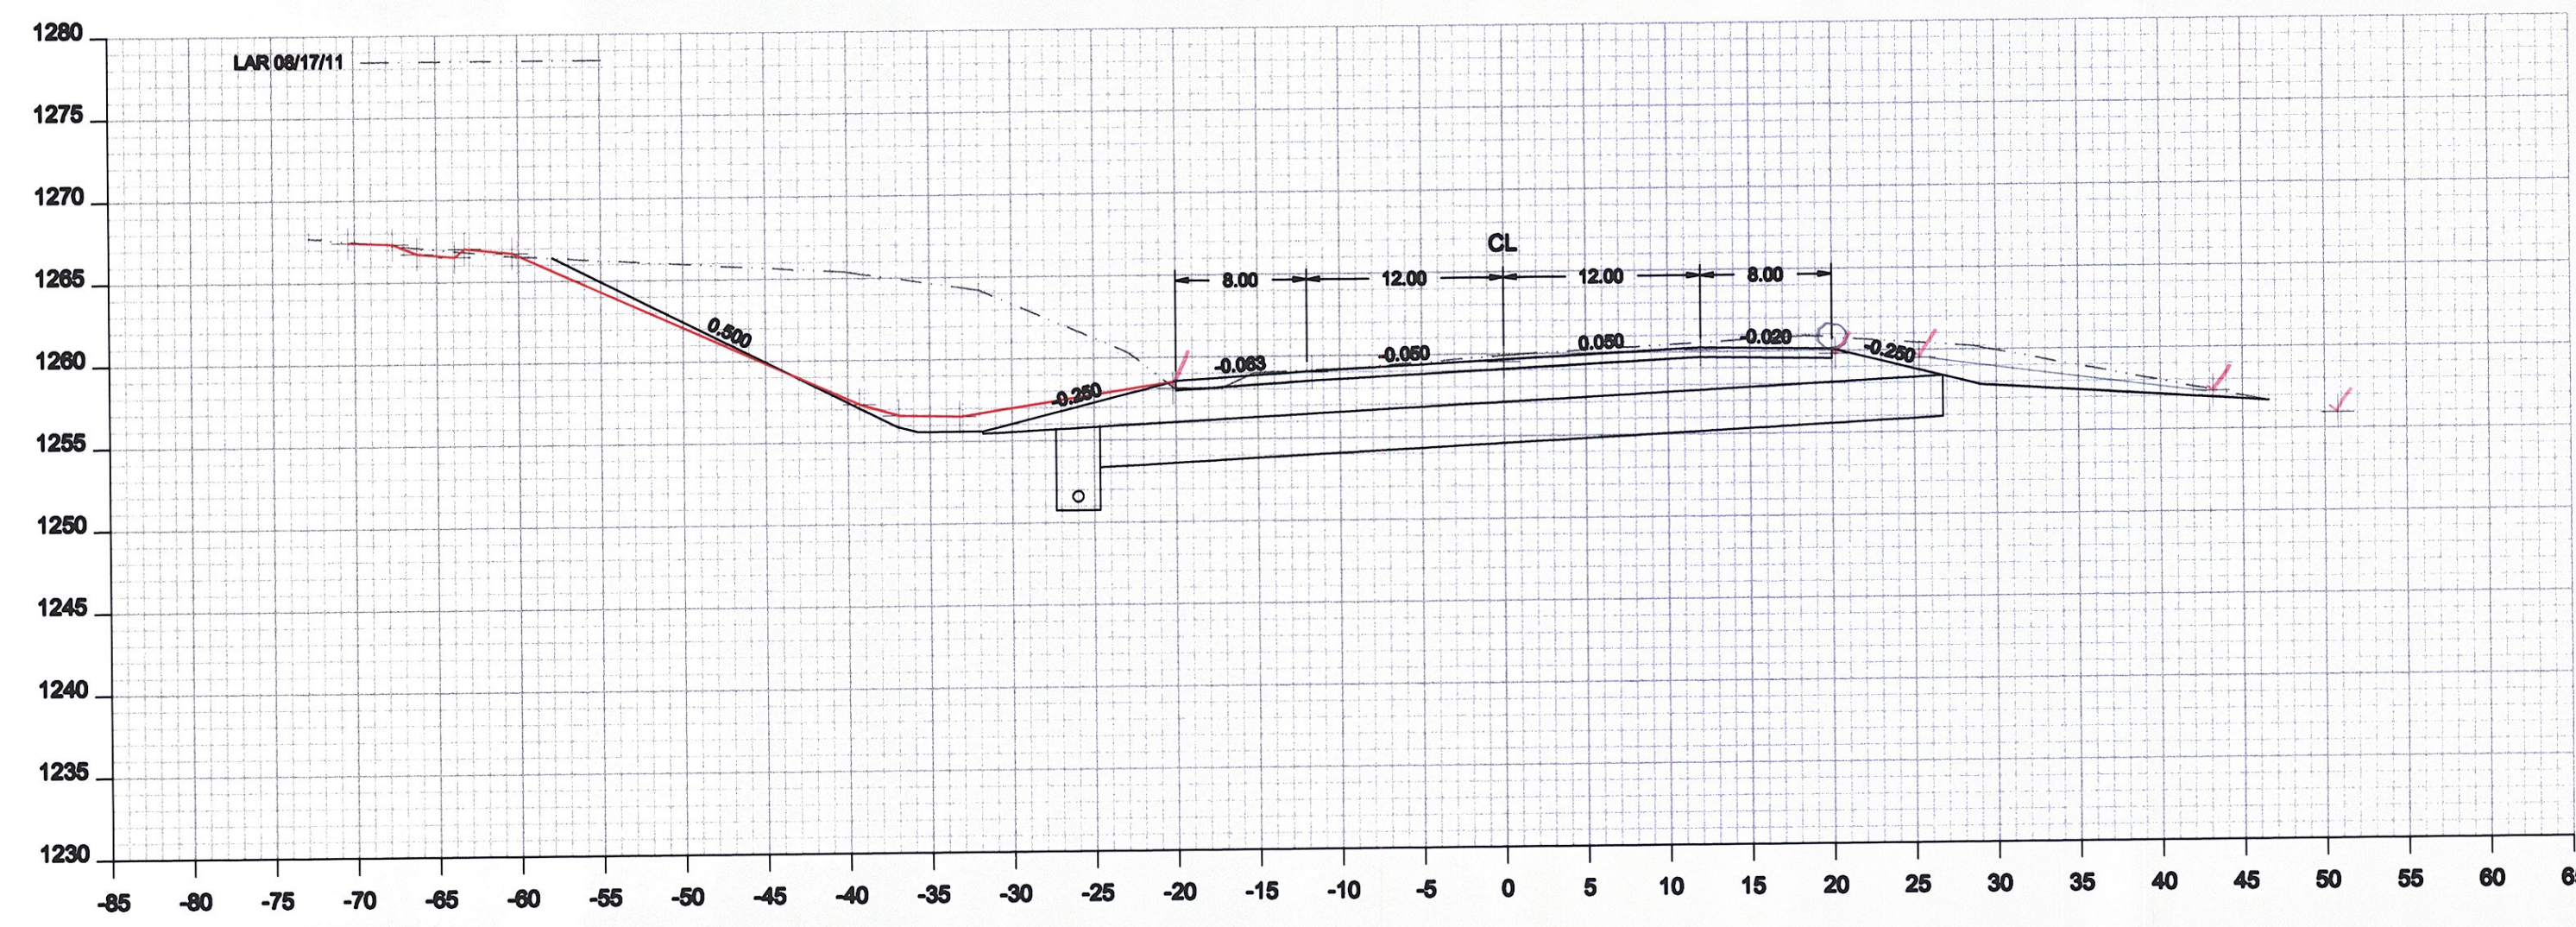

175+00

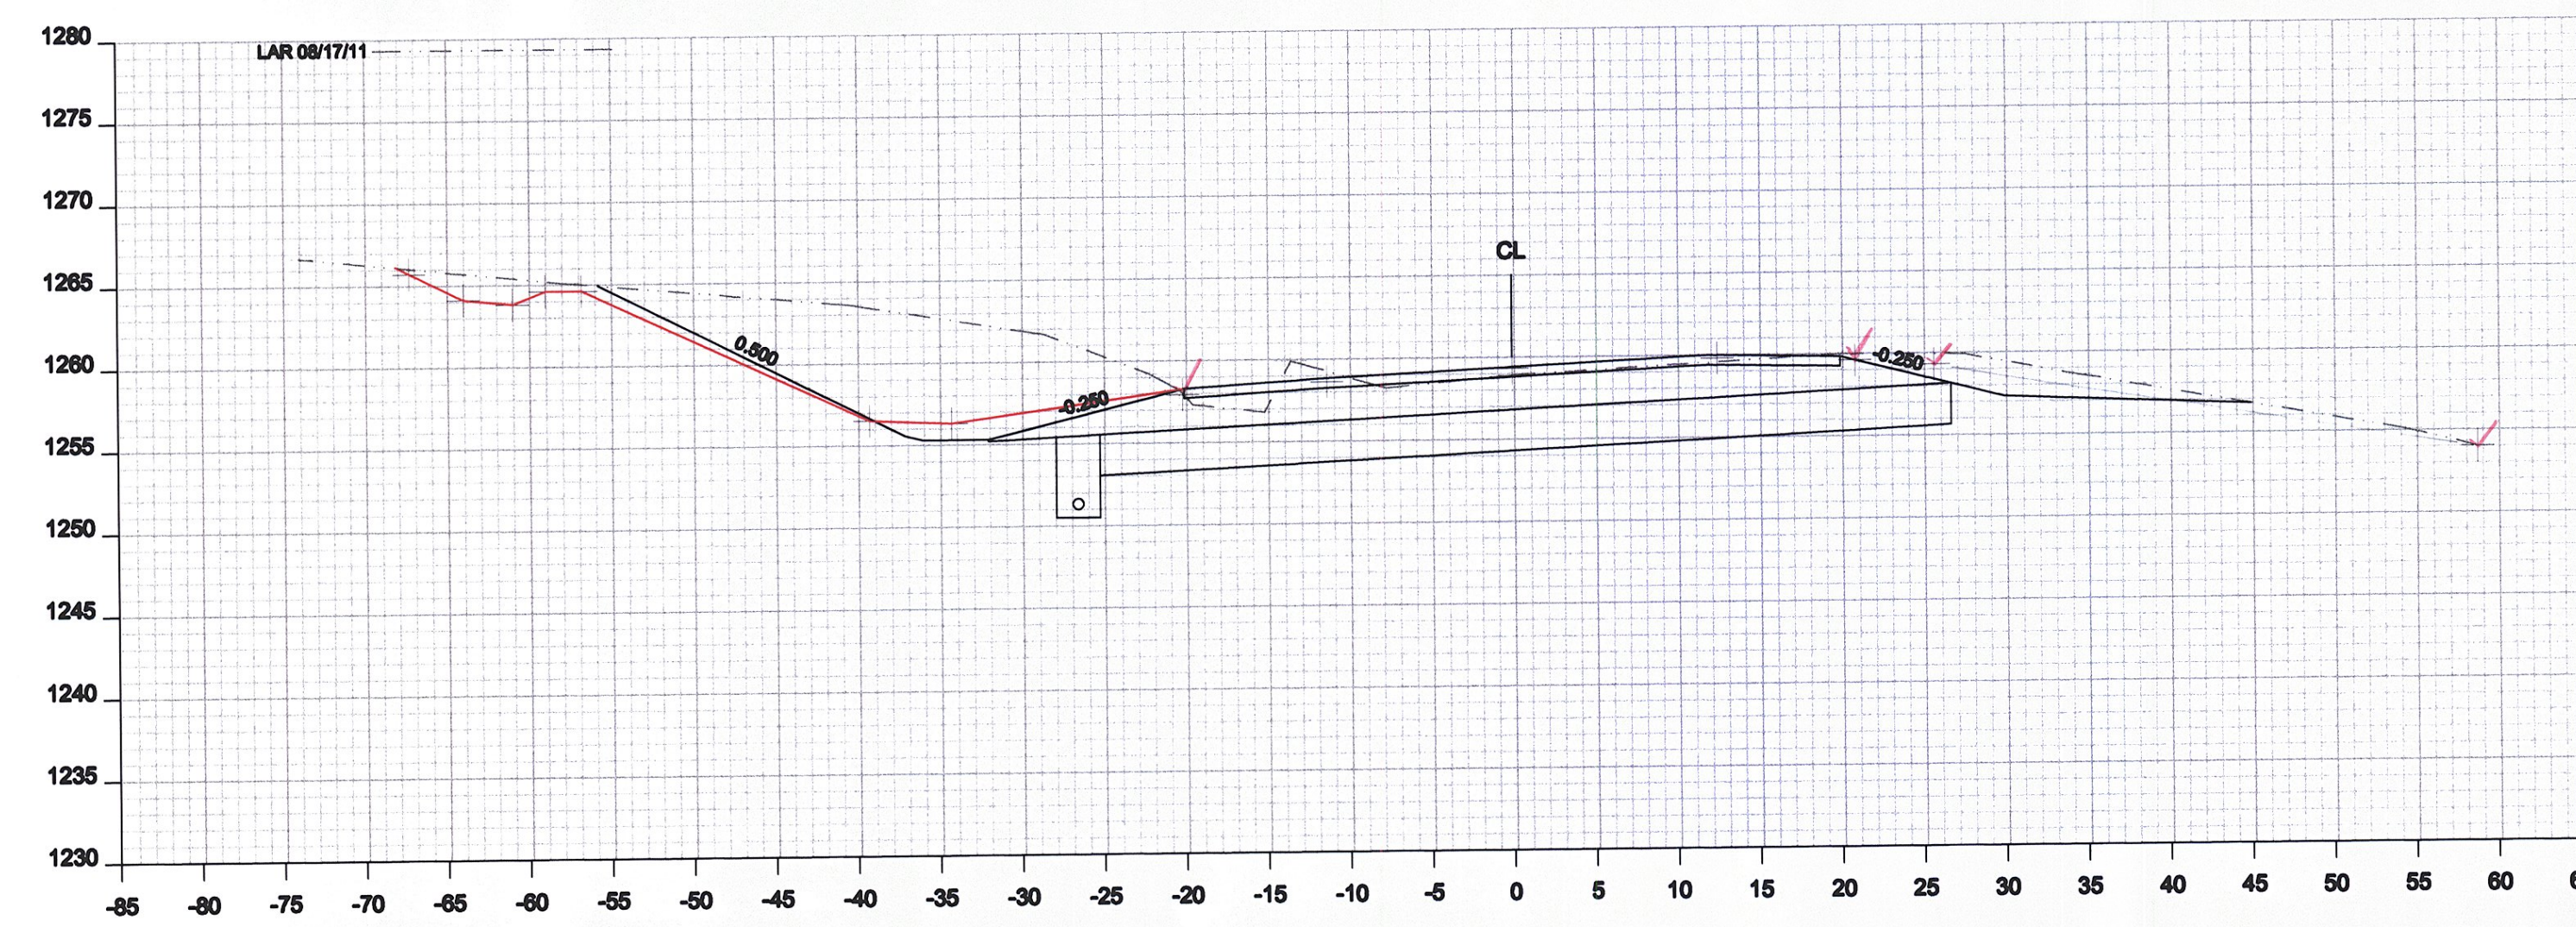

174+50

✓ Plan W&E 12-19-11
 ✓ Area W&E 12-21-11

Drawing: Cross Section 174+50 - 175+50	
Project: Cabot Damville	
Drawn By: JMR	Checked By:
Date: 12-16-2011	Date:
Scale: 1 : 10	Sheet: of