



177+00

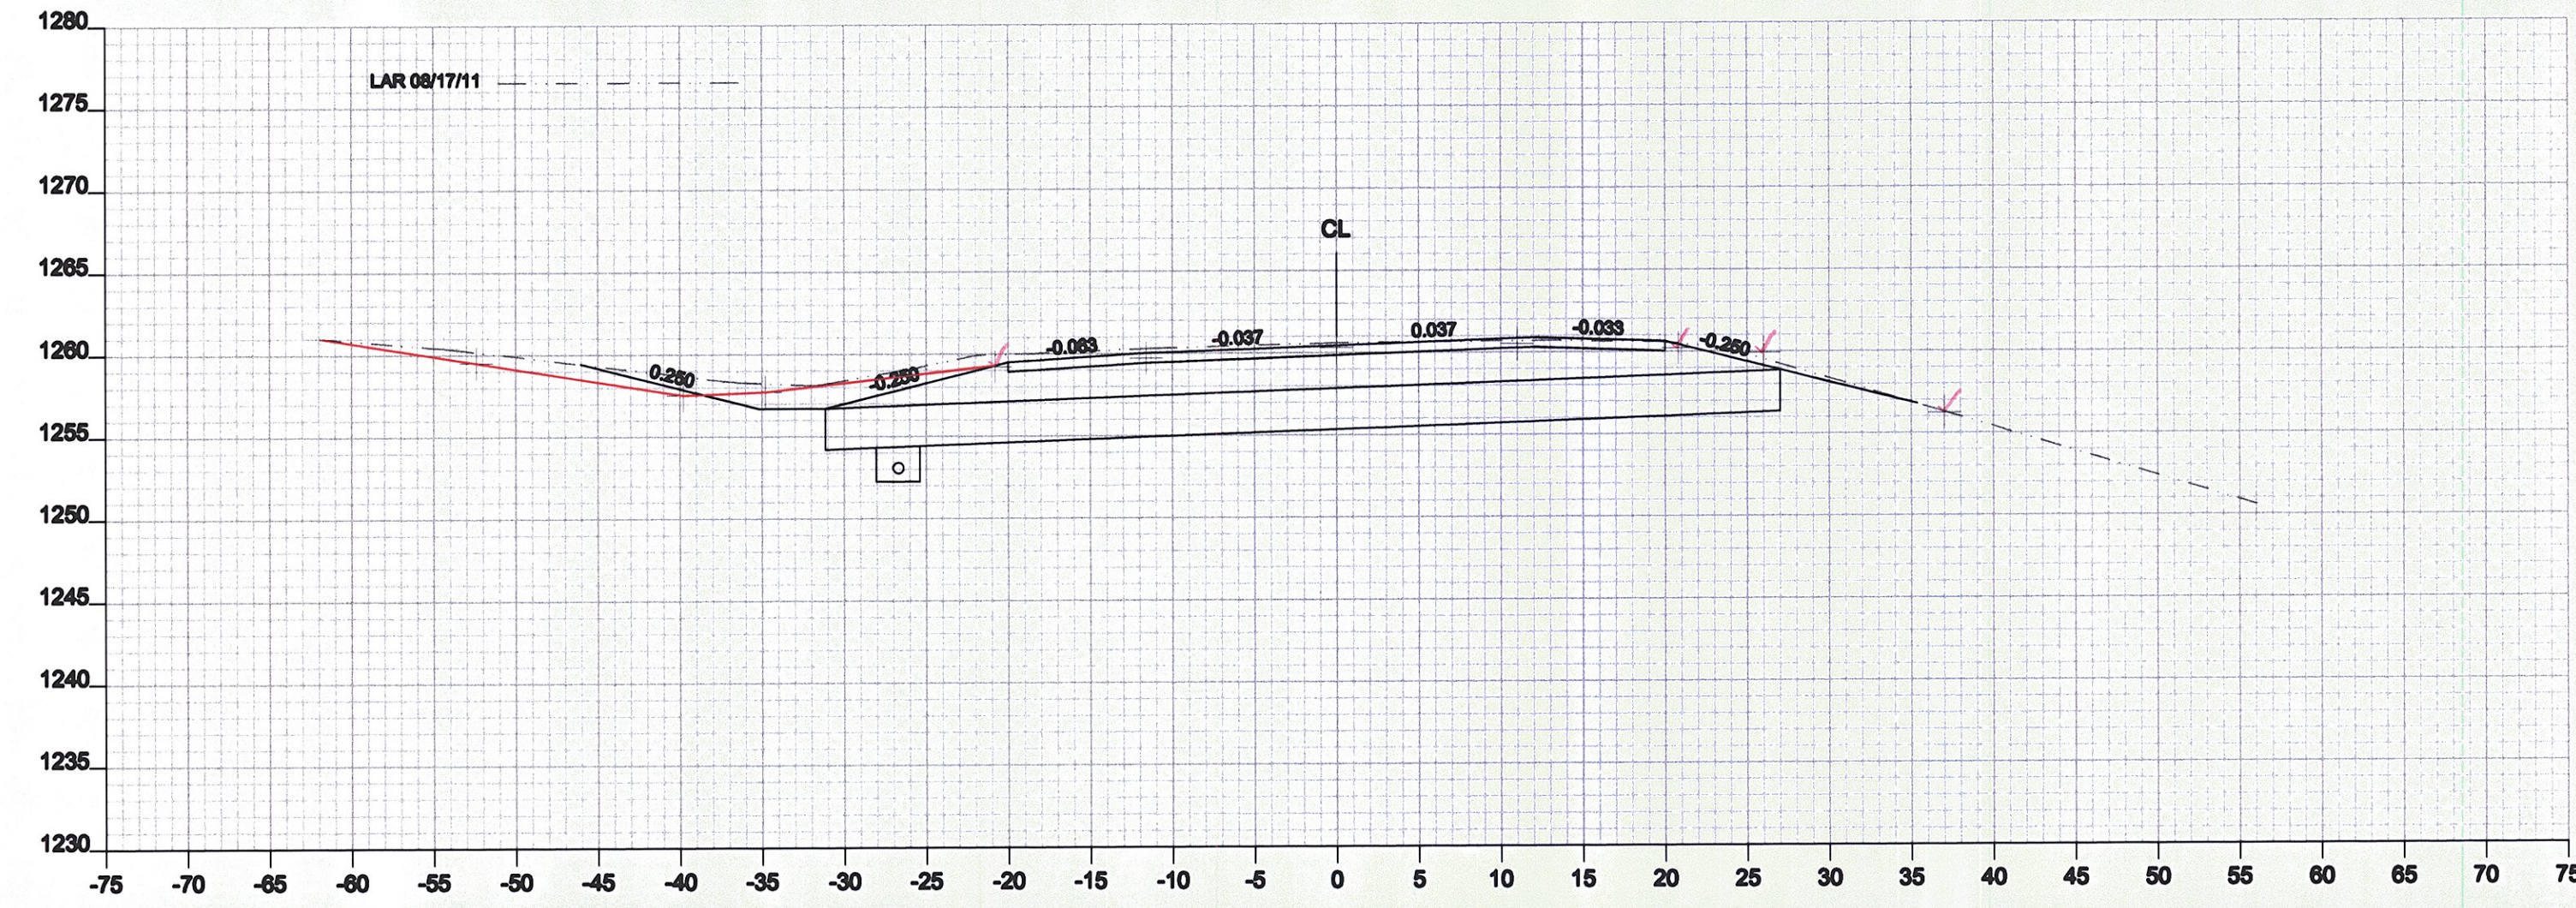

176+50

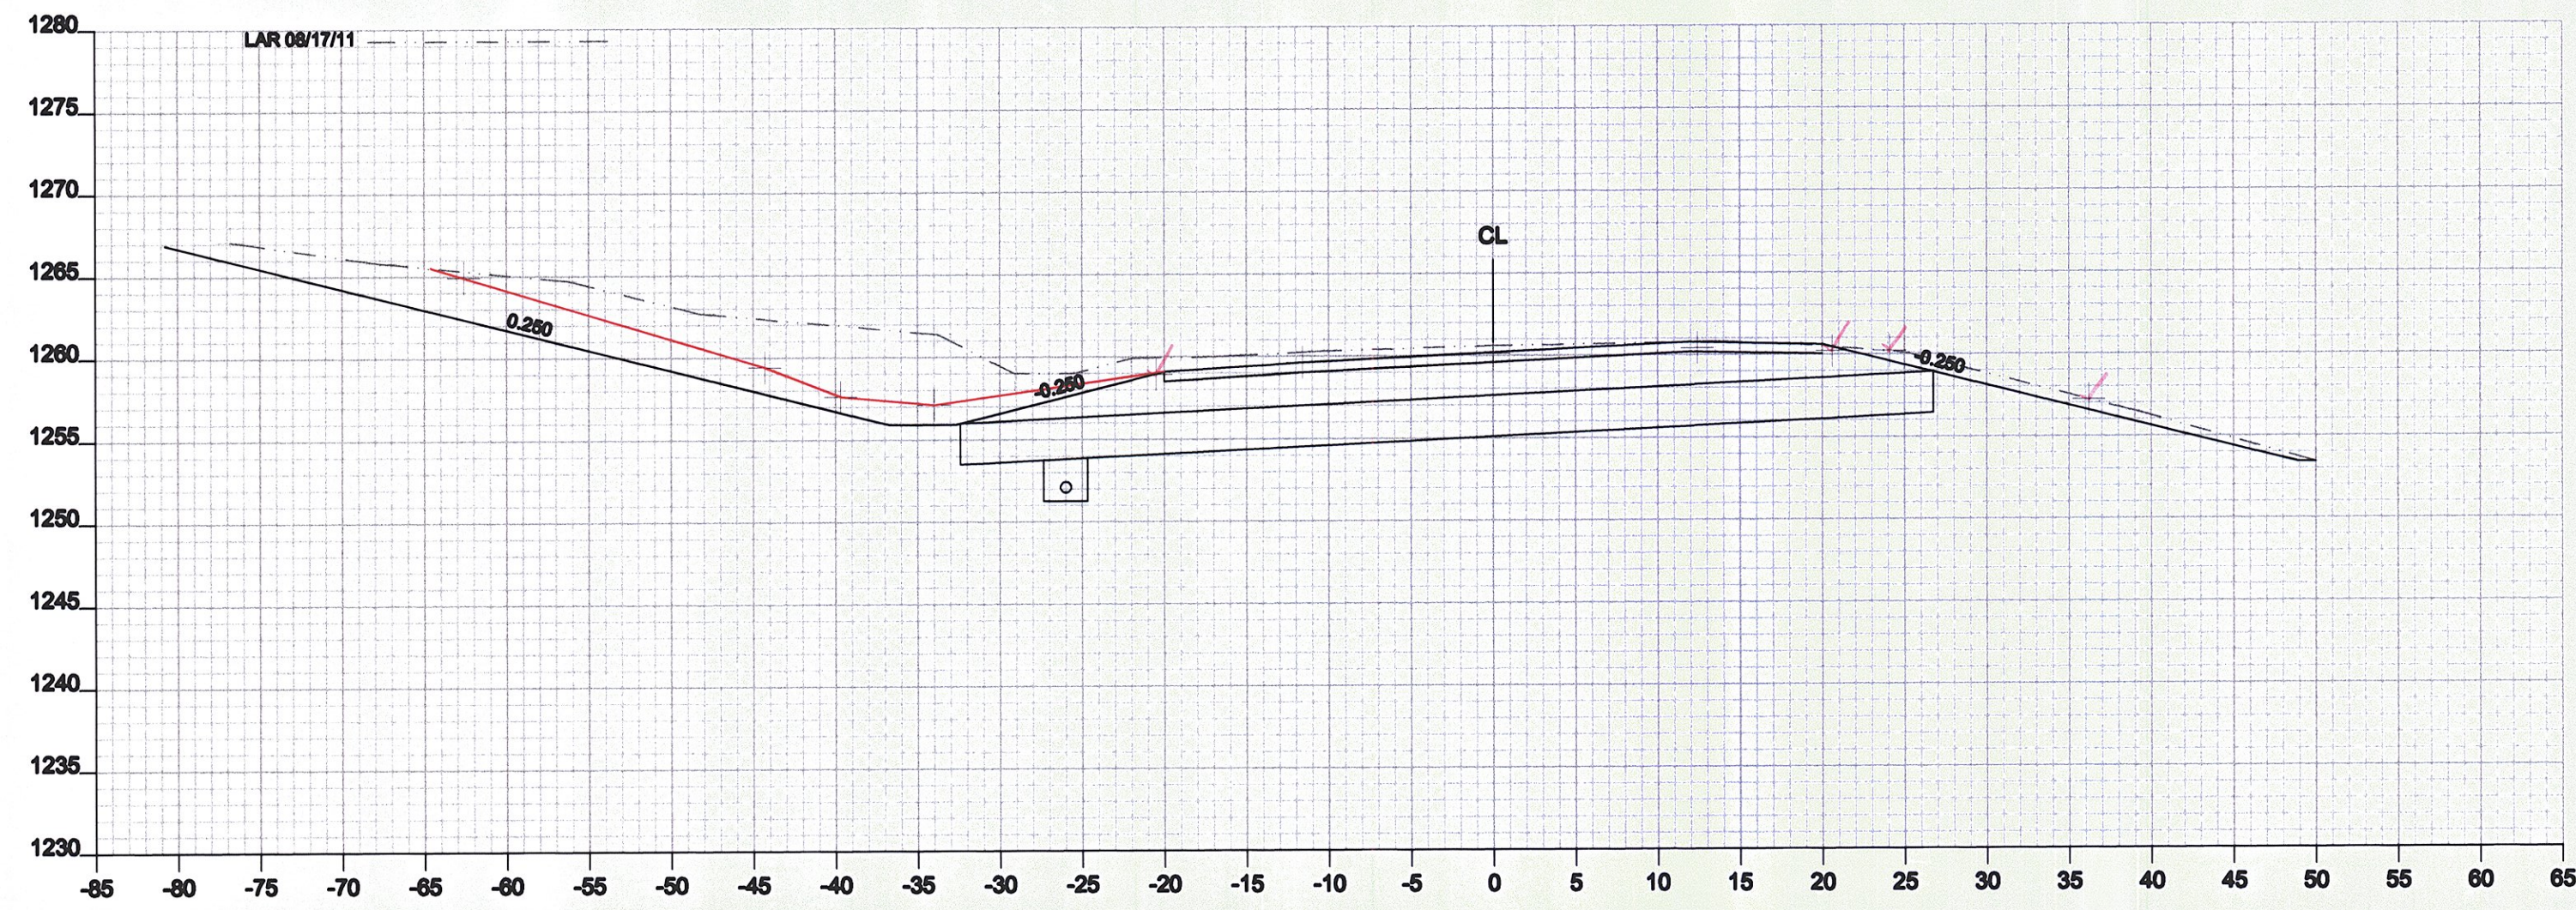

176+00

✓ Plot WRF 12-19-11  
 ✓ Accn WRF 12-21-11