



178+50

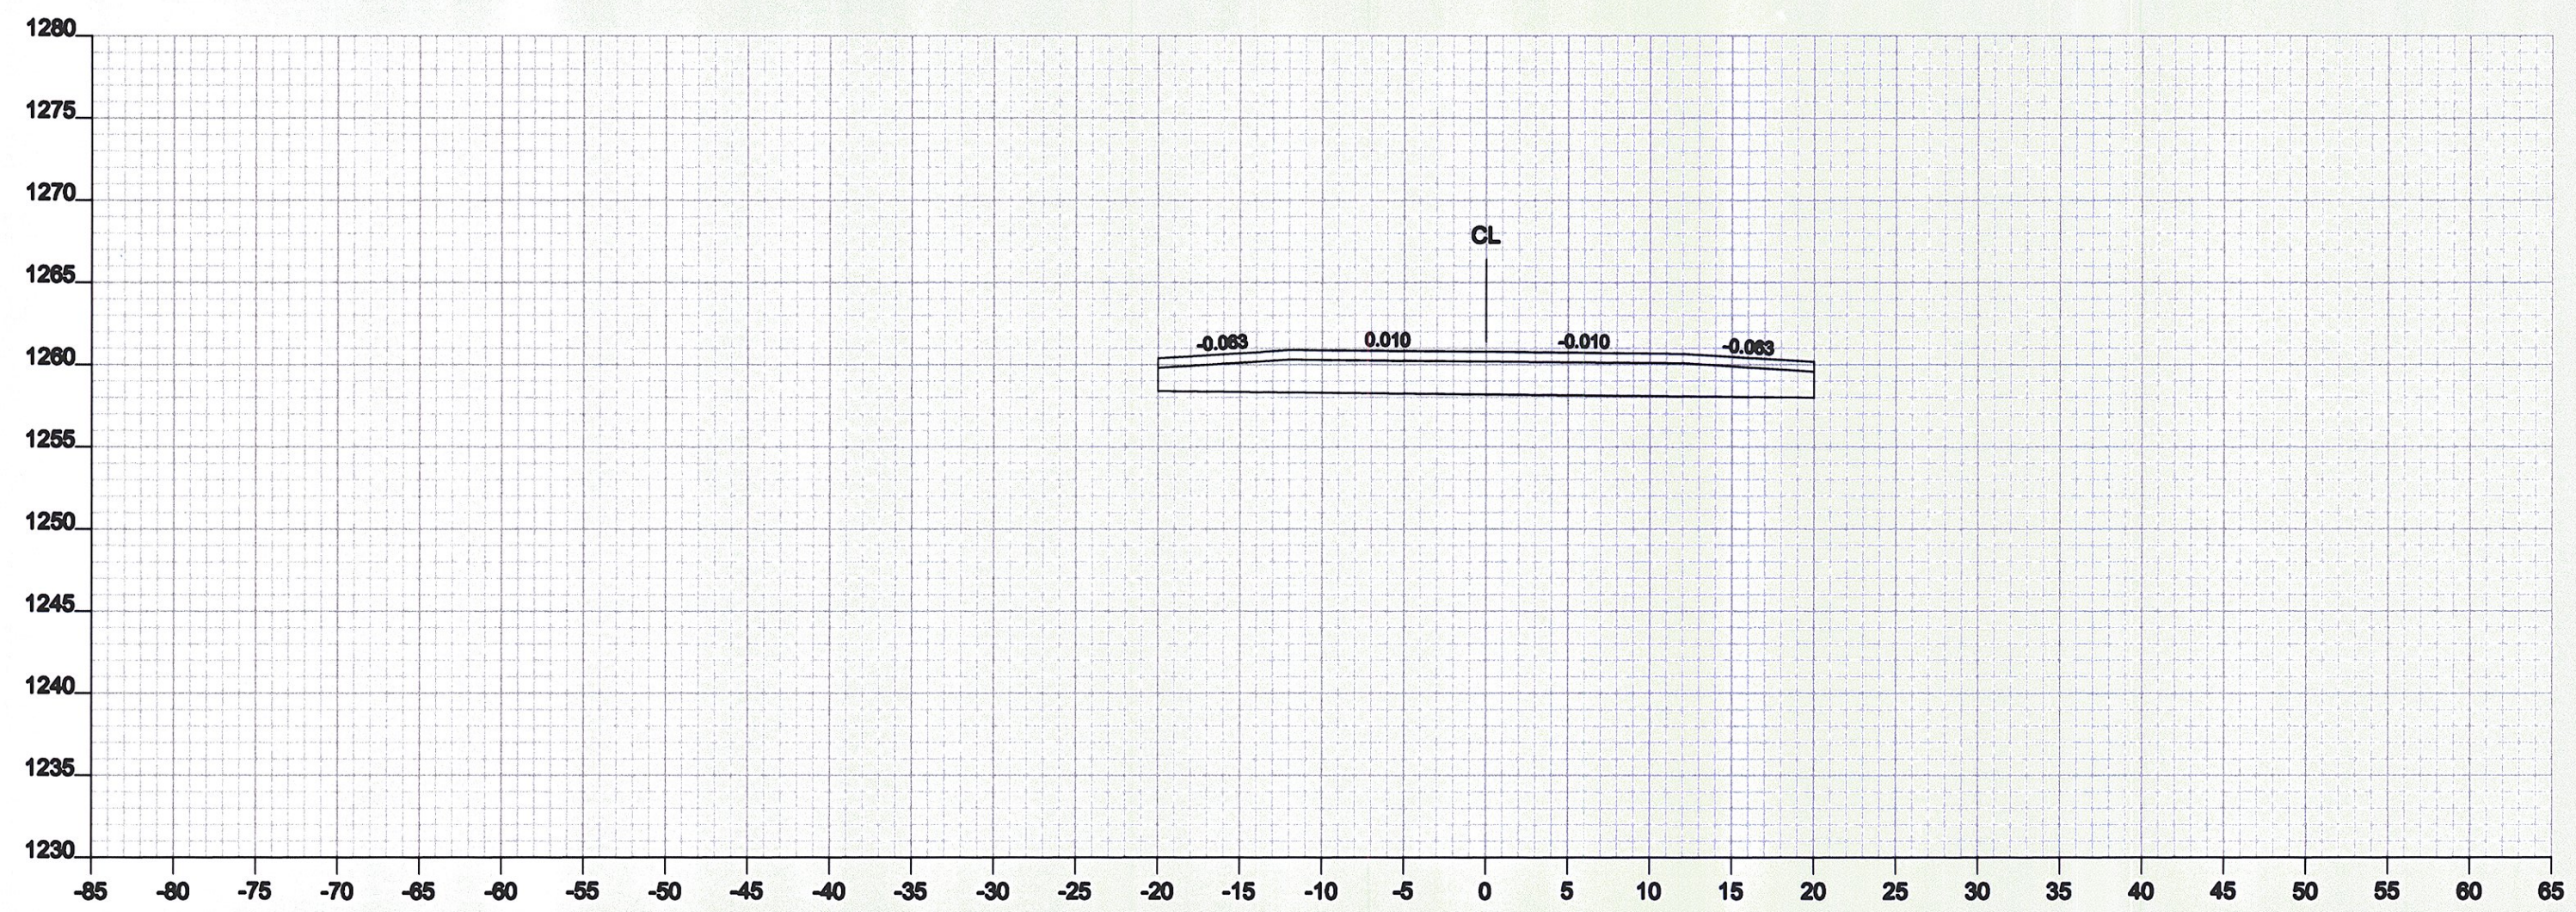

178+00

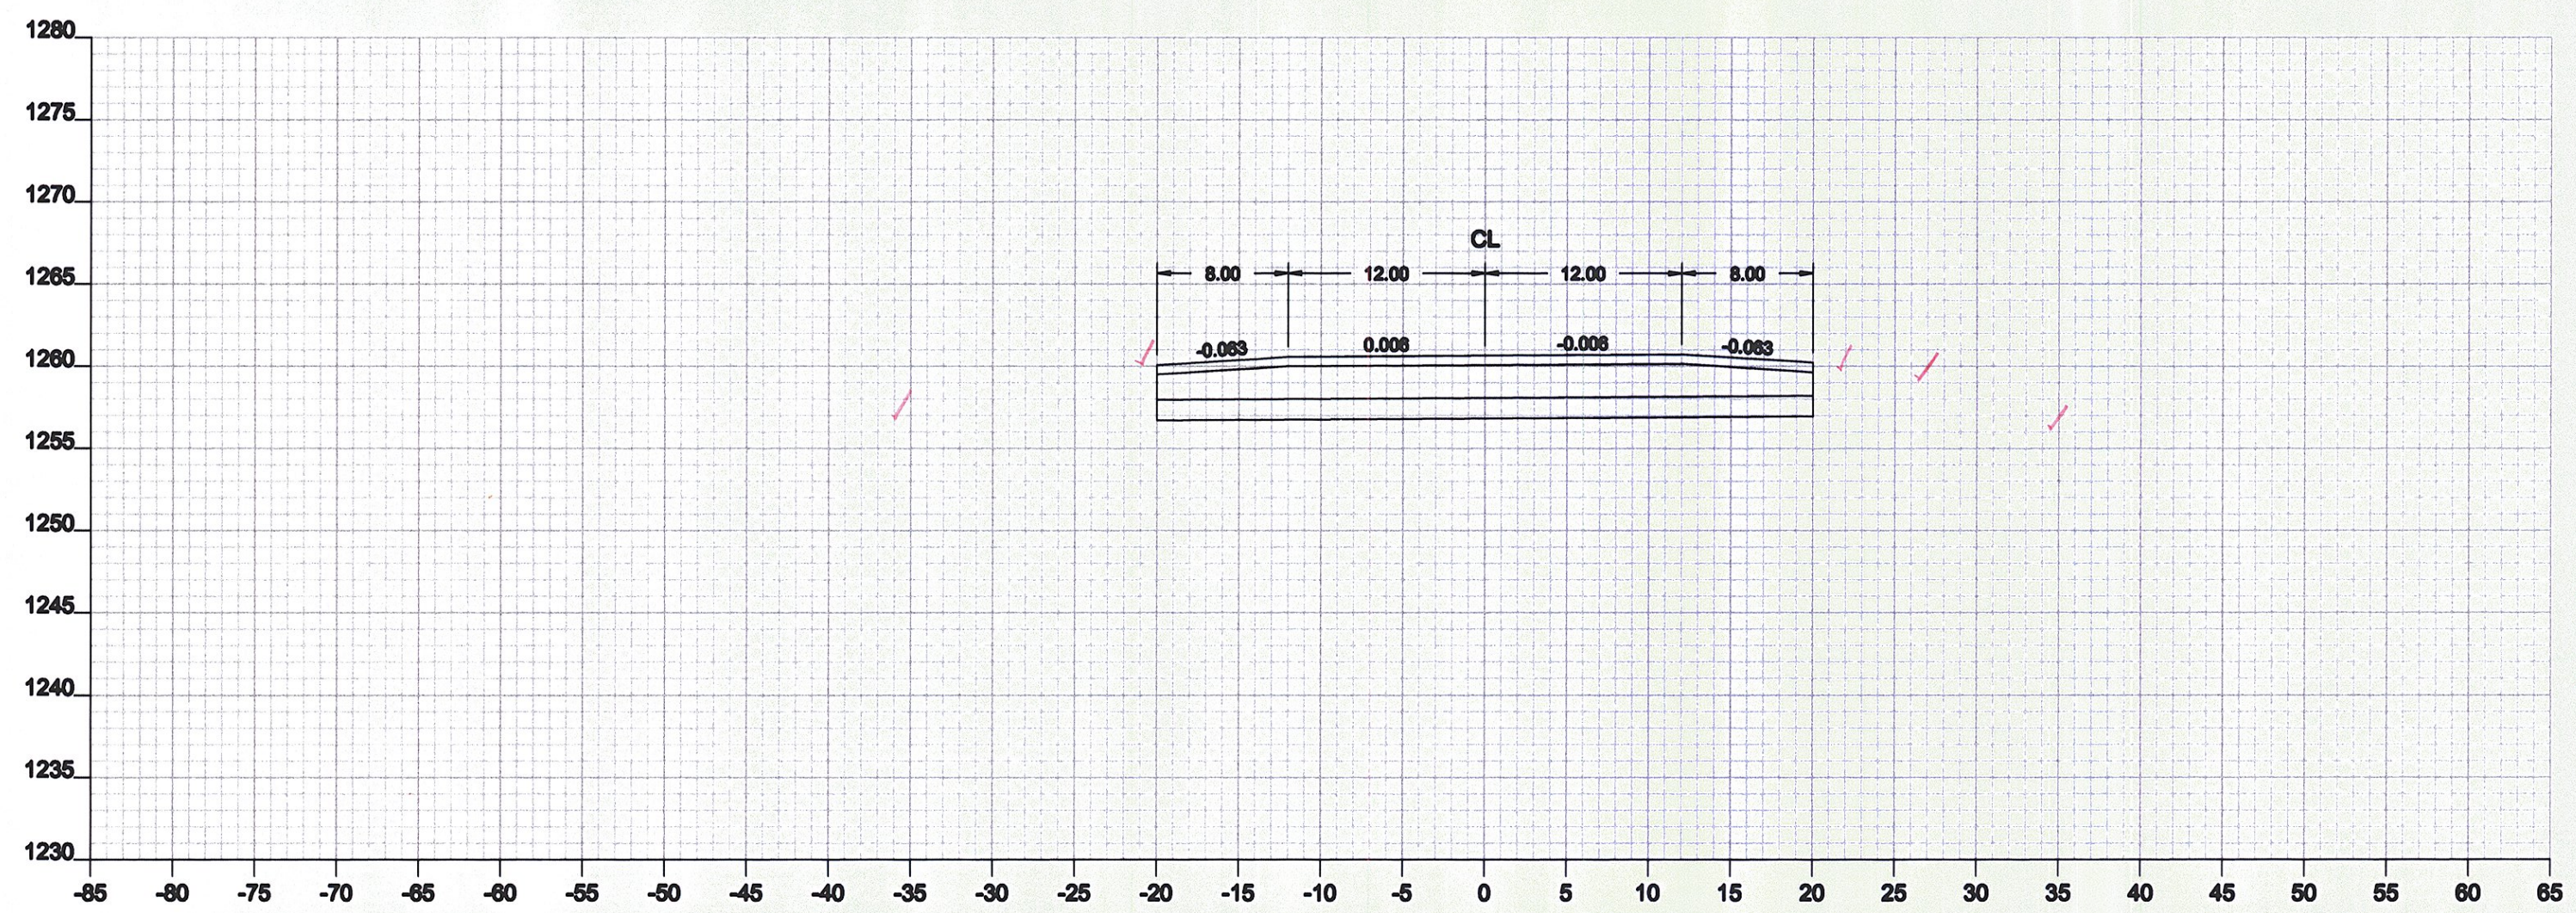

177+50

✓ PWA WRF (2-19-11)  
 ✓ AREA WRF (2-21-11)