




21+50

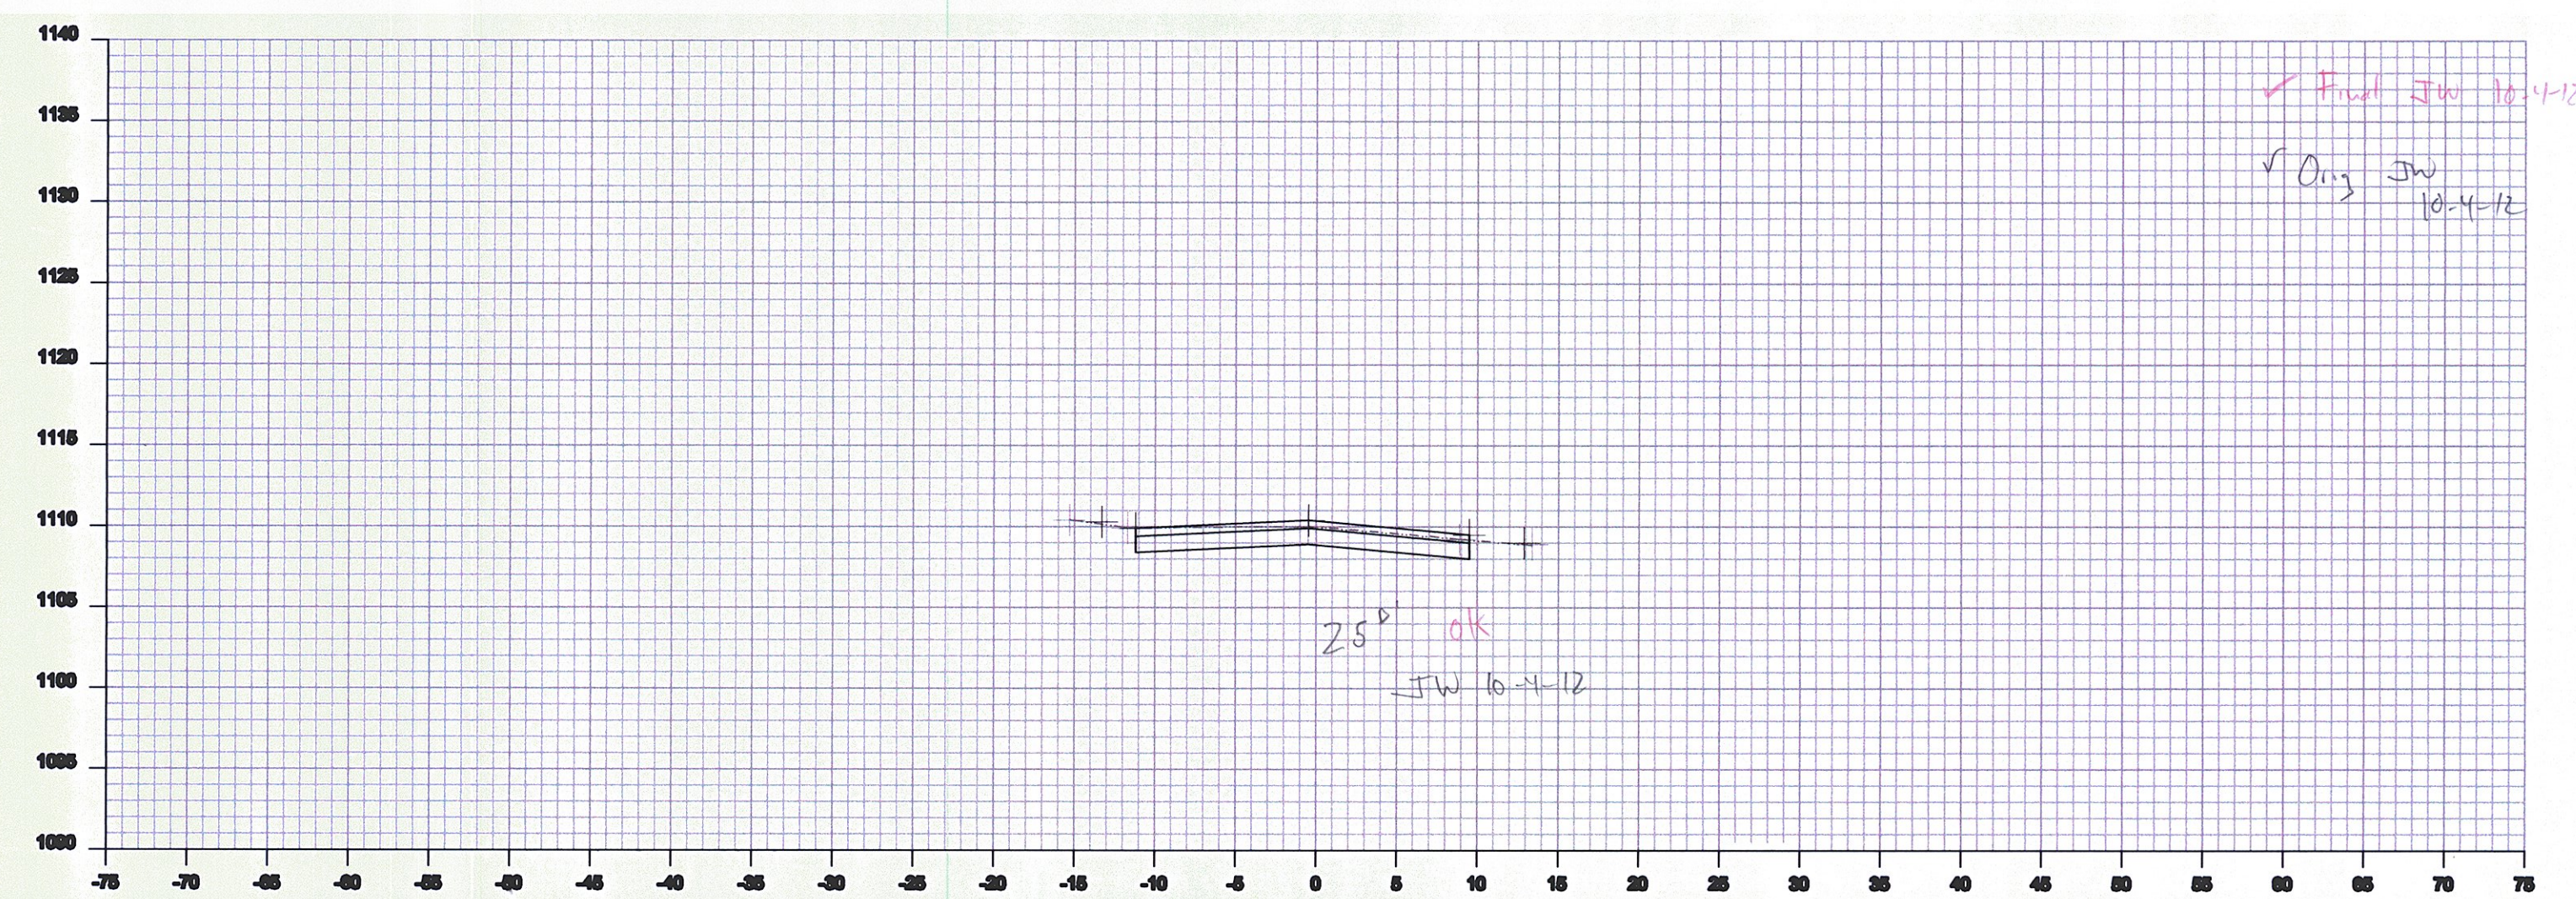


23+00

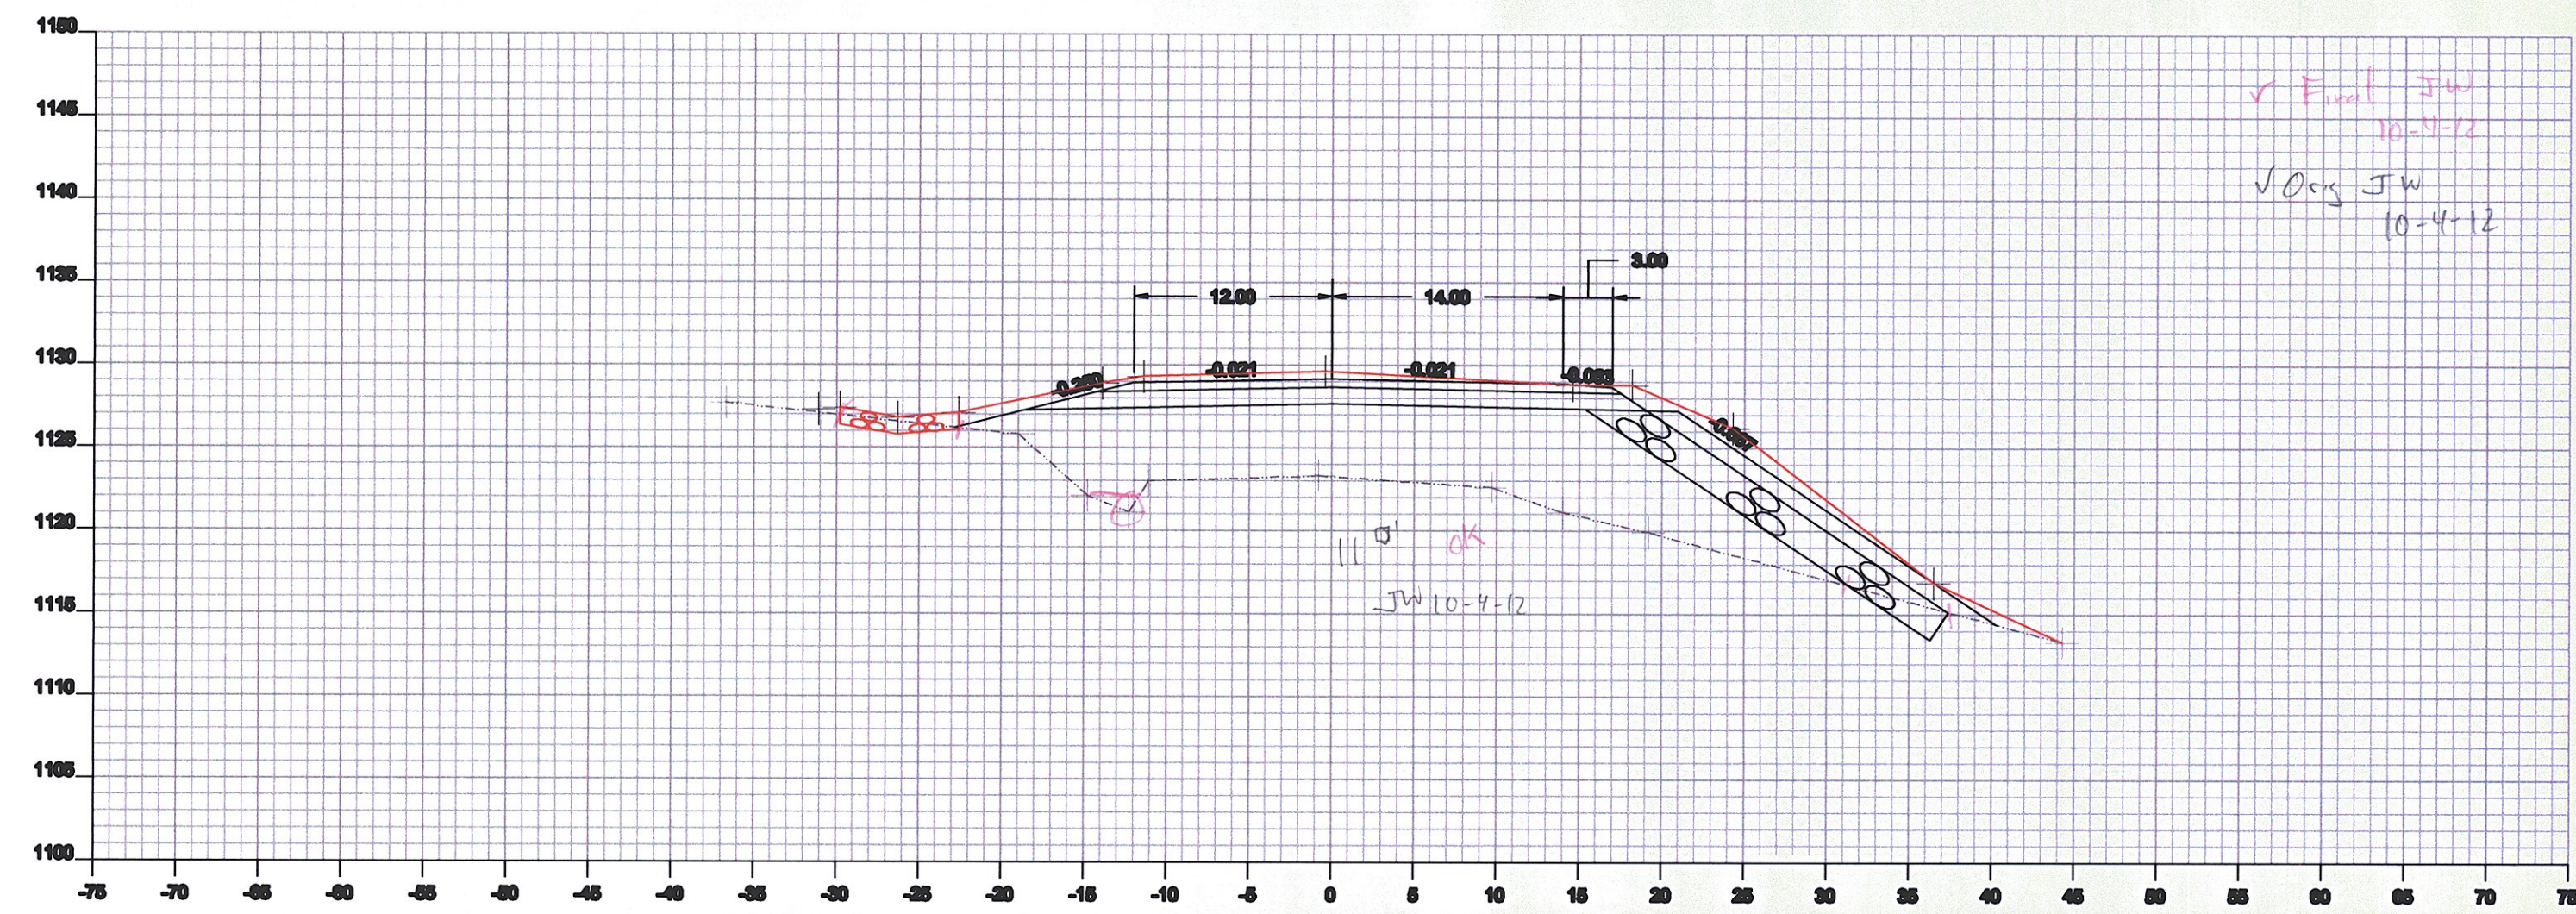


21+00

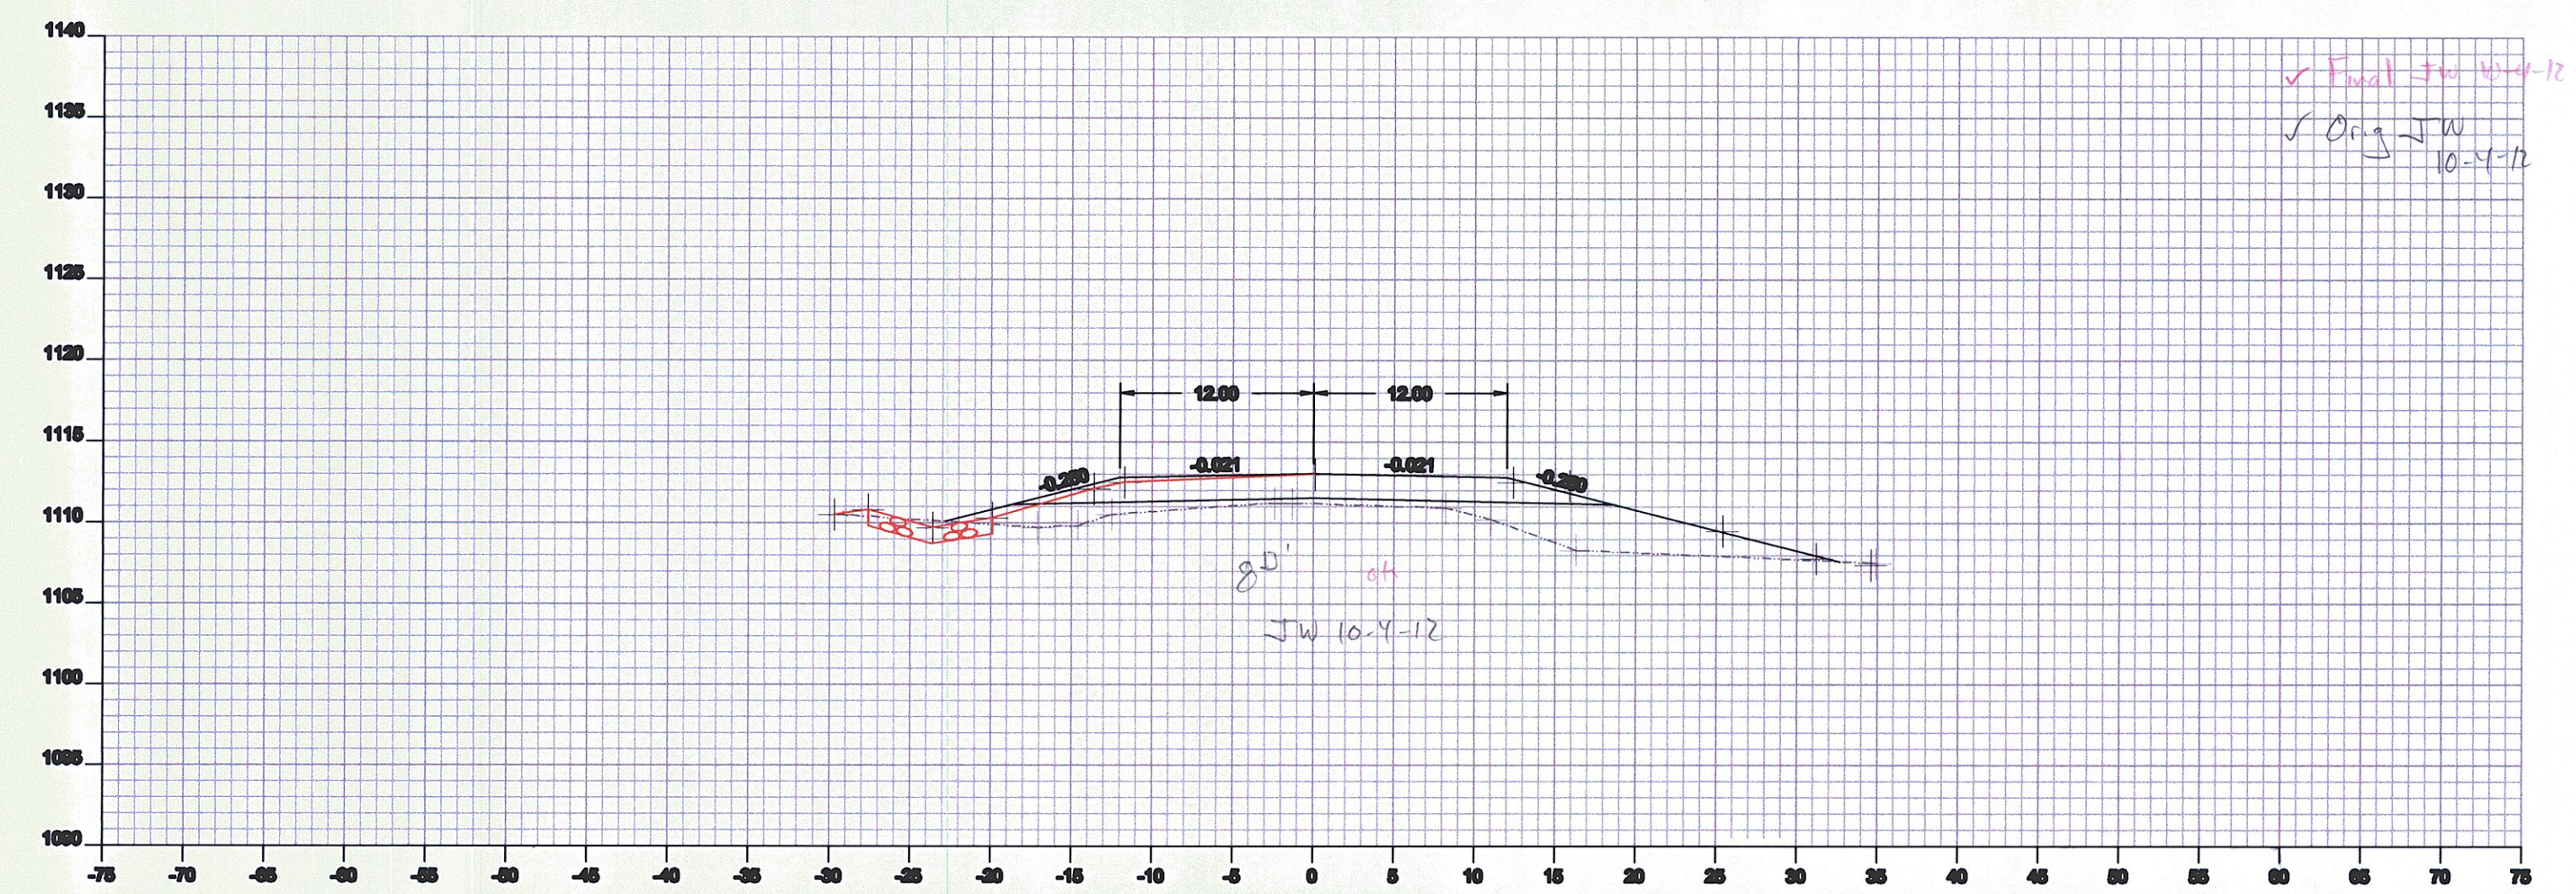

22+50

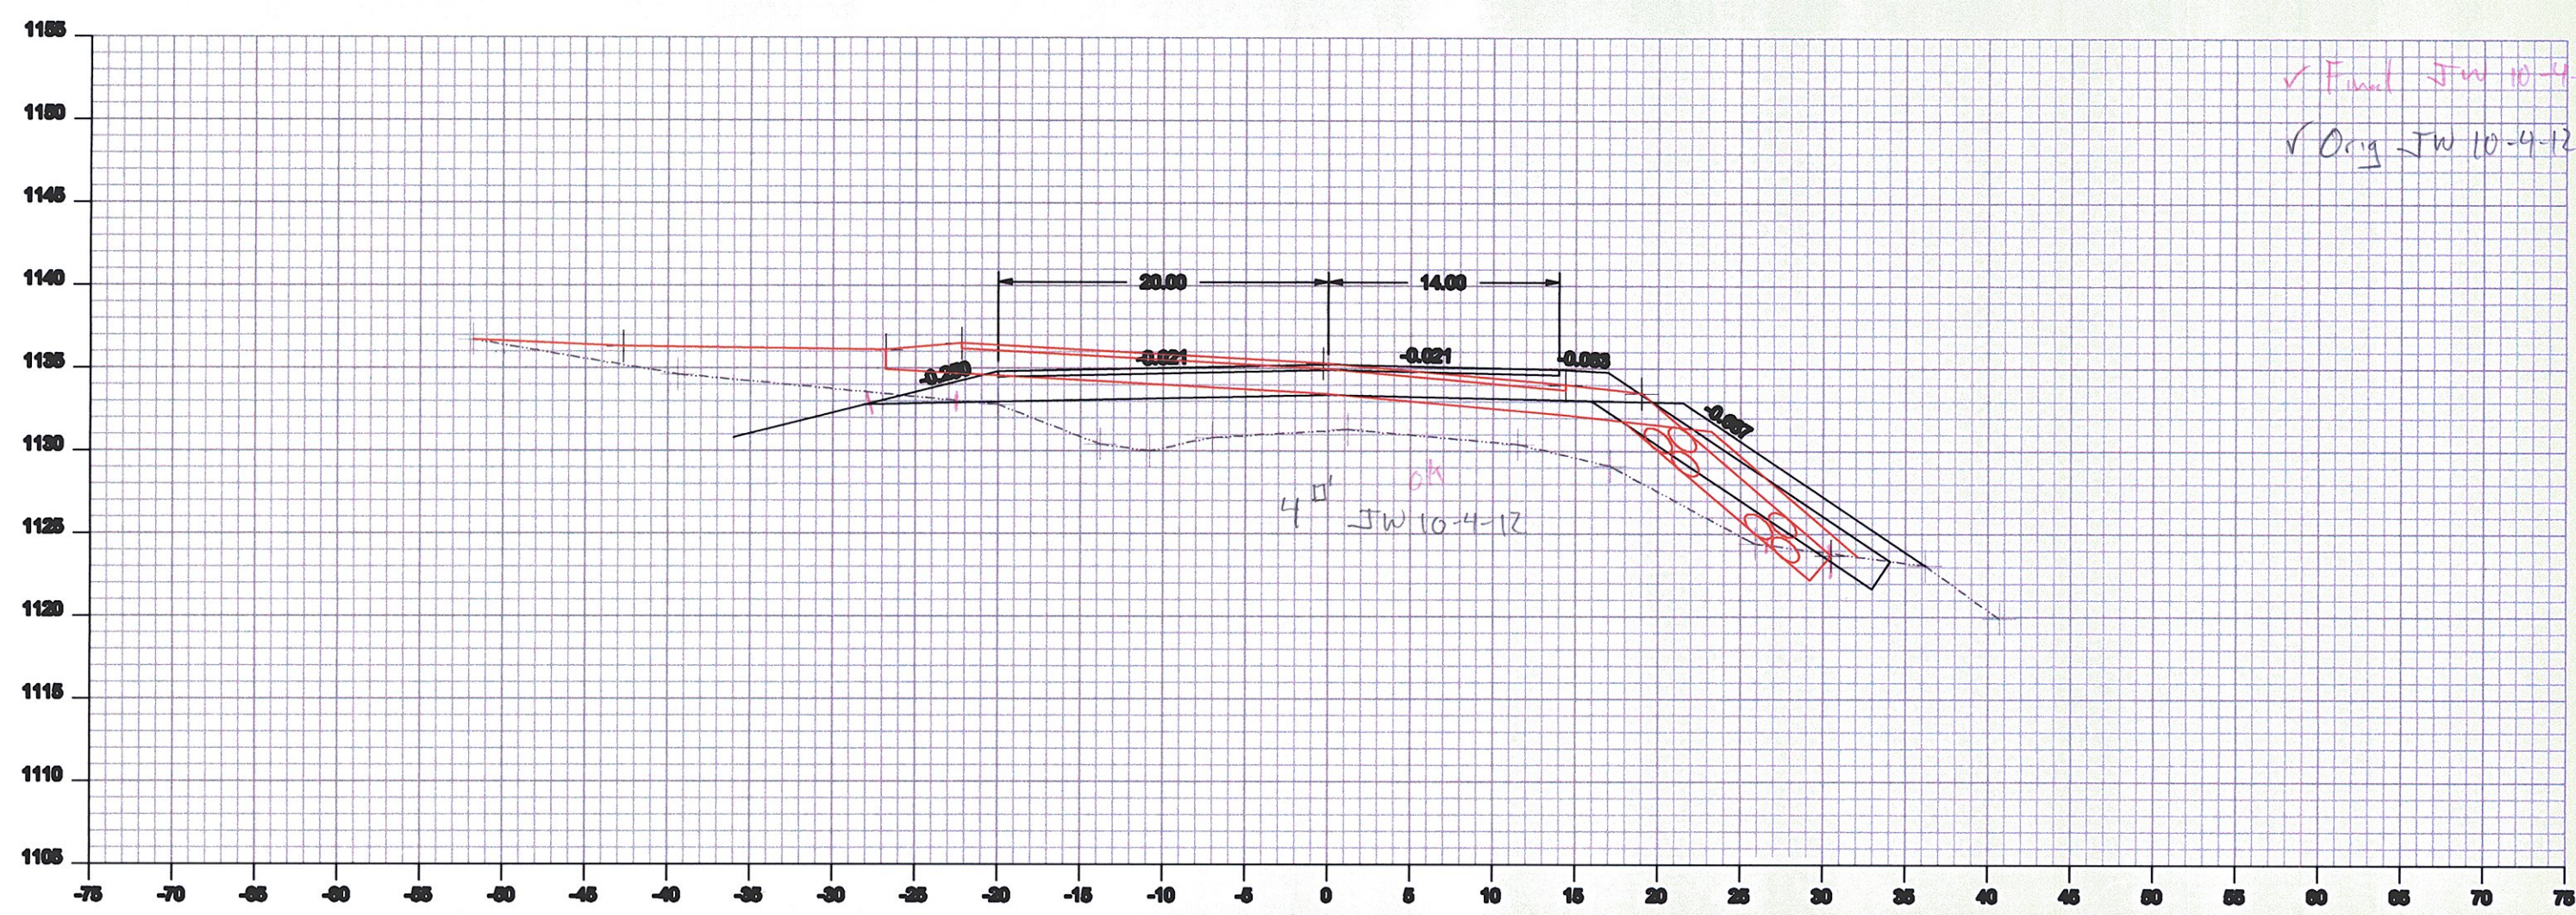

20+50

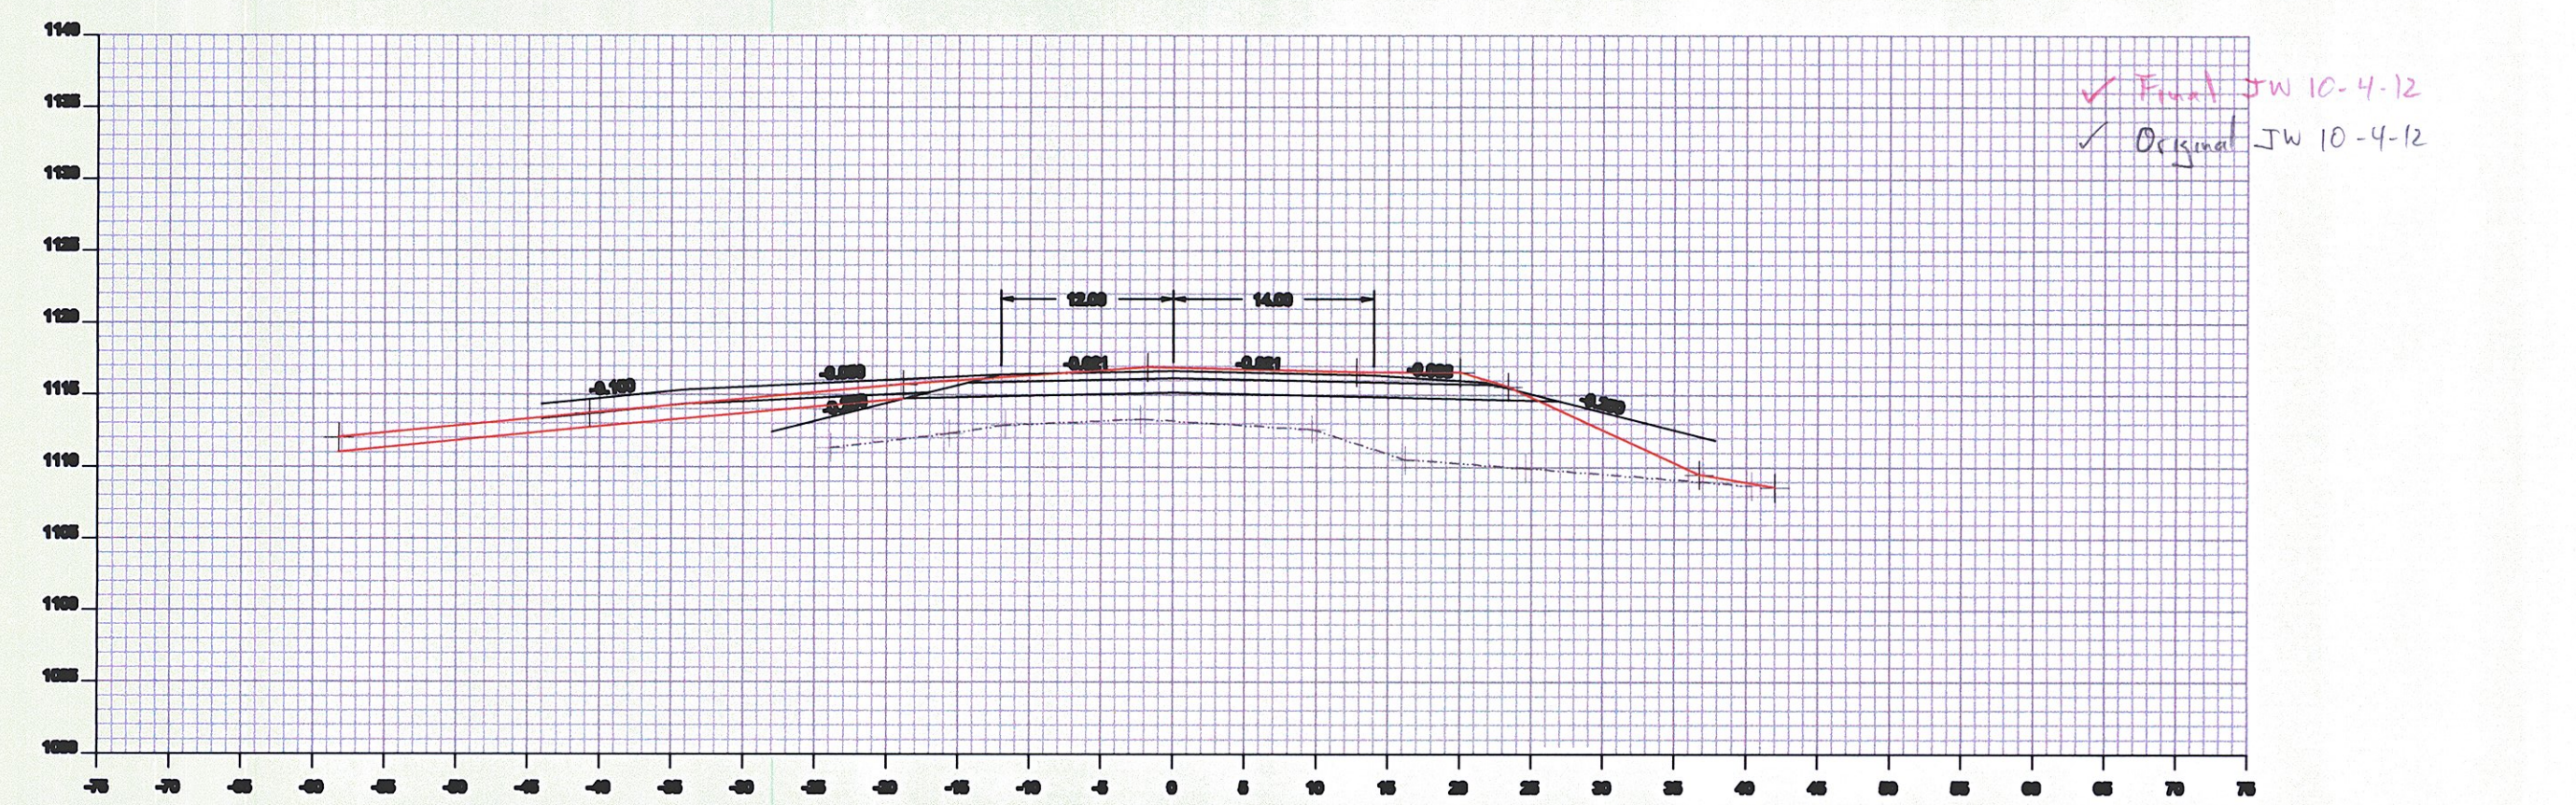

22+00

Drawing: Cross Section 20+50 - 23+00  
 Project: Cabot Danville  
 Drawn By: JMR  
 Date: 10-01-2012  
 Checked By:  
 Date:  
 Scale: 1:10  
 Sheet: of