



2+50

Orig ✓
Final ✓

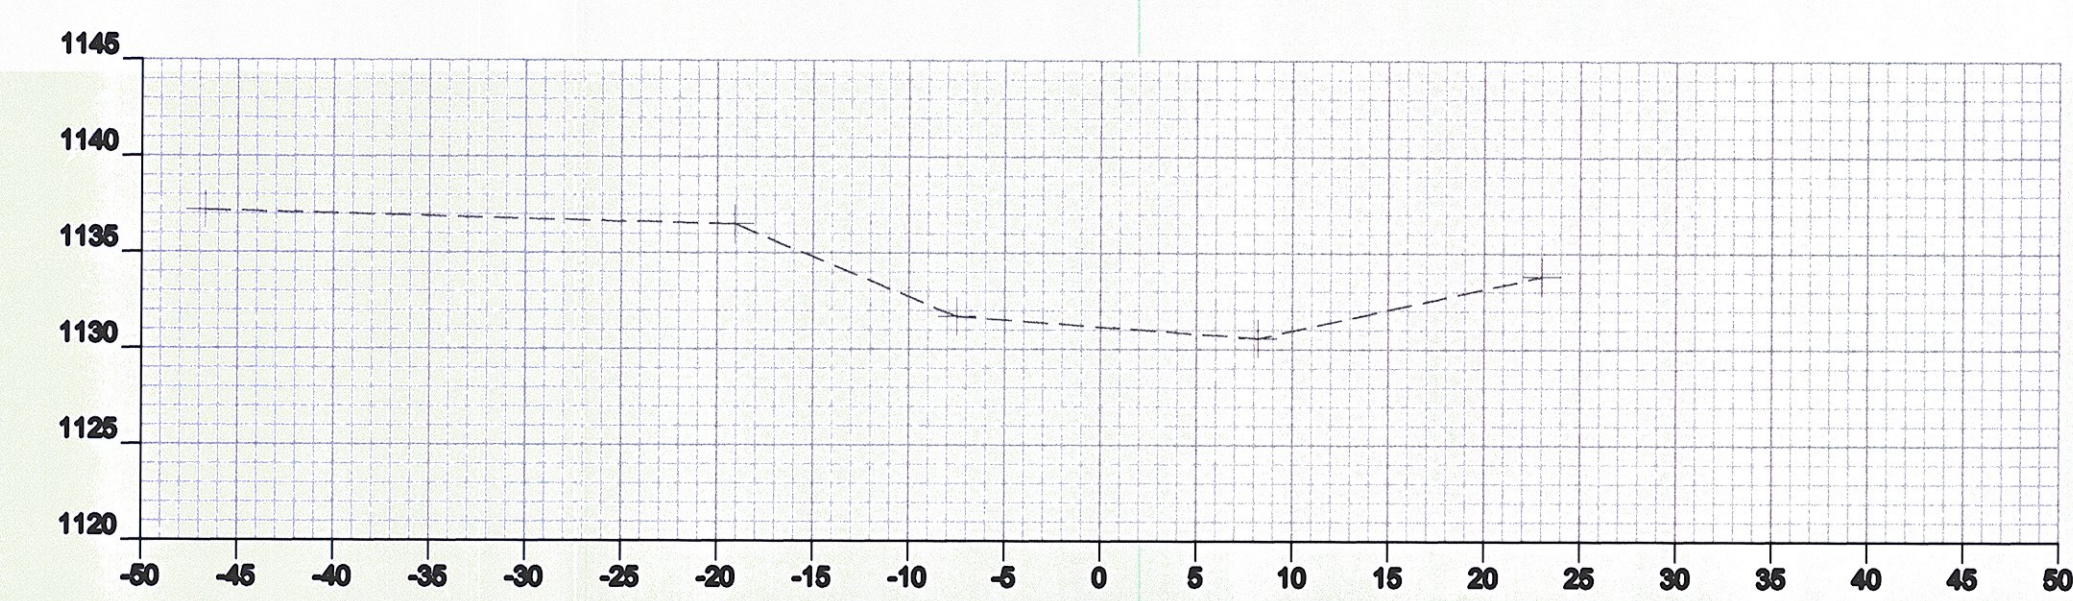


4+25

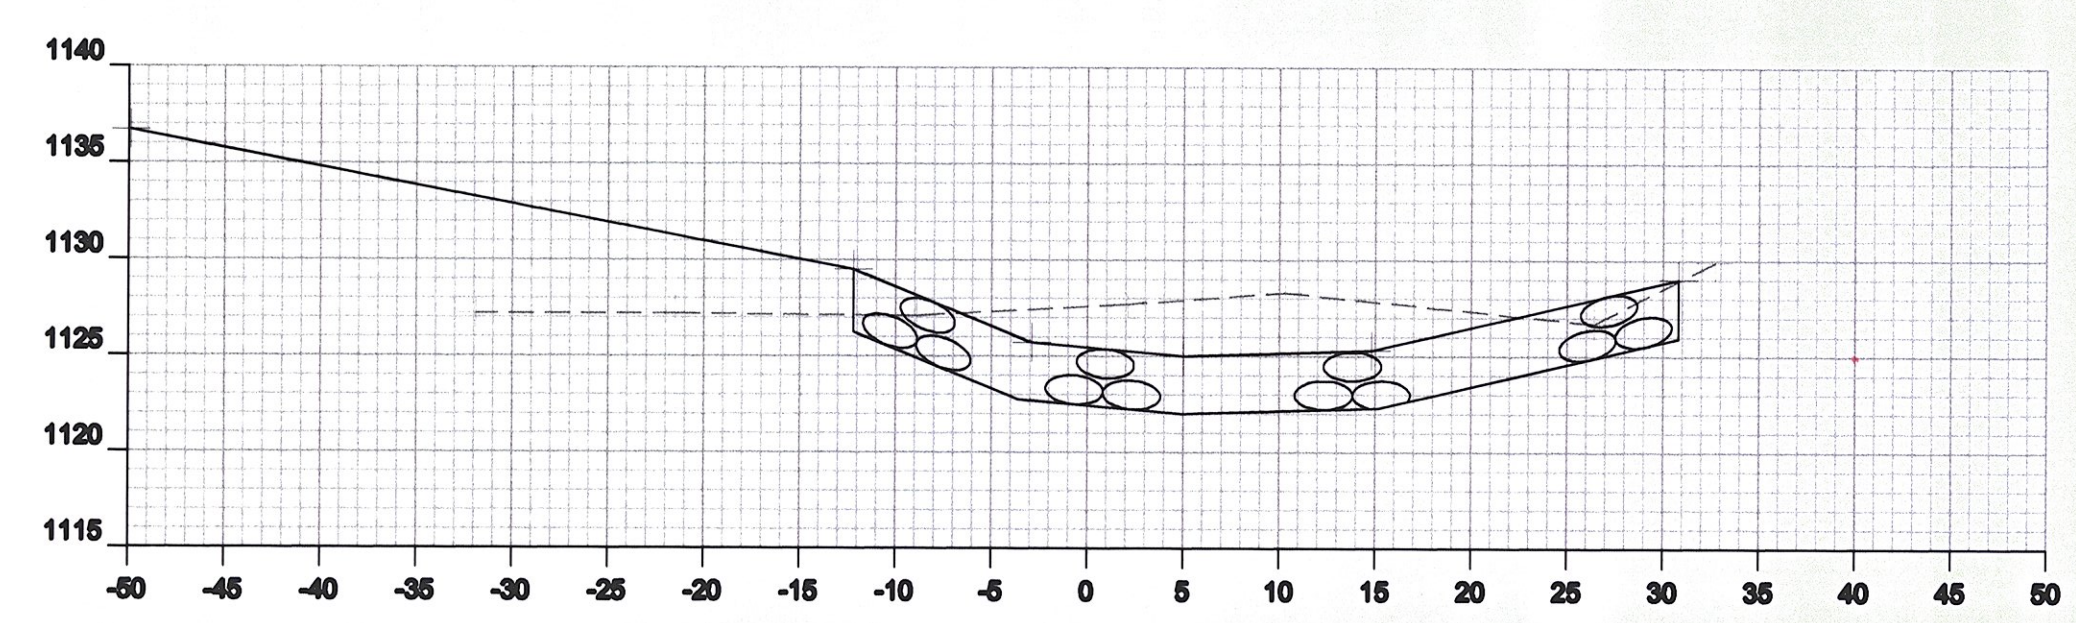


2+00

Orig ✓
Final ✓
WRF 5-10-12

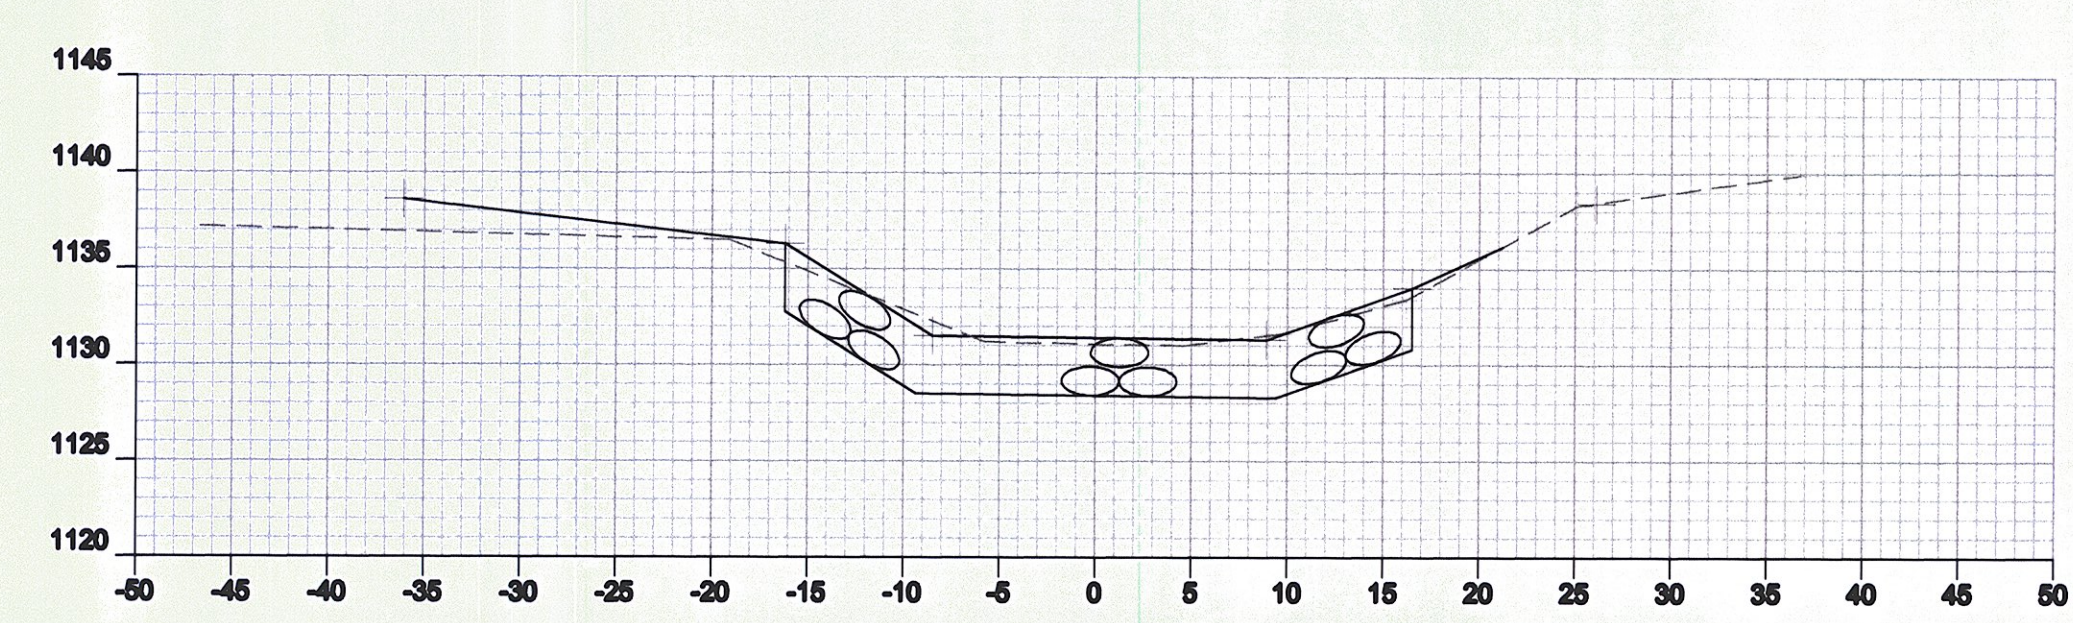


4+00

Orig ✓
Final ✓
WRF
05-10-12

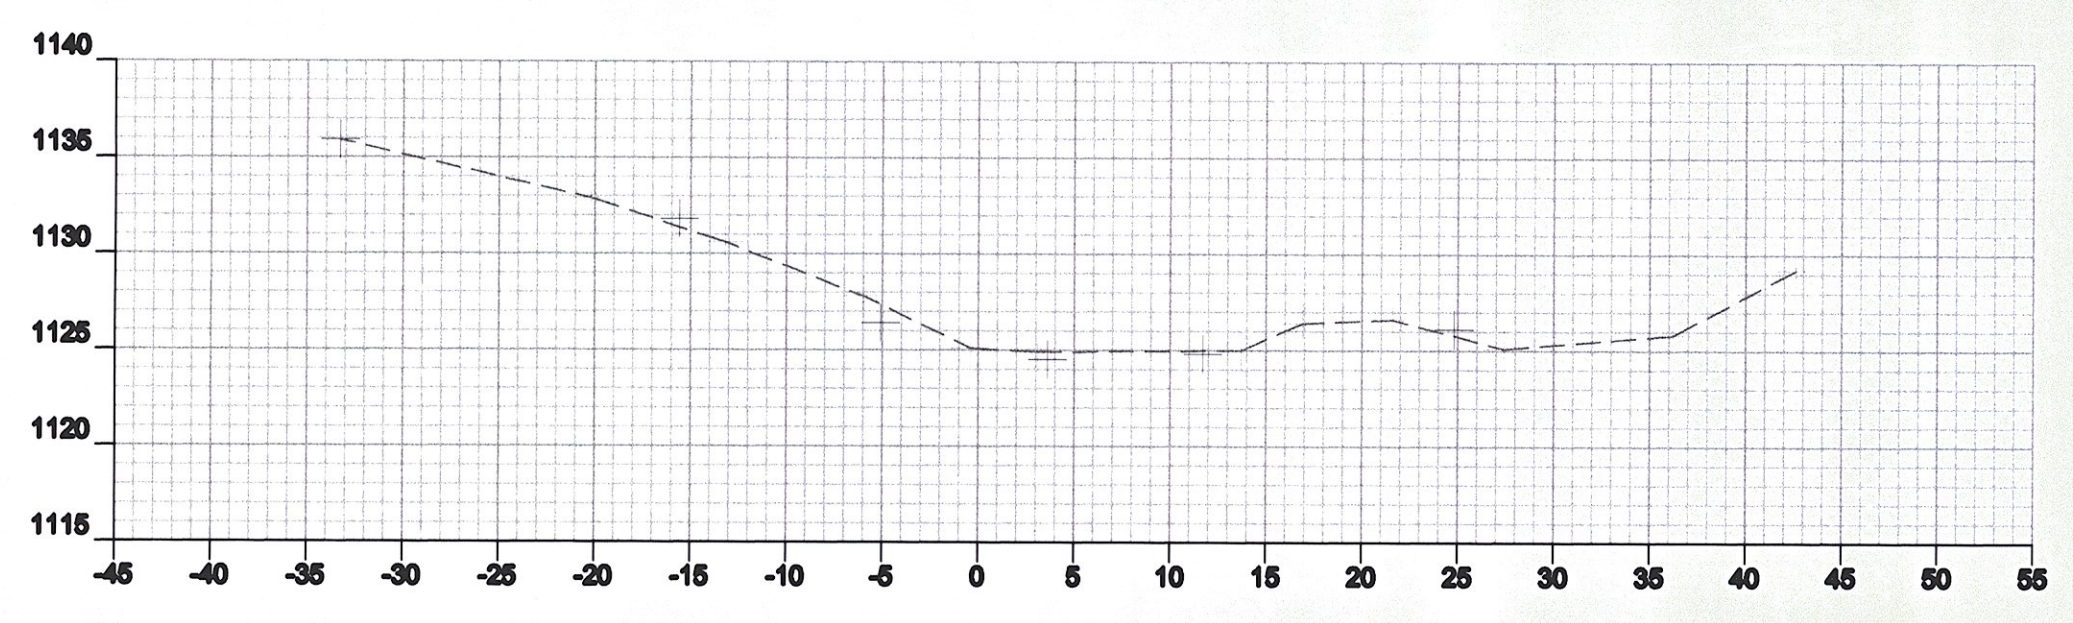


1+75

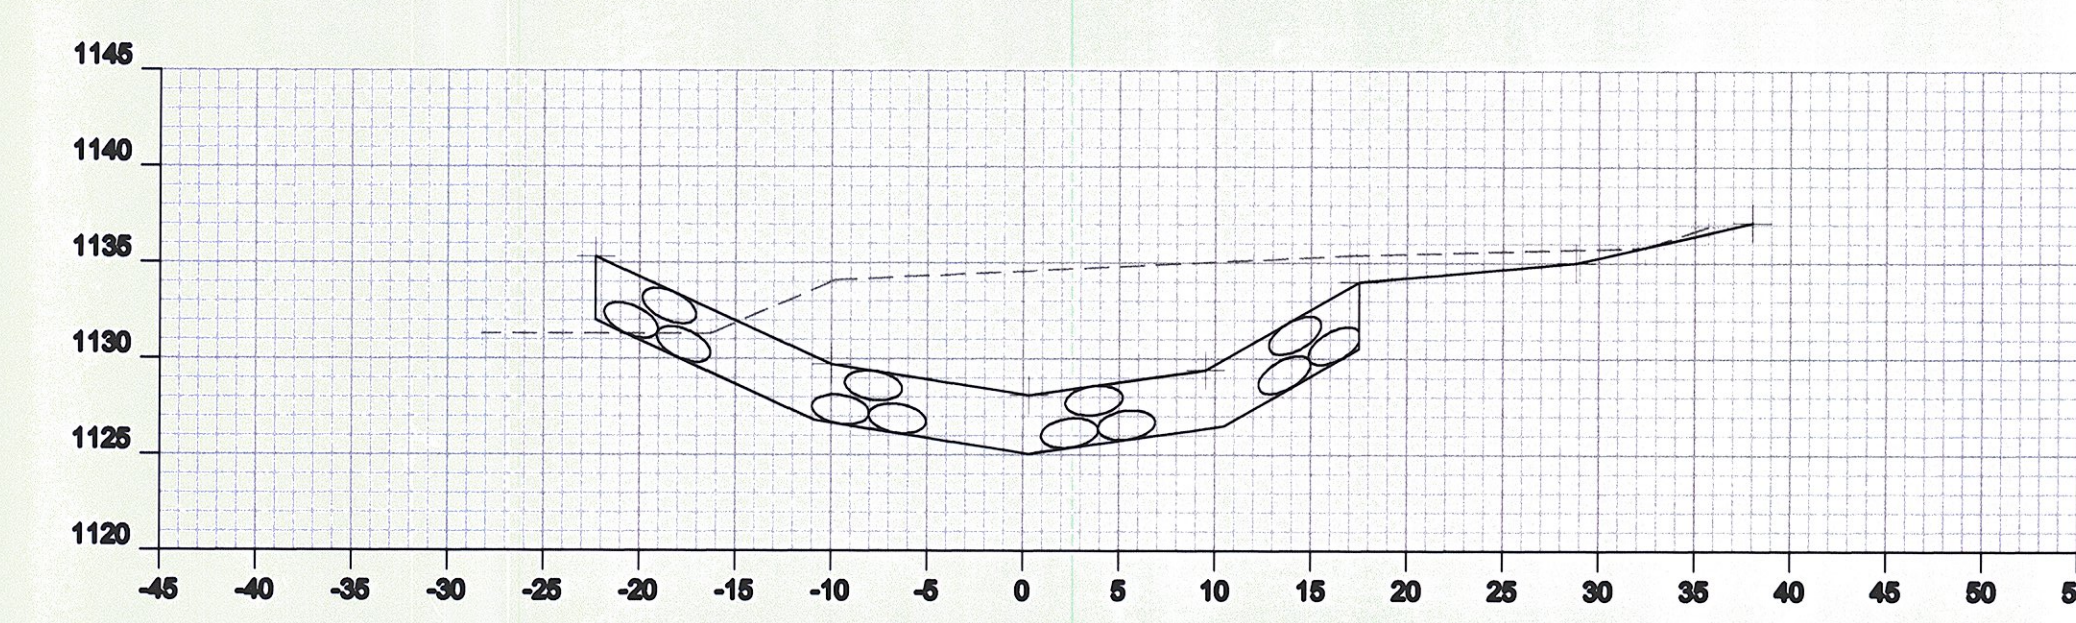


3+50

Orig ✓
Final ✓

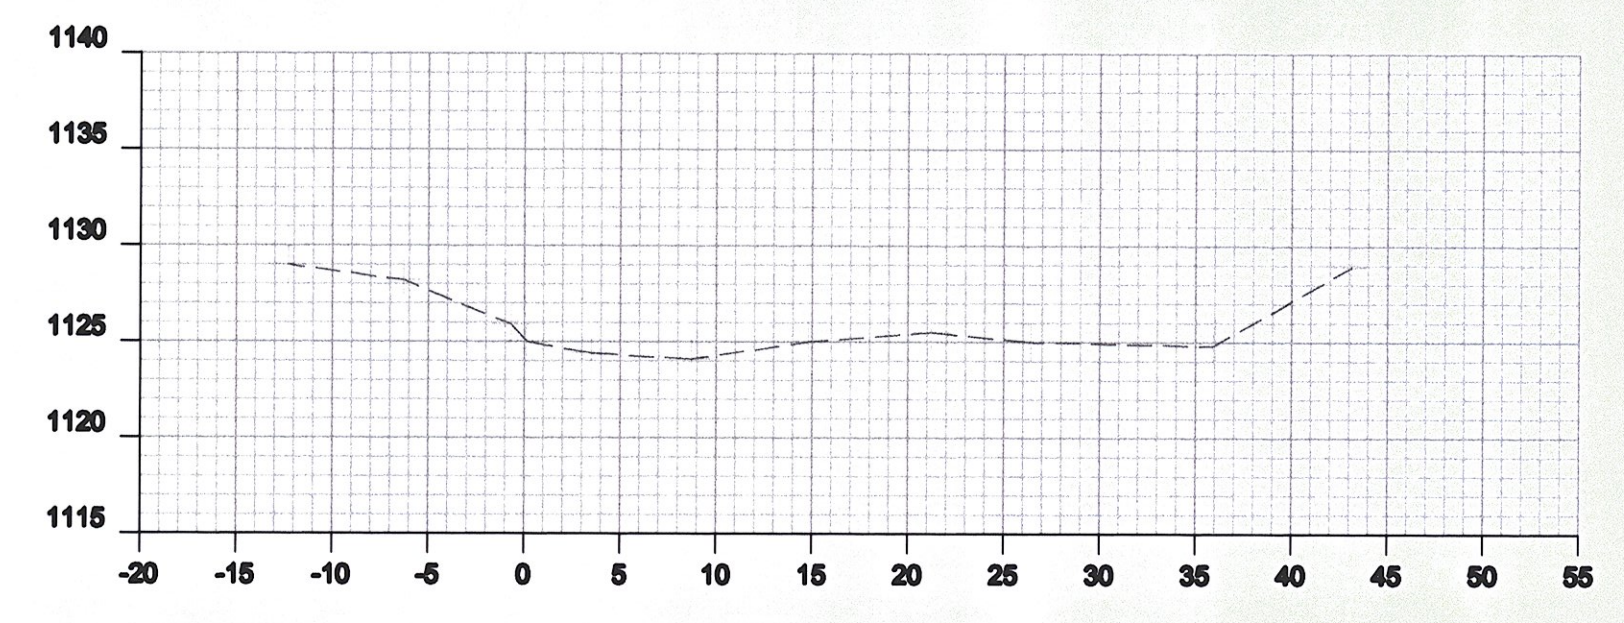

1+50

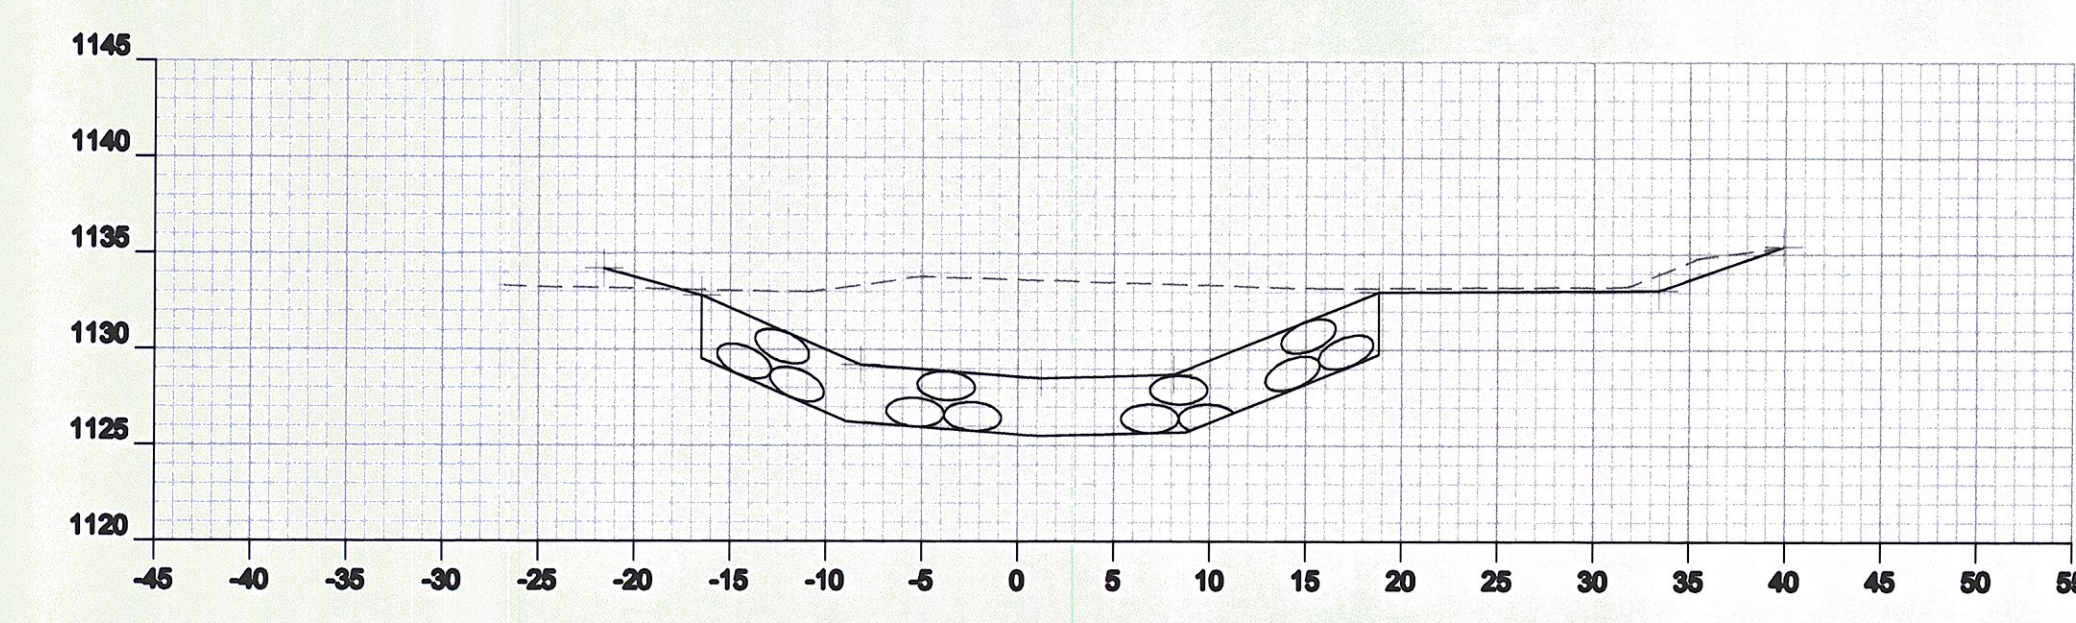

3+00

✓ Orig
✓ Final

| | |
|-------------|--------------------|
| Drawing: | Channel Relocation |
| Project: | Cabot Damville |
| Drawn By: | JMR |
| Date: | 04-27-2012 |
| Checked By: | Detae |
| Scale: | 1:10 |
| Sheet: | of |