

SLOPE STABILIZATION  
STONE FILL TYPE II  
102+00 TO 106+75 LT ADDED

MANUFACTURED TERMINAL SECTION, FLARED

CONSTRUCT DRIVES

LT.

RT.

100+40 - APRON ONLY

PUB. RD. DIV. NO.	STATE	FED. AID PROJ. NO.	FISCAL YEAR	SHEET NO.	TOTAL SHEETS
1	VT.				

102+47.5 ~ 102+85

STEEL BEAM GUARDRAIL

LI.

RI.

102+85 ~ 110+00



99  
STA. 100+00.00

MARSHFIELD - CABOT  
1978

BEGIN PROJECT F028-3(26)  
SECTION I  
MATCH EXISTING

☉ CURVE DATA #1

Δ = 9° 23' 33" LT.  
D = 2° 45' 00"  
R = 2083.48'  
T = 171.16'  
L = 341.55'  
E = 7.02'  
BANK = 0.050 FT/ FT

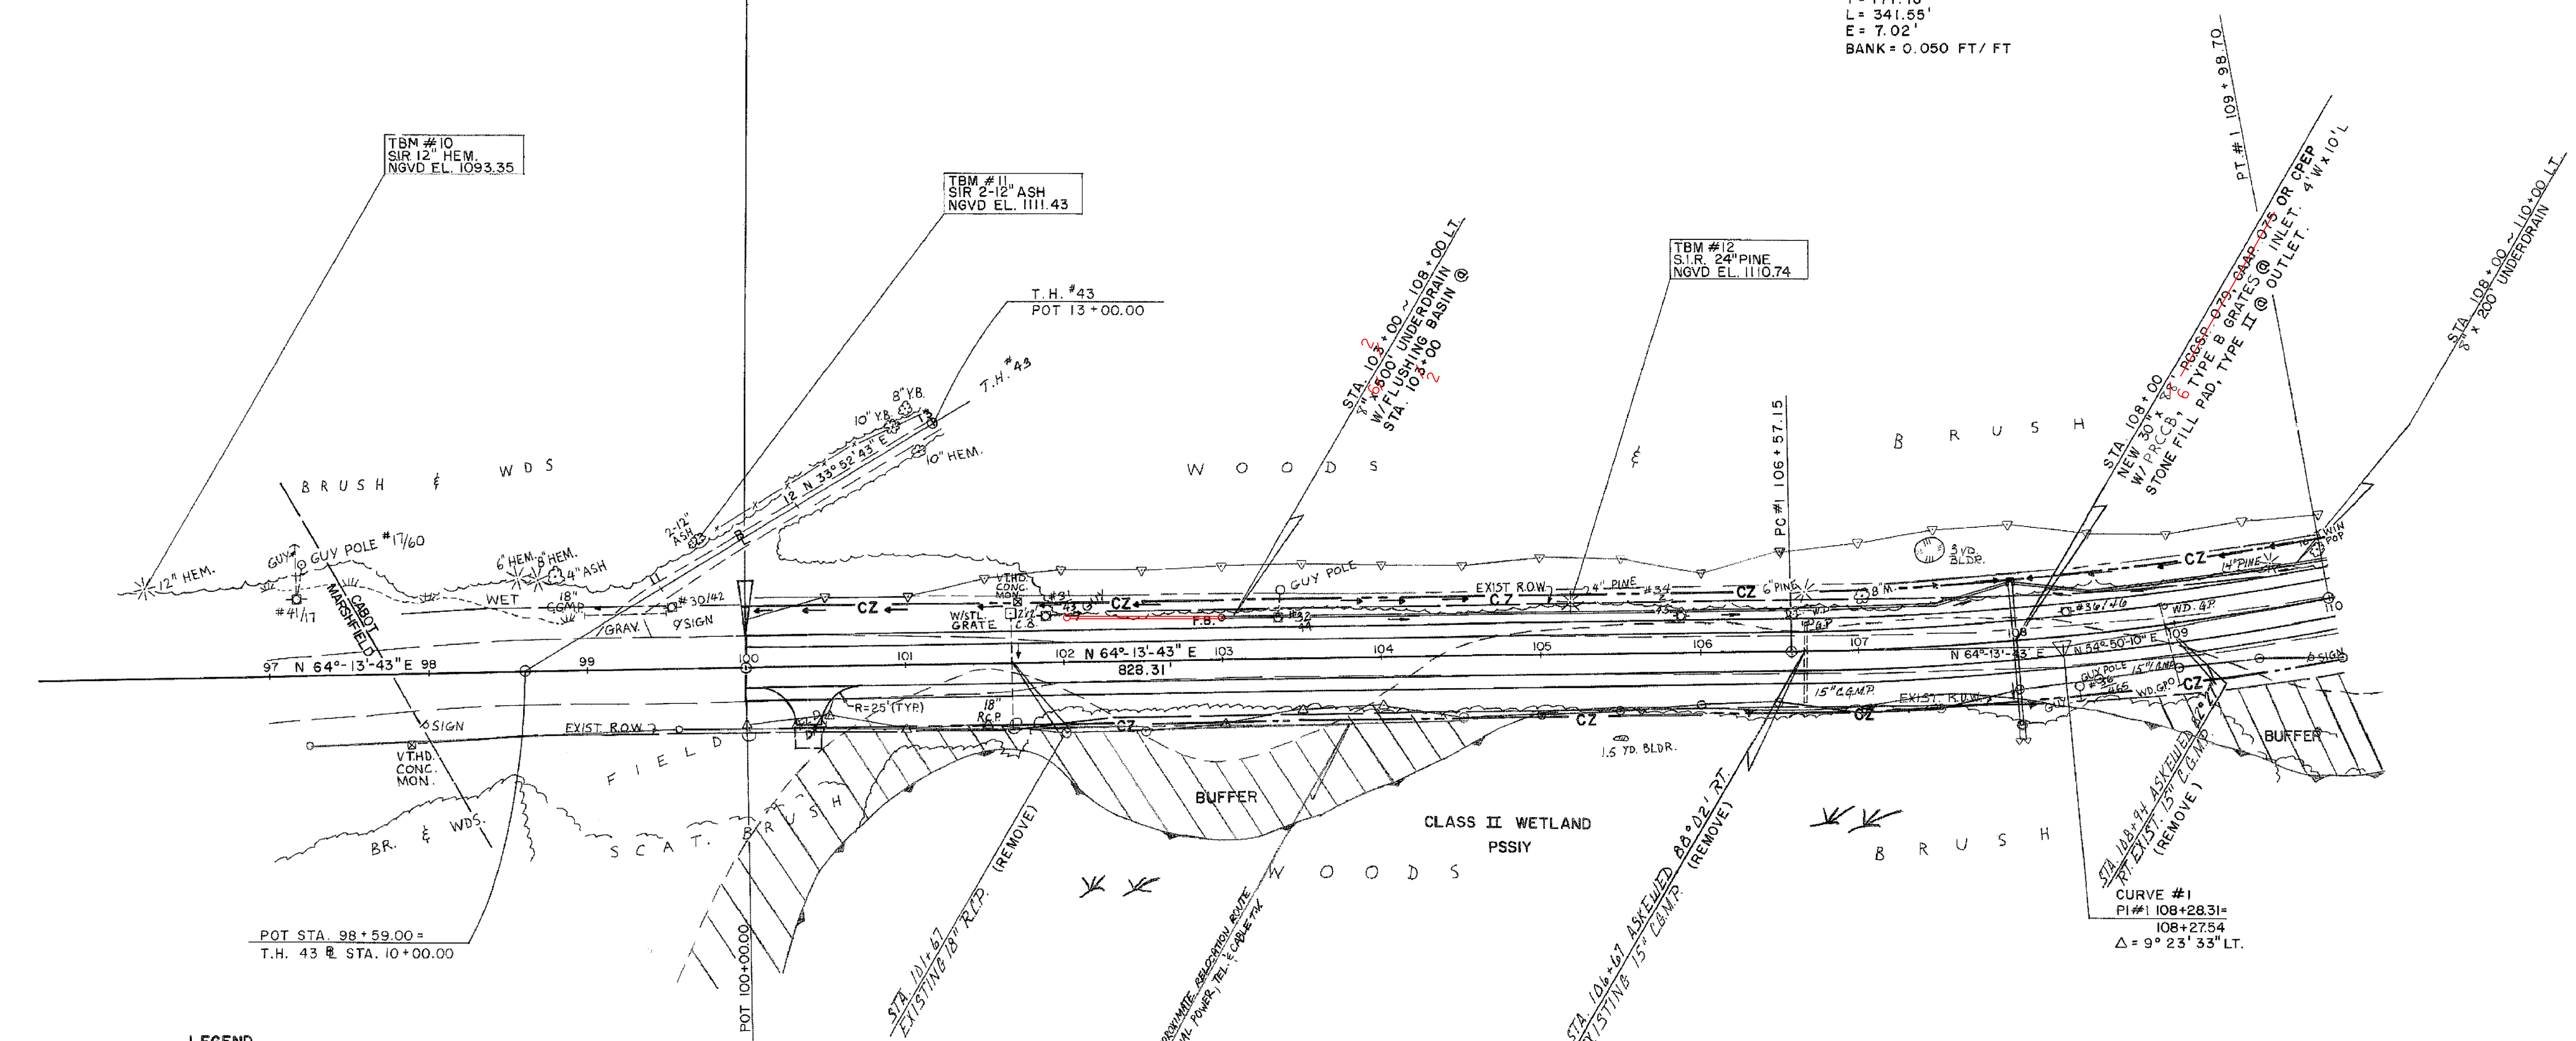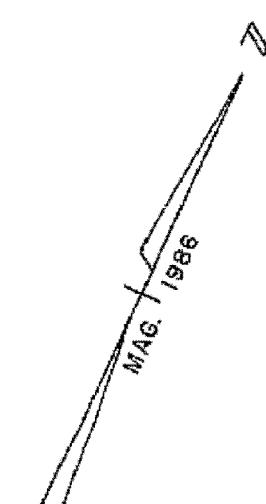

LEGEND

- CZ ----- CLEAR ZONE
- ▲--- EDGE OF WETLAND
- WETLAND BUFFER ZONE
- DIG SAMPLE

DATUM

VERTICAL	NGVD - 1929
HORIZONTAL	N/A

SCALE IN FEET



PROJECT NAME: CABOT-DANVILLE  
PROJECT NUMBER: FECC F 028-3(26) C/1

FILE NAME: d78d058frm.dgn  
PROJECT LEADER: K. ROBBE  
DESIGNED BY: I. SHEA  
LAYOUT SHEET I

PLOT DATE: 13-OCT-2010  
DRAWN BY: I. SHEA  
CHECKED BY: S. MENARD  
SHEET 33 OF 250