

DATE	BY	APPROVED	DATE
PLAN		APPROVED	
NOTE BOOK		NO. OF SHEETS	
NO.		NO.	

DATE	BY	APPROVED	DATE
PROFILE		APPROVED	
NOTE BOOK		NO. OF SHEETS	
NO.		NO.	

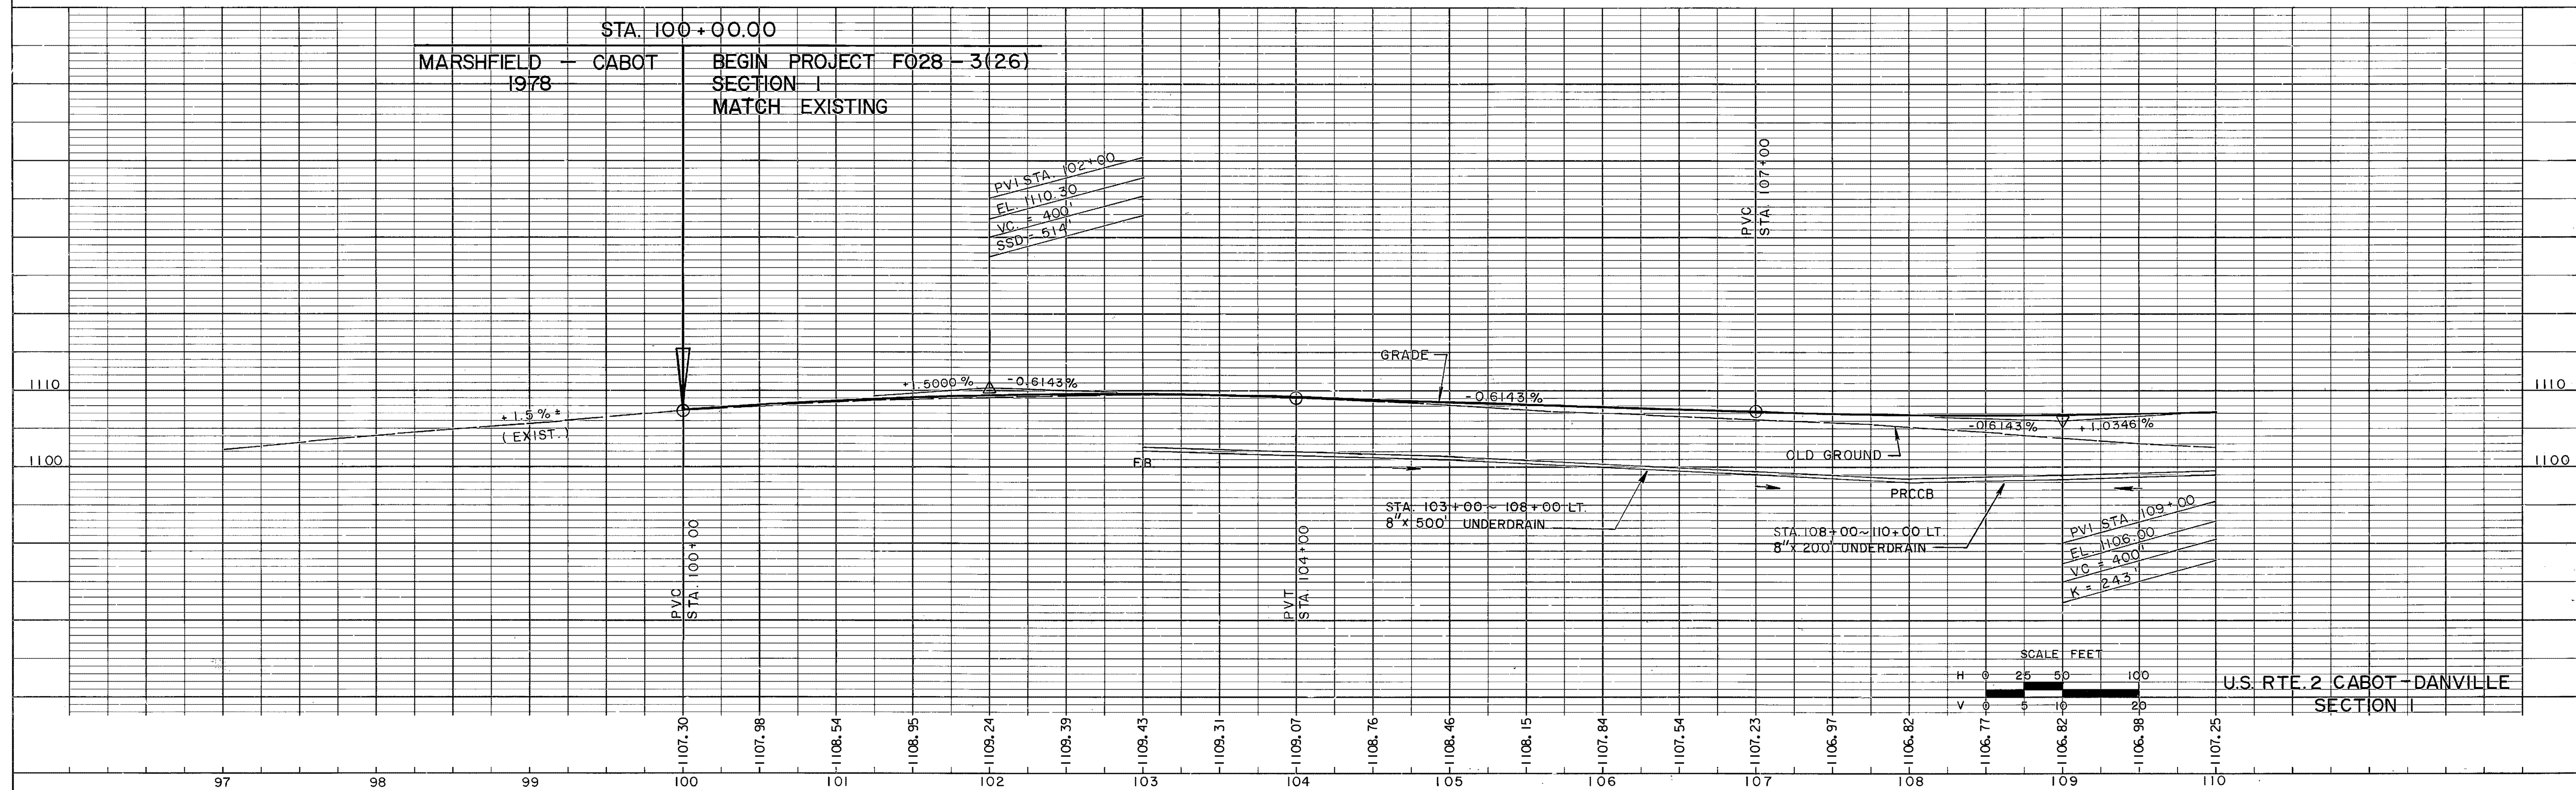


PLATE 1 PLAN-PROFILE O. P. & R. E. STANDARD  
 DIETZGEN CORPORATION  
 PRINTED IN U.S.A.

PROJECT NAME: CABOT-DANVILLE  
 PROJECT NUMBER: FECC F 028-3(26) C/1

FILE NAME: d78d058frm.dgn  
 PROJECT LEADER: K. ROBBIE  
 DESIGNED BY: I. SHEA  
 PROFILE SHEET 1

PLOT DATE: 13-OCT-2010  
 DRAWN BY: I. SHEA  
 CHECKED BY: S. MENARD  
 SHEET 34 OF 250