

PLAN	DATE
	BY
NOTE BOOK	NO.
	DATE

PROFILE	DATE
	BY
NOTE BOOK	NO.
	DATE

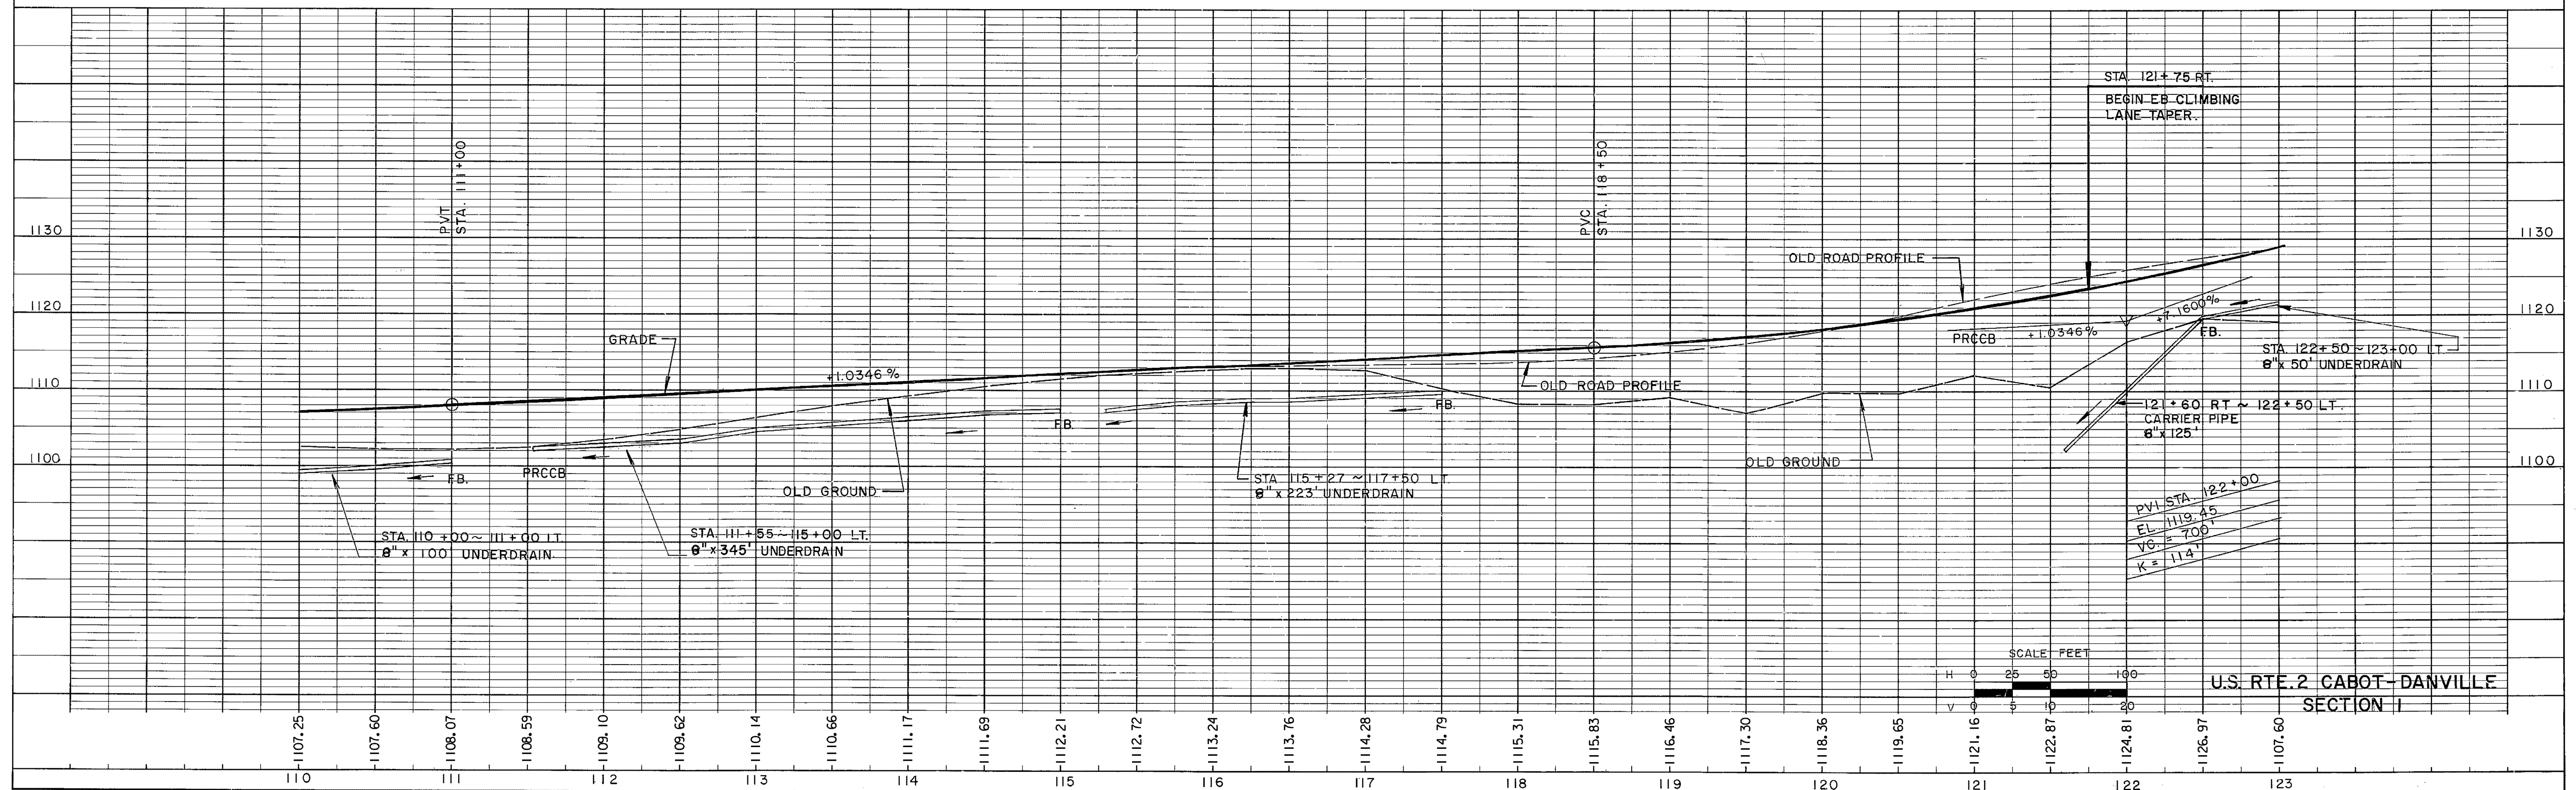


PLATE 1 PLAN-PROFILE C. P. & A. E. STANDARD

PROJECT NAME:	CABOT-DANVILLE
PROJECT NUMBER:	FECC F 028-3(26) C/1
FILE NAME:	d78d058frm.dgn
PROJECT LEADER:	K. ROBBIE
DESIGNED BY:	I. SHEA
PROFILE SHEET 2	
PLOT DATE:	13-OCT-2010
DRAWN BY:	I. SHEA
CHECKED BY:	S. MENARD
SHEET	36 OF 250