

DATE	
BY	
REVISION	
NO. DATE	
PLAN	
NOTE BOOK	
NO.	

DATE	
BY	
REVISION	
NO. DATE	
PROFILE	
NOTE BOOK	
NO.	

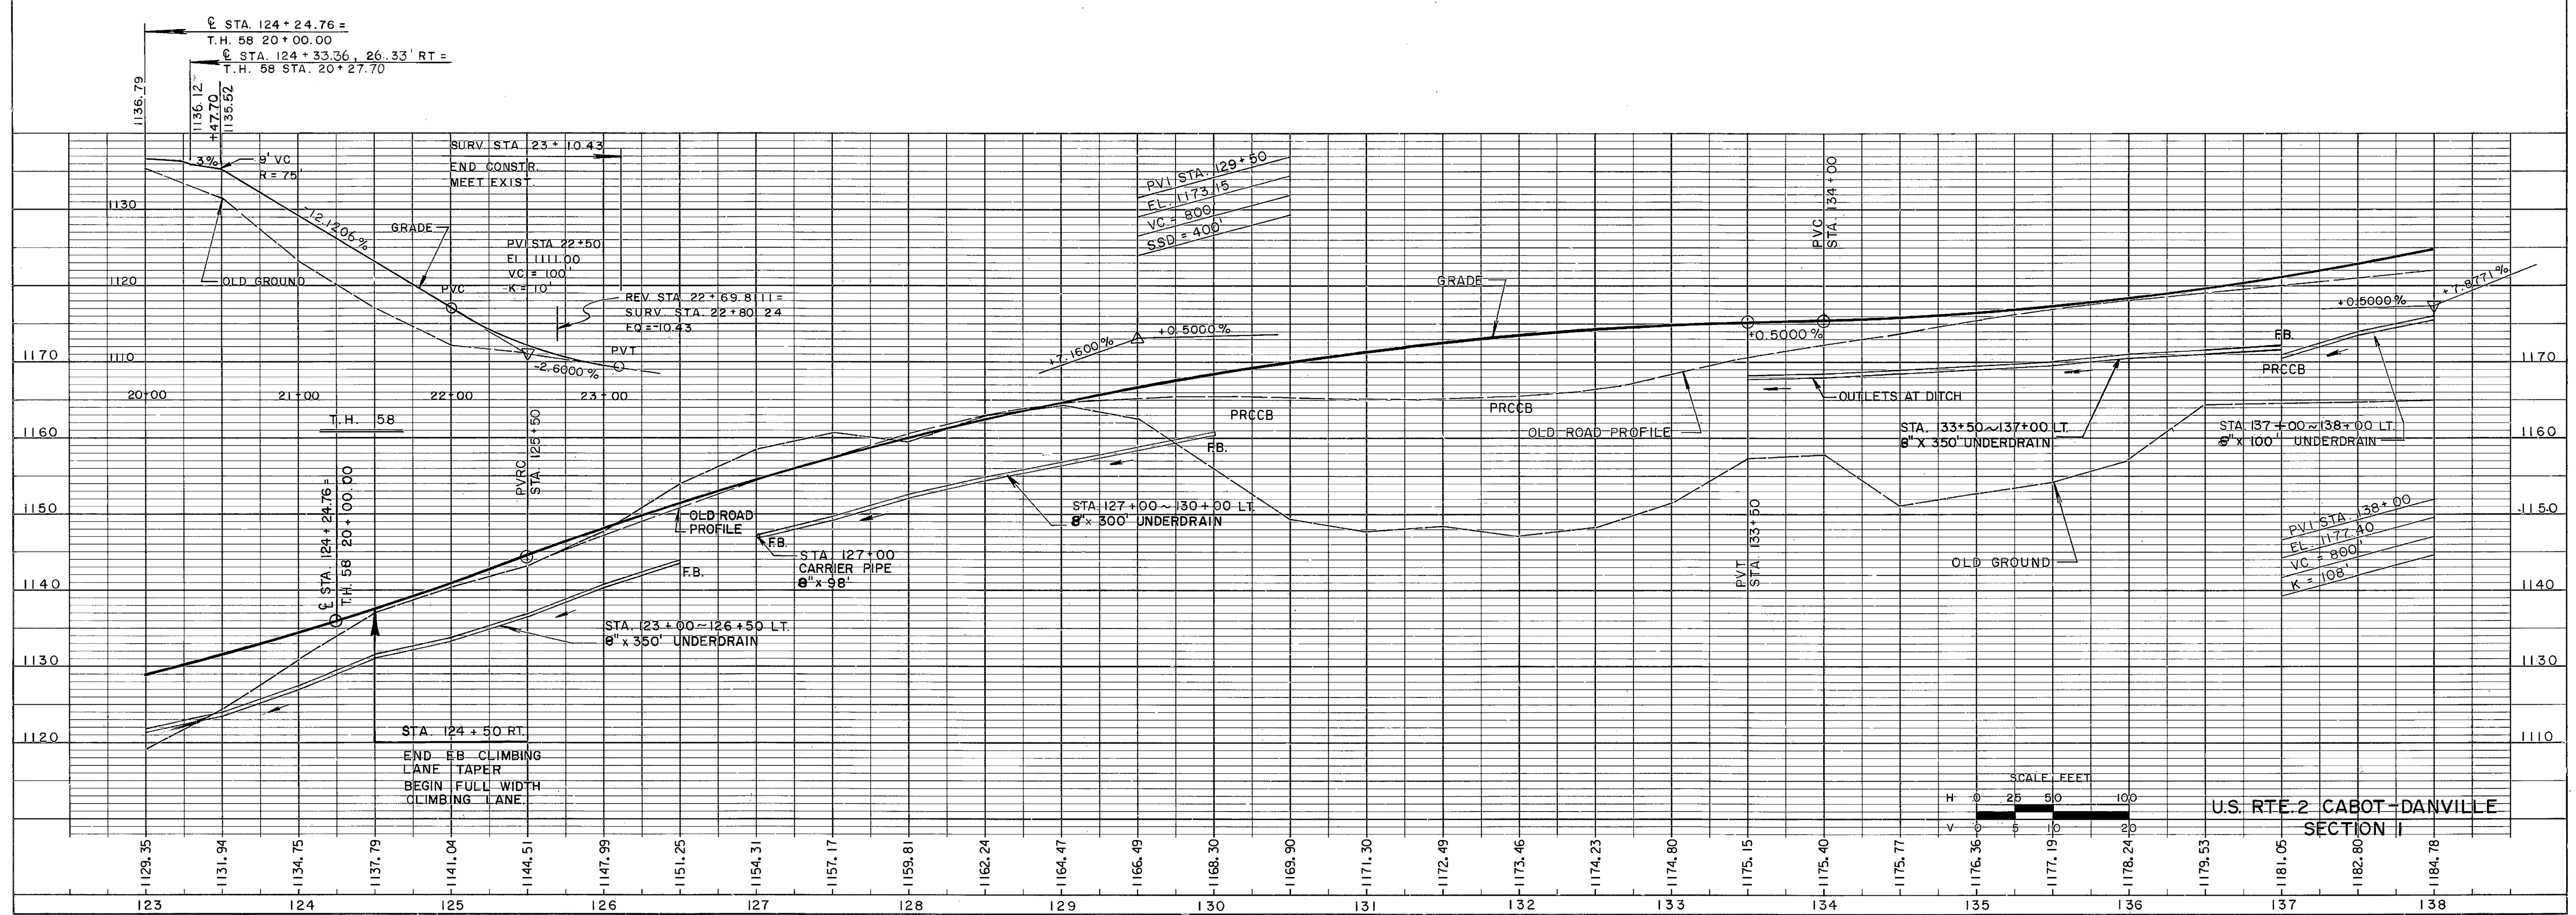


PLATE 1 PLAN-PROFILE O. P. & S. E. STANDARD
DIETZGEN CORPORATION
PRINTED IN U.S.A.

PROJECT NAME:	CABOT-DANVILLE
PROJECT NUMBER:	FEGC F 028-3(26) C/1
FILE NAME:	d78d058frm.dgn
PROJECT LEADER:	K. ROBBIE
DESIGNED BY:	I. SHEA
PROFILE SHEET 3	
PLOT DATE:	13-OCT-2010
DRAWN BY:	I. SHEA
CHECKED BY:	S. MENARD
SHEET	38 OF 250