

DATE	
BY	
REVISIONS	
NO.	
DATE	
BY	
REVISIONS	
NO.	
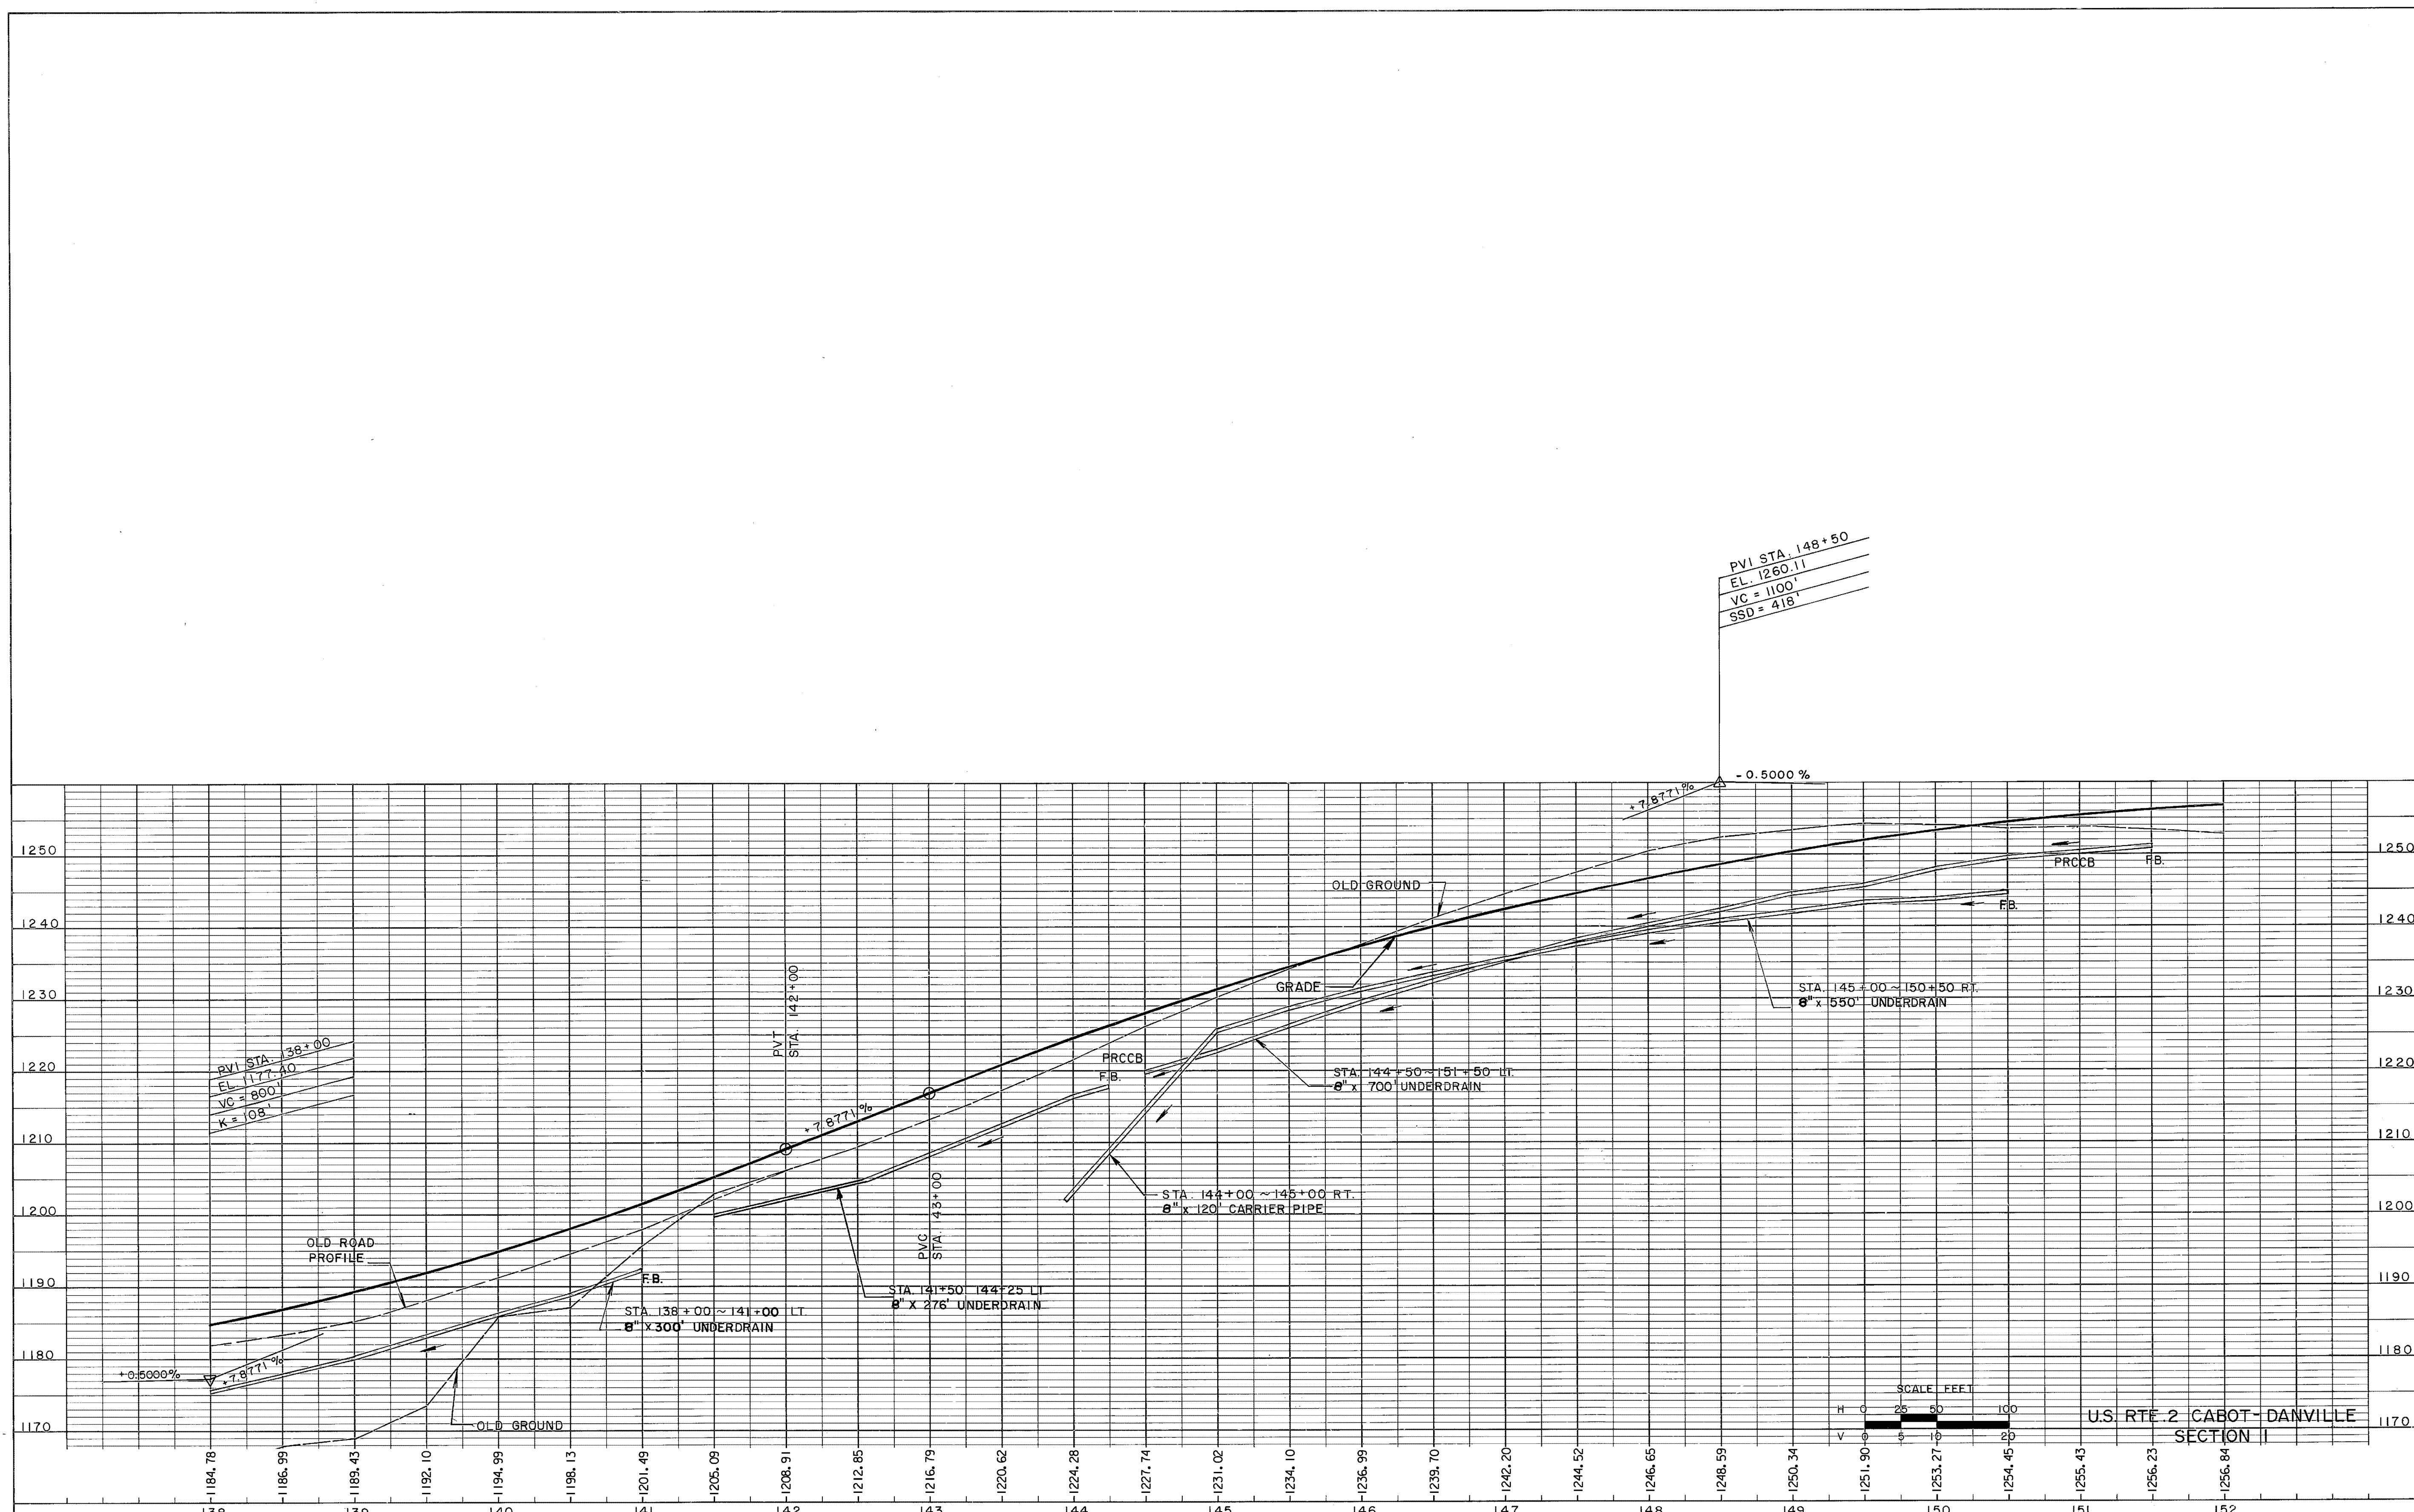


PLATE 1 PLAN-PROFILE D. P. S. & S. E. STANDARD
 DETZEN CORPORATION
 PRINTED IN U.S.A.

PROJECT NAME: CABOT-DANVILLE
 PROJECT NUMBER: FECC F 028-3(26) C/1
 FILE NAME: d78d058frm.dgn
 PROJECT LEADER: K. ROBBIE
 DESIGNED BY: I. SHEA
 PROFILE SHEET 4
 PLOT DATE: 07-DEC-2010
 DRAWN BY: I. SHEA
 CHECKED BY: S. MENARD
 SHEET 40 OF 250