
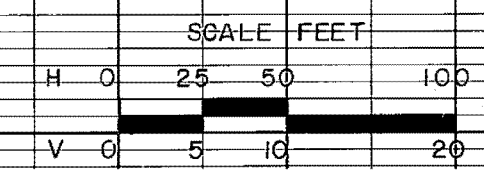


DATE	
BY	
REVISIONS	
NO.	
DATE	
BY	
REVISIONS	
NO.	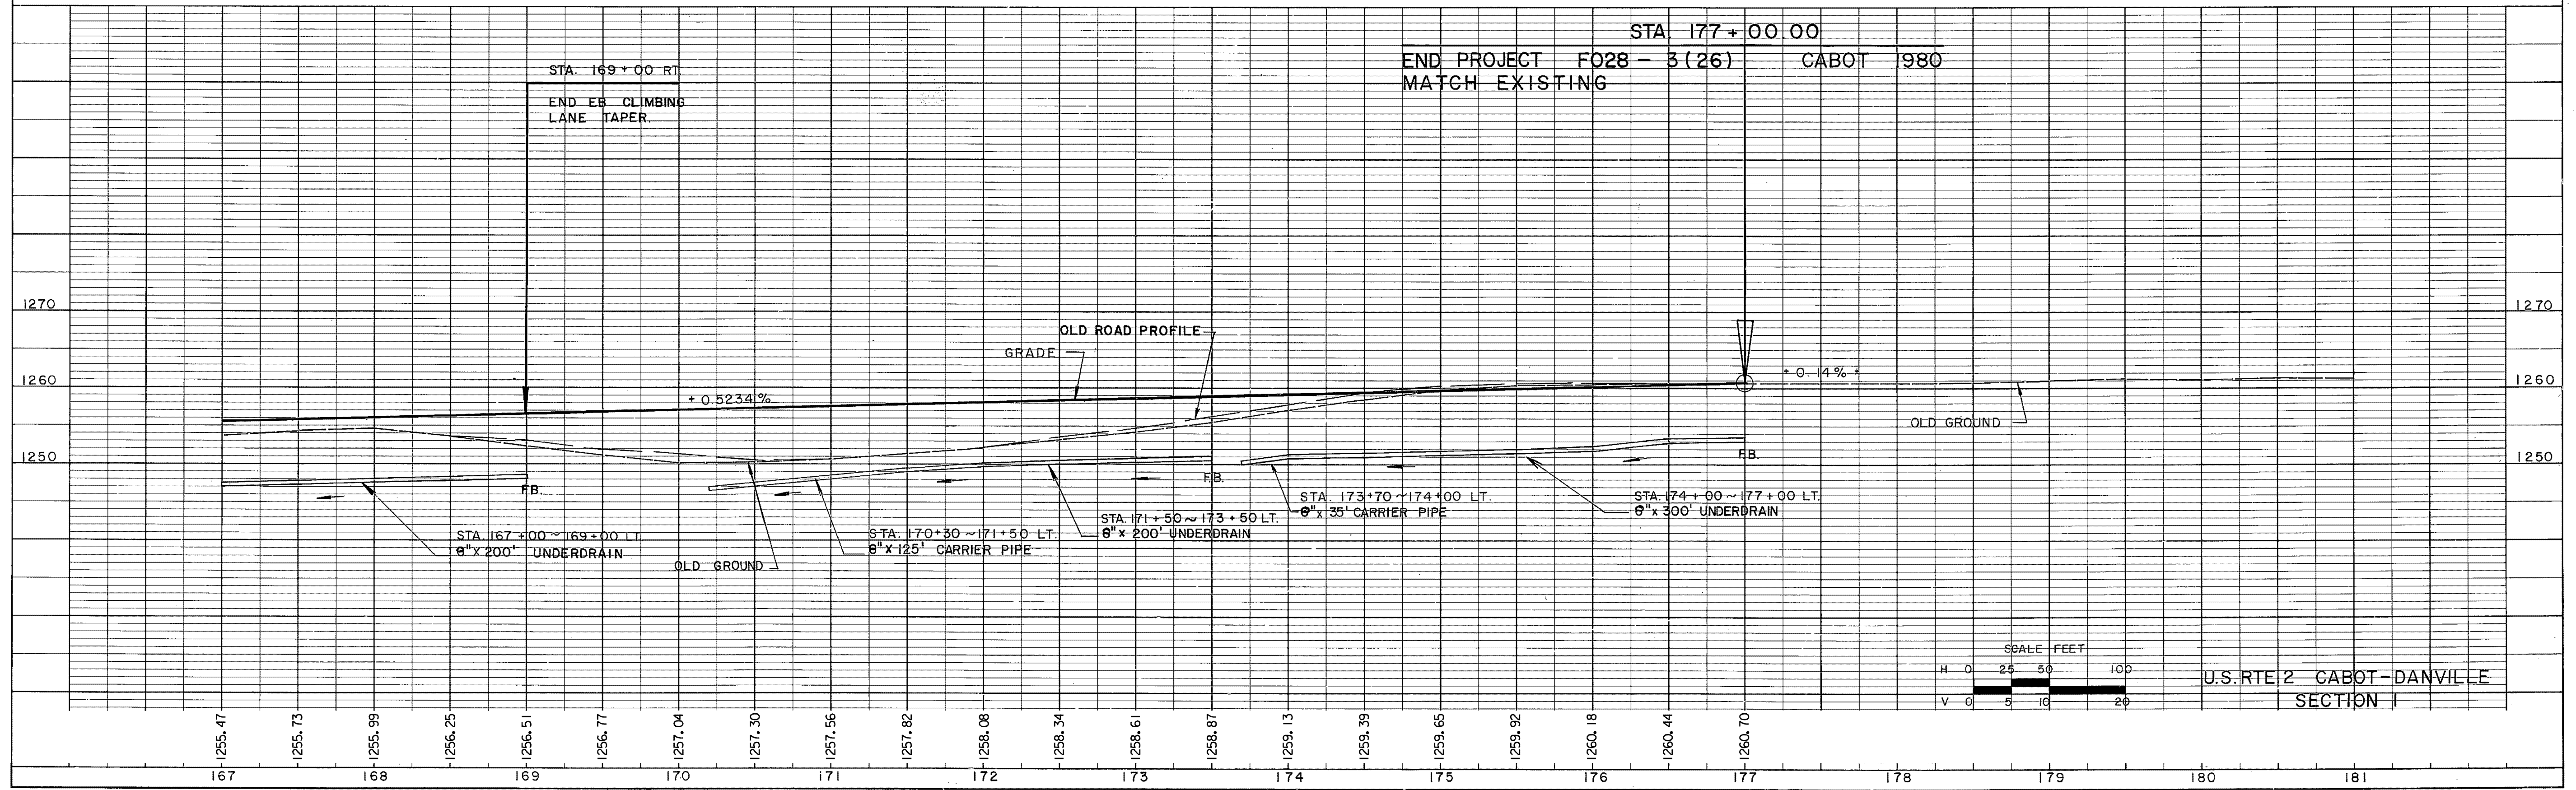
U.S. RTE 2 CABOT-DANVILLE
SECTION I

PLATE 1 PLAN-PROFILE O. P. R. A. E. STANDARD

PROJECT NAME:	CABOT-DANVILLE	PLOT DATE:	13-OCT-2010
PROJECT NUMBER:	FEGC F 028-3(26) C/1	DRAWN BY:	I. SHEA
FILE NAME:	d78d058frm.dgn	CHECKED BY:	S. MENARD
PROJECT LEADER:	K. ROBIE	SHEET	44 OF 250
DESIGNED BY:	I. SHEA		
PROFILE SHEET	6		