


U.S. ROUTE 2  
CABOT-DANVILLE  
F028 - 3(26)

SECTION 1


DATE	
BY	
REVISION	
NO.	
DATE	
BY	
REVISION	
NO.	

DATE	4/84
BY	VT SURVEY CONSULTANTS
REVISION	4/86
NO.	
DATE	
BY	
REVISION	
NO.	

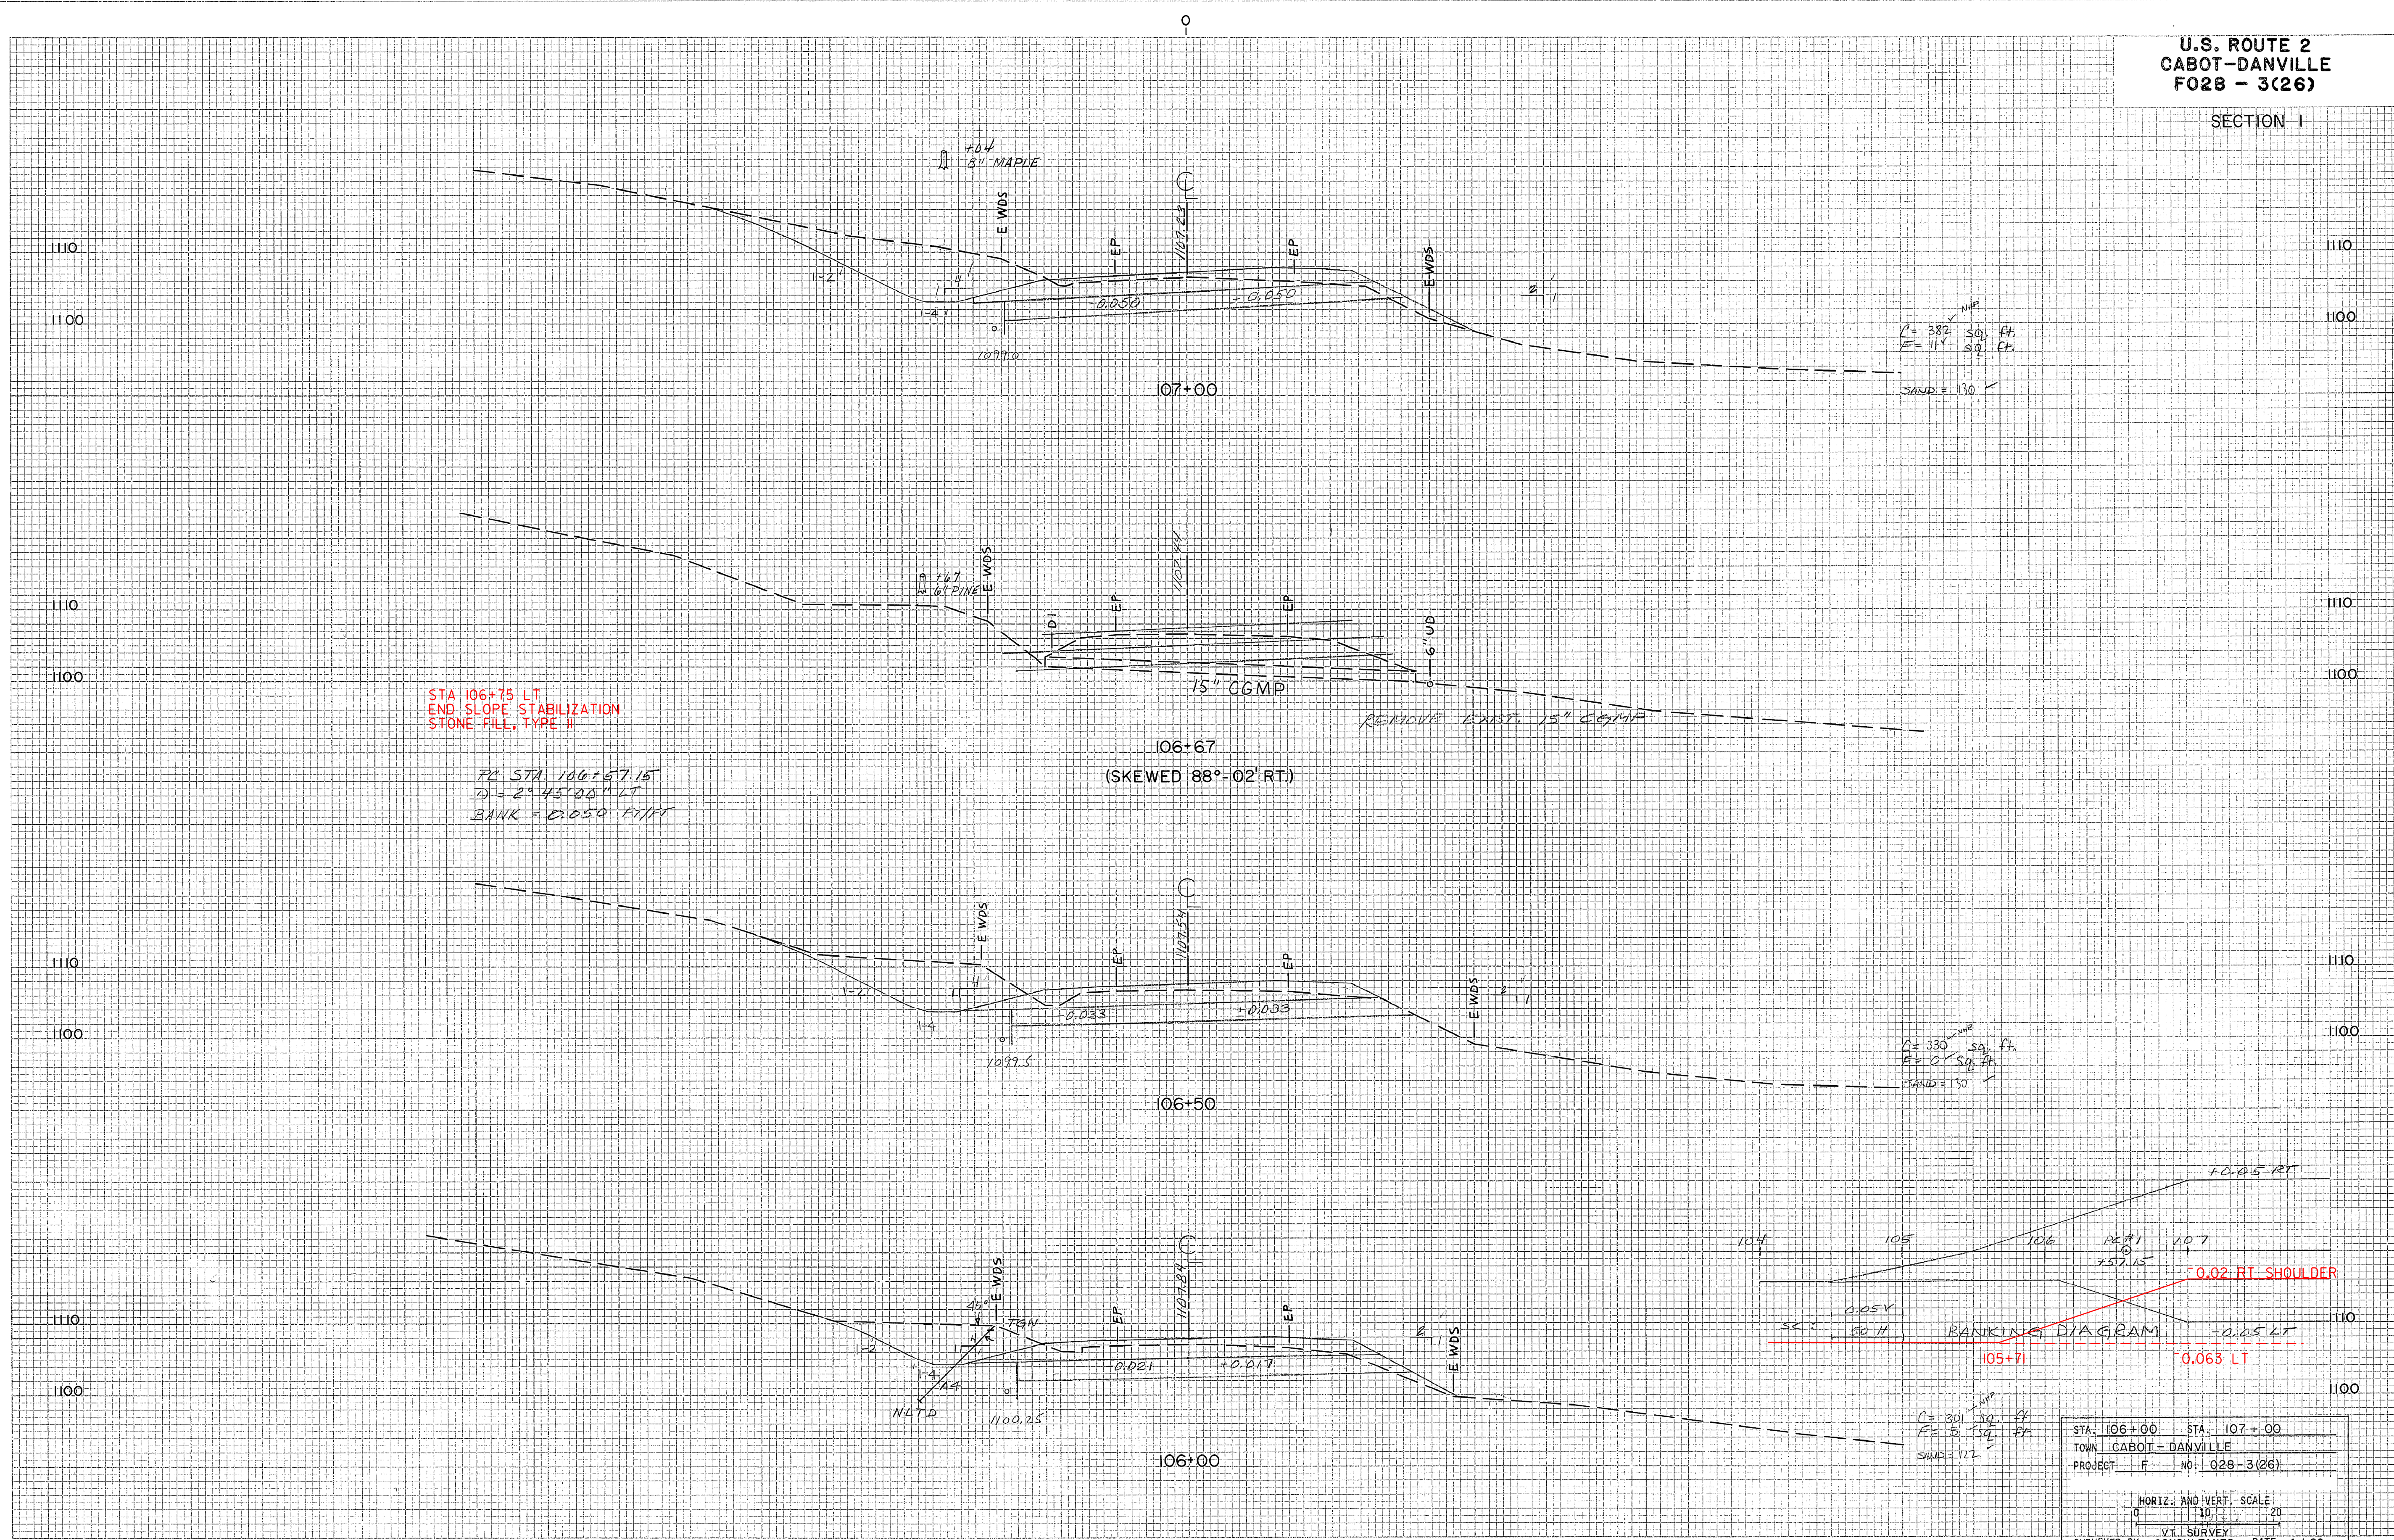

STA 106+75 LT  
END SLOPE STABILIZATION  
STONE FILL, TYPE II

PC STA 106+57.16  
D = 2° 45' 00" LT  
BANK = 0.050 F/11F

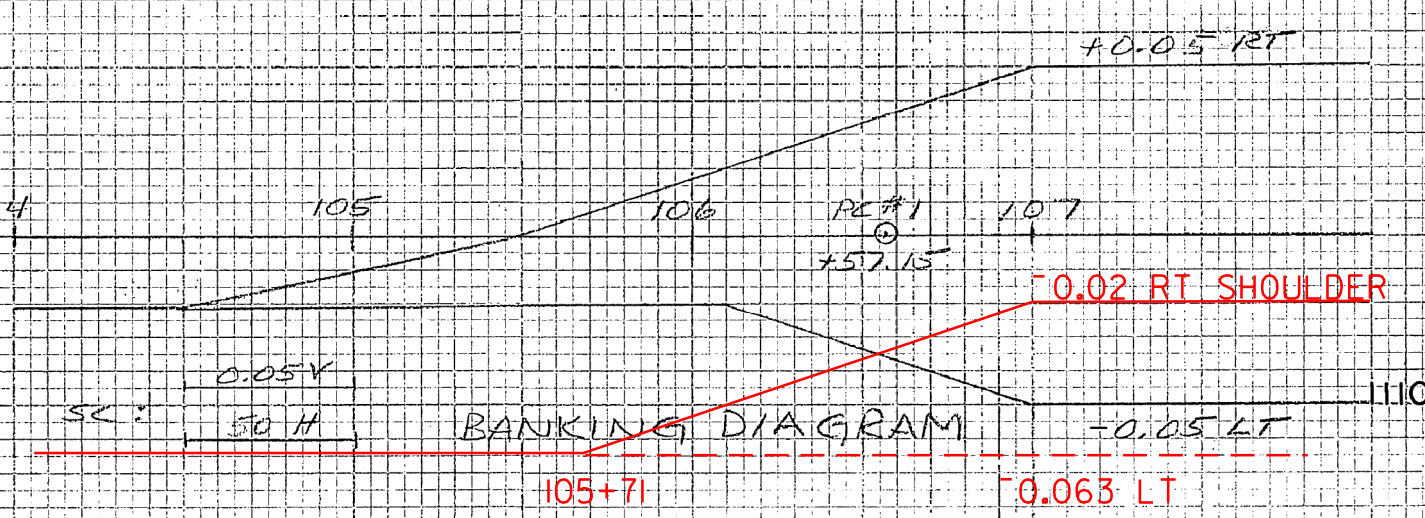

STA. 106+00	STA. 107+00
TOWN CABOT-DANVILLE	
PROJECT F NO. 028-3(26)	
HORIZ. AND VERT. SCALE	
0	10 20
VT. SURVEY	
SURVEYED BY: CONSULTANTS DATE 4/86	

PLATE 3 CROSS SECTION C.F.R.S. STANDARD  
DATE 12/10/01

PROJECT NAME:	CABOT-DANVILLE	PLOT DATE:	06-OCT-2010
PROJECT NUMBER:	FEGC F 028-3(26) C/1	DRAWN BY:	I. SHEA
FILE NAME:	78d058xs.dgn	CHECKED BY:	S. MENARD
PROJECT LEADER:	K. ROBBIE	SHEET	137 OF 250
DESIGNED BY:	I. SHEA		
MAINLINE CROSS SECTIONS 5			