


U.S. ROUTE 2  
CABOT-DANVILLE  
F028 - 3(26)

SECTION 1

DATE	
BY	
CHECKED	
DESIGNED	
APPROVED	
NO.	

DATE	
BY	
CHECKED	
DESIGNED	
APPROVED	
NO.	

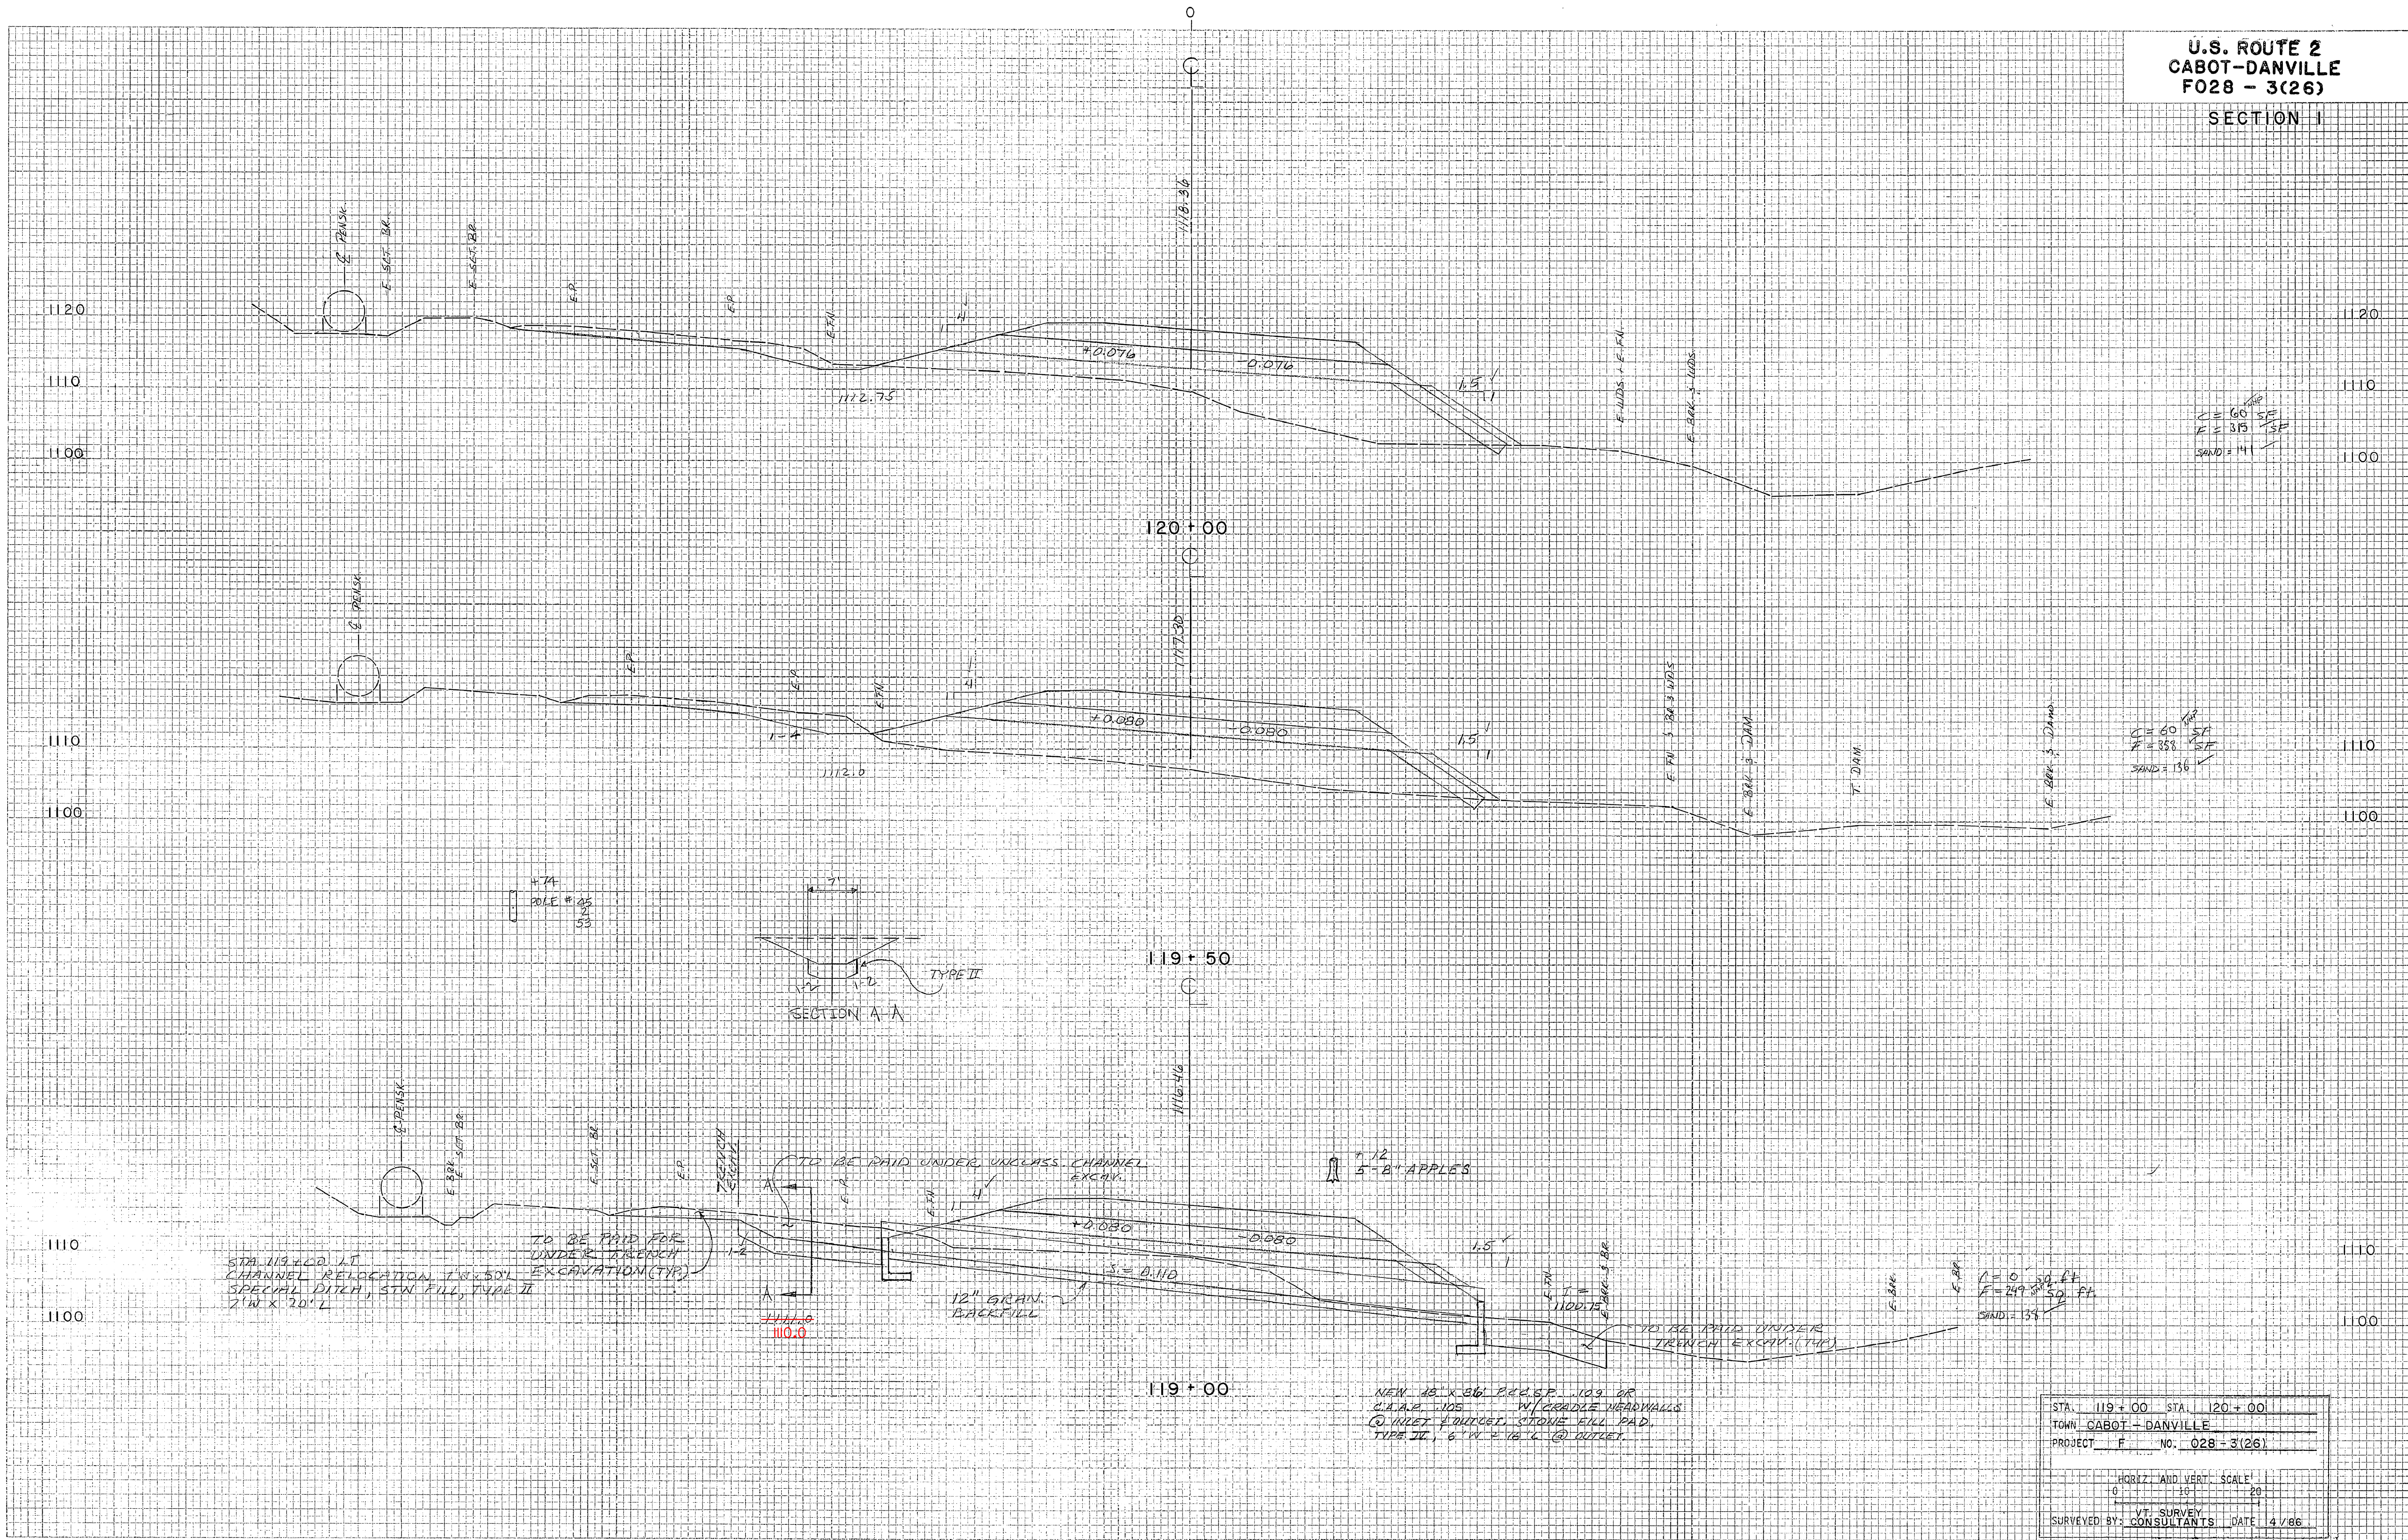

C = 60 SF  
F = 315 SF  
SAND = 14'

C = 60 SF  
F = 338 SF  
SAND = 136'

C = 10 SF  
F = 249 SF  
SAND = 35'

STA.	119+00	STA.	120+00
TOWN	CABOT - DANVILLE		
PROJECT	F NO. 028 - 3(26)		
HORIZ. AND VERT. SCALE			
1" = 10'		1" = 20'	
V.T. SURVEY			
SURVEYED BY: CONSULTANTS		DATE 4/86	

PLATE 3 CROSS SECTION 3, P. 3, 4 & 5, STANDARD  
MICHIGAN CORPORATION

PROJECT NAME:	CABOT-DANVILLE	PLOT DATE:	06-OCT-2010
PROJECT NUMBER:	FEGC F 028-3(26) C/1	DRAWN BY:	I. SHEA
FILE NAME:	78d058xs.dgn	CHECKED BY:	S. MENARD
PROJECT LEADER:	K. ROBBE	SHEET	146 OF 250
DESIGNED BY:	I. SHEA		
MAINLINE CROSS SECTIONS 14			