

**U.S. ROUTE 2  
CABOT-DANVILLE  
F028 - 3(26)**

**SECTION 1**

DATE	
BY	
REVISION	
NO.	
DATE	
BY	
REVISION	
NO.	

DATE	4/86
BY	I. SHEA
REVISION	
NO.	
DATE	
BY	
REVISION	
NO.	

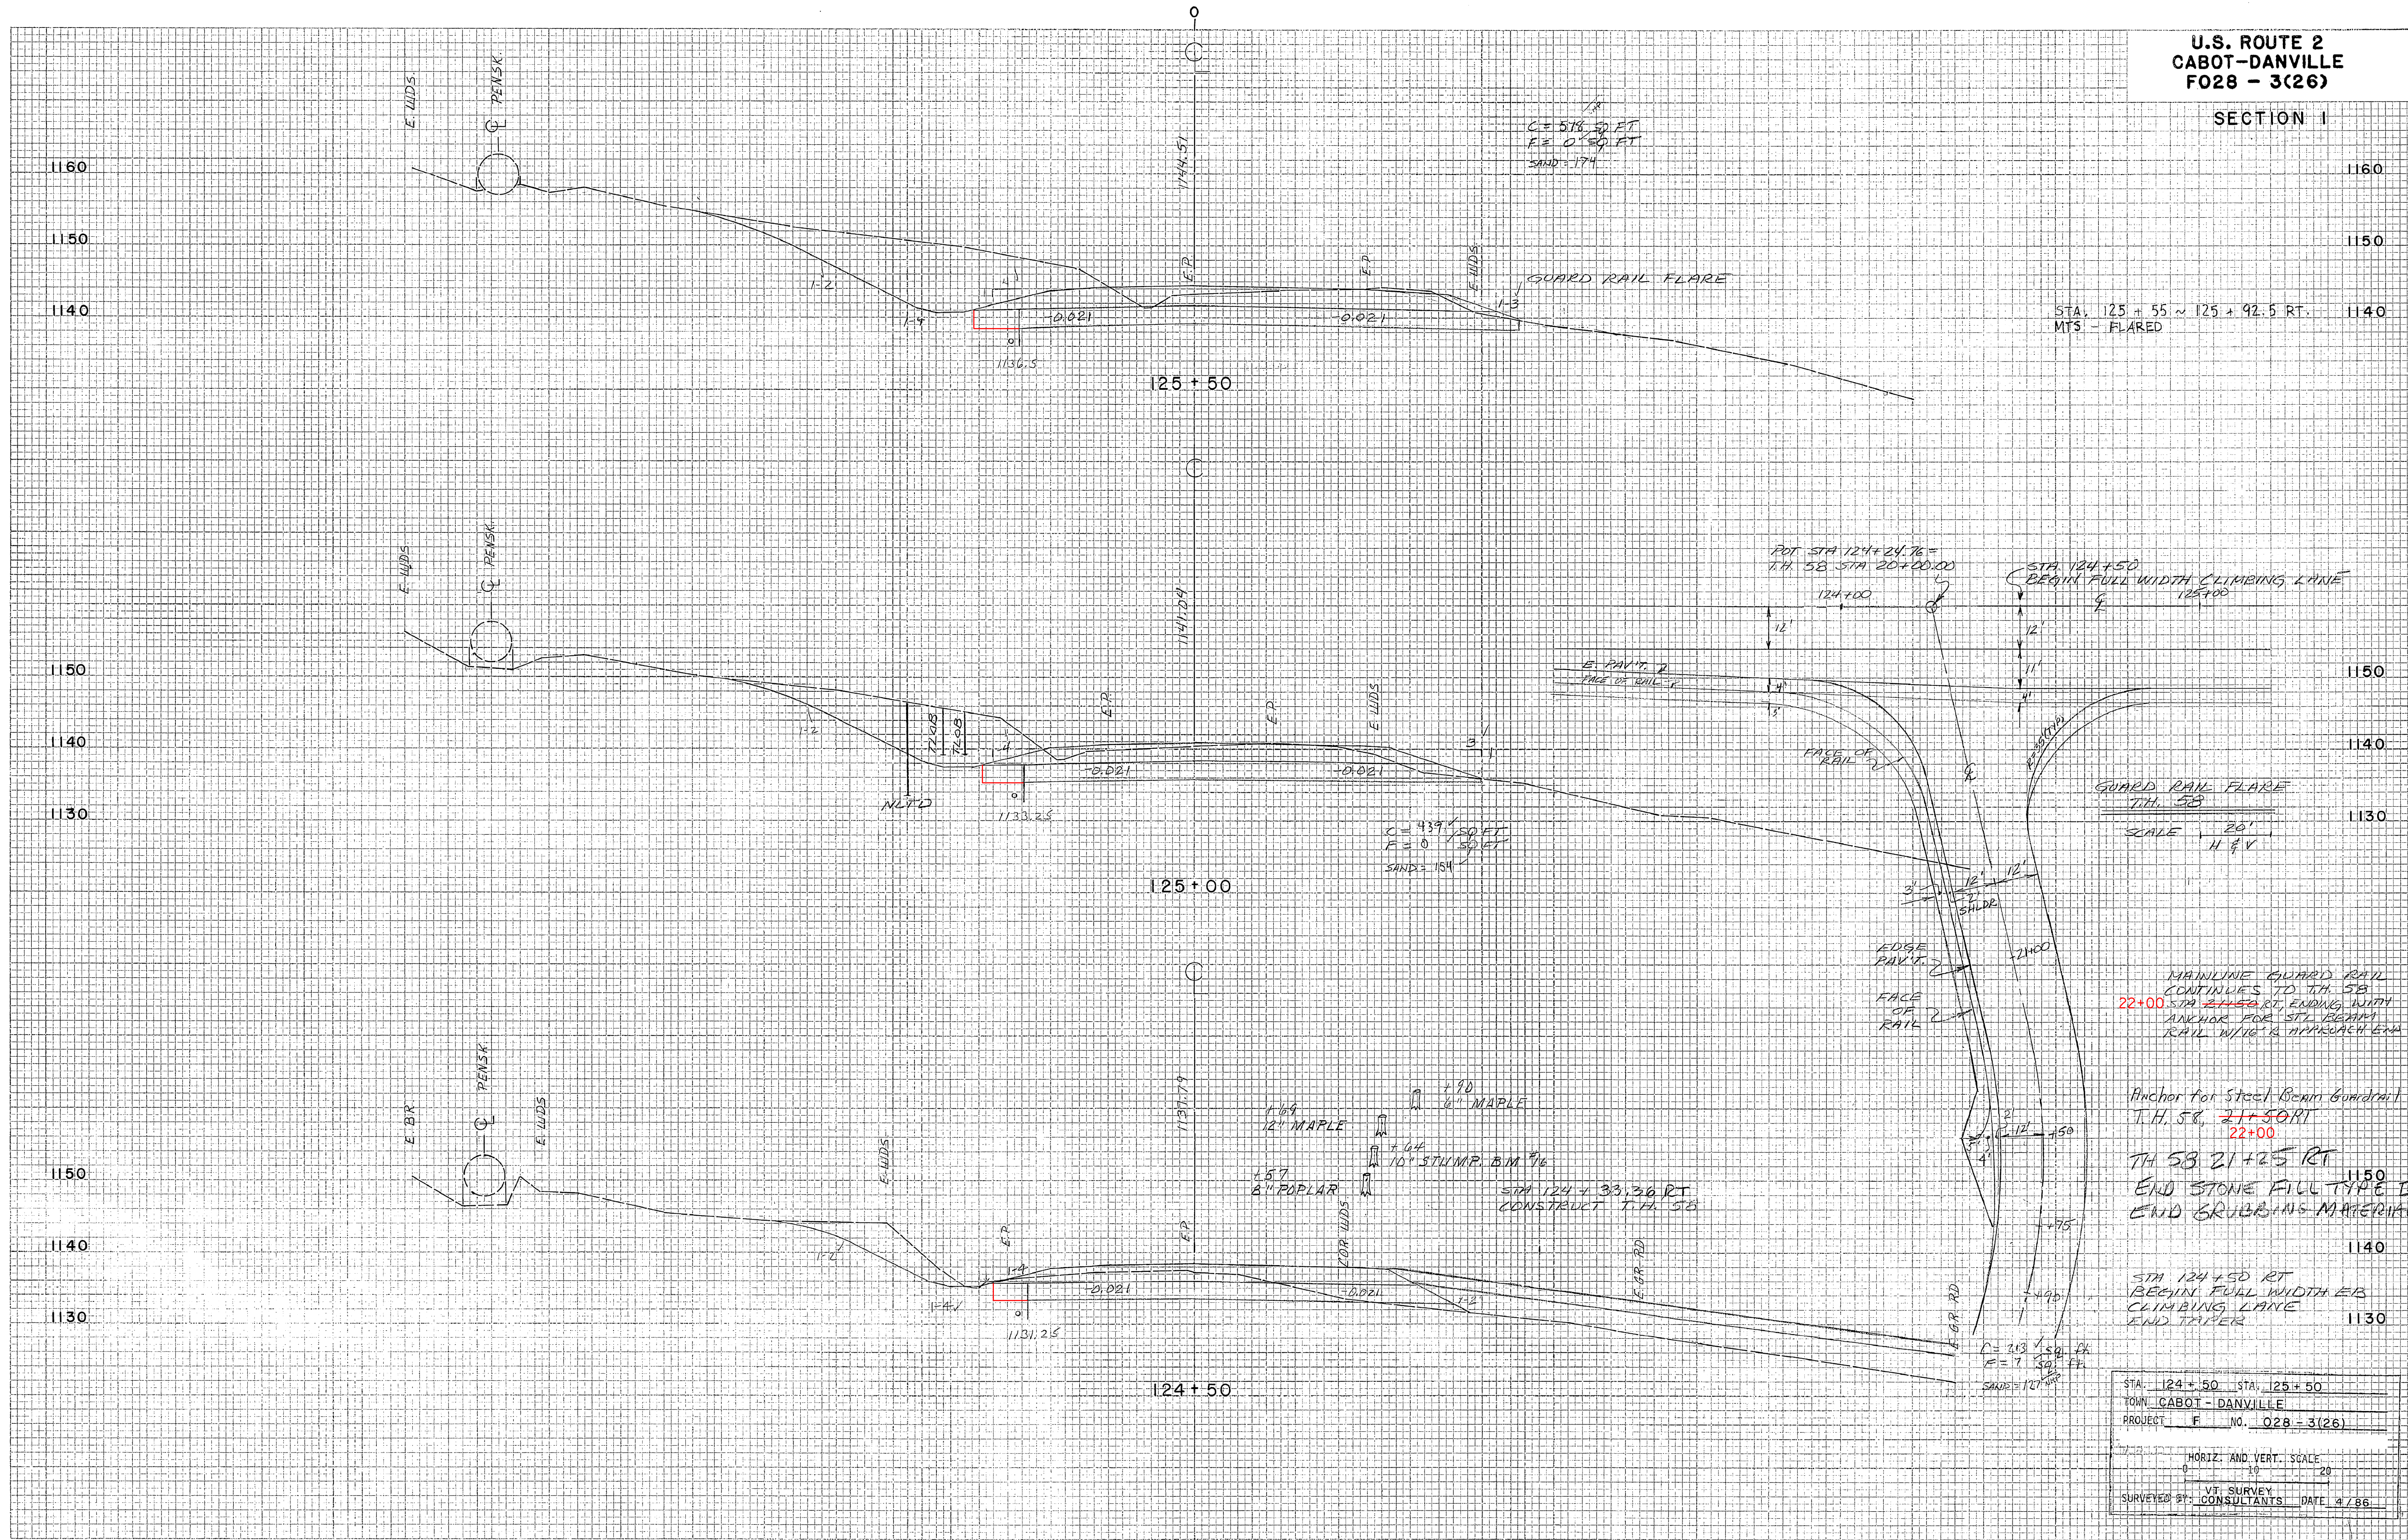


PLATE 3 CROSS SECTION O.P.R.E.S. STANDARD  
BENTON CORPORATION

PROJECT NAME:	CABOT-DANVILLE
PROJECT NUMBER:	FEGC F 028-3(26) C/1
FILE NAME:	78d058xs.dgn
PROJECT LEADER:	K. ROBBE
DESIGNED BY:	I. SHEA
MAINLINE CROSS SECTIONS 19	
PLOT DATE:	06-OCT-2010
DRAWN BY:	I. SHEA
CHECKED BY:	S. MENARD
SHEET	151 OF 250