


**U.S. ROUTE 2
CABOT-DANVILLE
FO28 - 3(26)**

SECTION 1

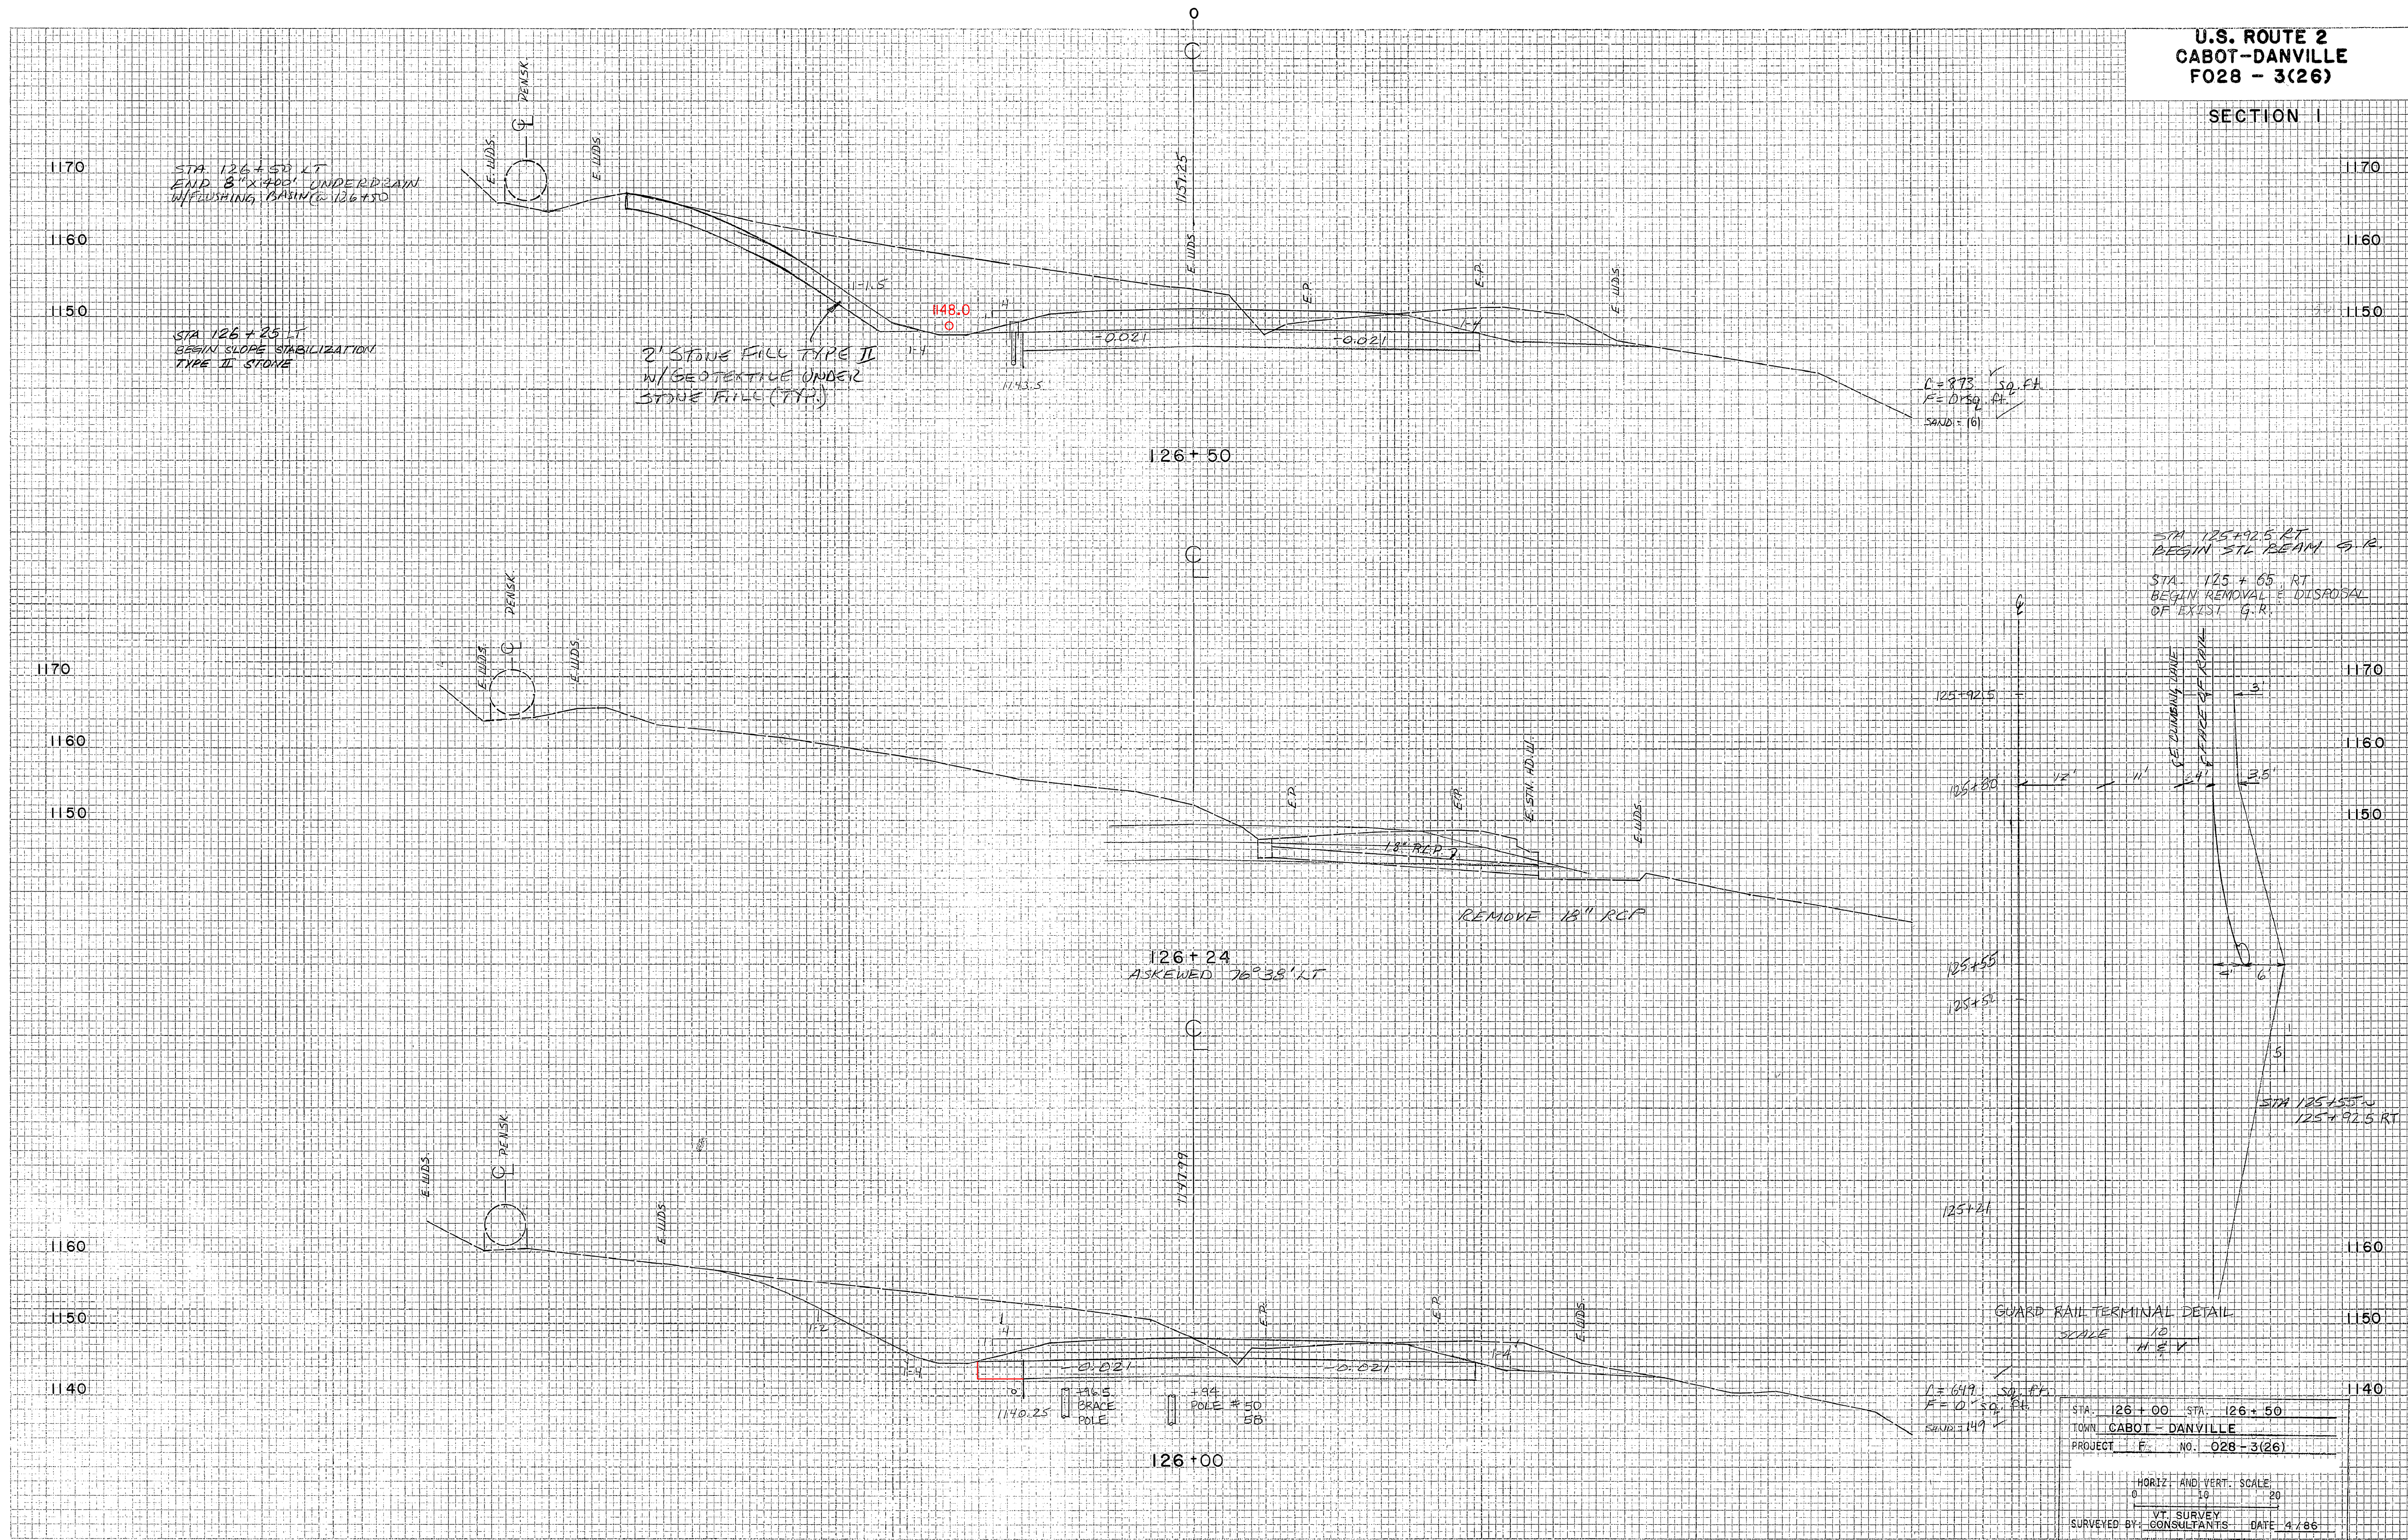

FIELD SURVEY
NOTE BOOK
NO. _____
DATE _____

CONSULTANT SURVEY
NOTE BOOK
NO. _____
DATE _____

STA 125+92.5 RT
BEGIN STL BEAM 5' R.
STA 125+65 RT
BEGIN REMOVAL & DISPOSAL
OF EXIST. G.R.

GUARD RAIL TERMINAL DETAIL
SCALE 10'
H 2' V 1'

STA 126+00	STA 126+50
TOWN CABOT-DANVILLE	
PROJECT F. NO. 028-3(26)	
HORIZ. AND VERT. SCALE 1" = 20'	
VT. SURVEY CONSULTANTS DATE 4/86	

PLATE 3 CROSS SECTION 3, R. & T. S. STATE ST.
DITSON CORPORATION

PROJECT NAME: CABOT-DANVILLE
PROJECT NUMBER: FECC F 028-3(26) C/1
FILE NAME: 78d058xs.dgn PLOT DATE: 06-OCT-2010
PROJECT LEADER: K. ROBBE DRAWN BY: I. SHEA
DESIGNED BY: I. SHEA CHECKED BY: S. MENARD
MAINLINE CROSS SECTIONS 20 SHEET 152 OF 250