


U.S. ROUTE 2
CABOT-DANVILLE
F028 - 3(26)

SECTION 1

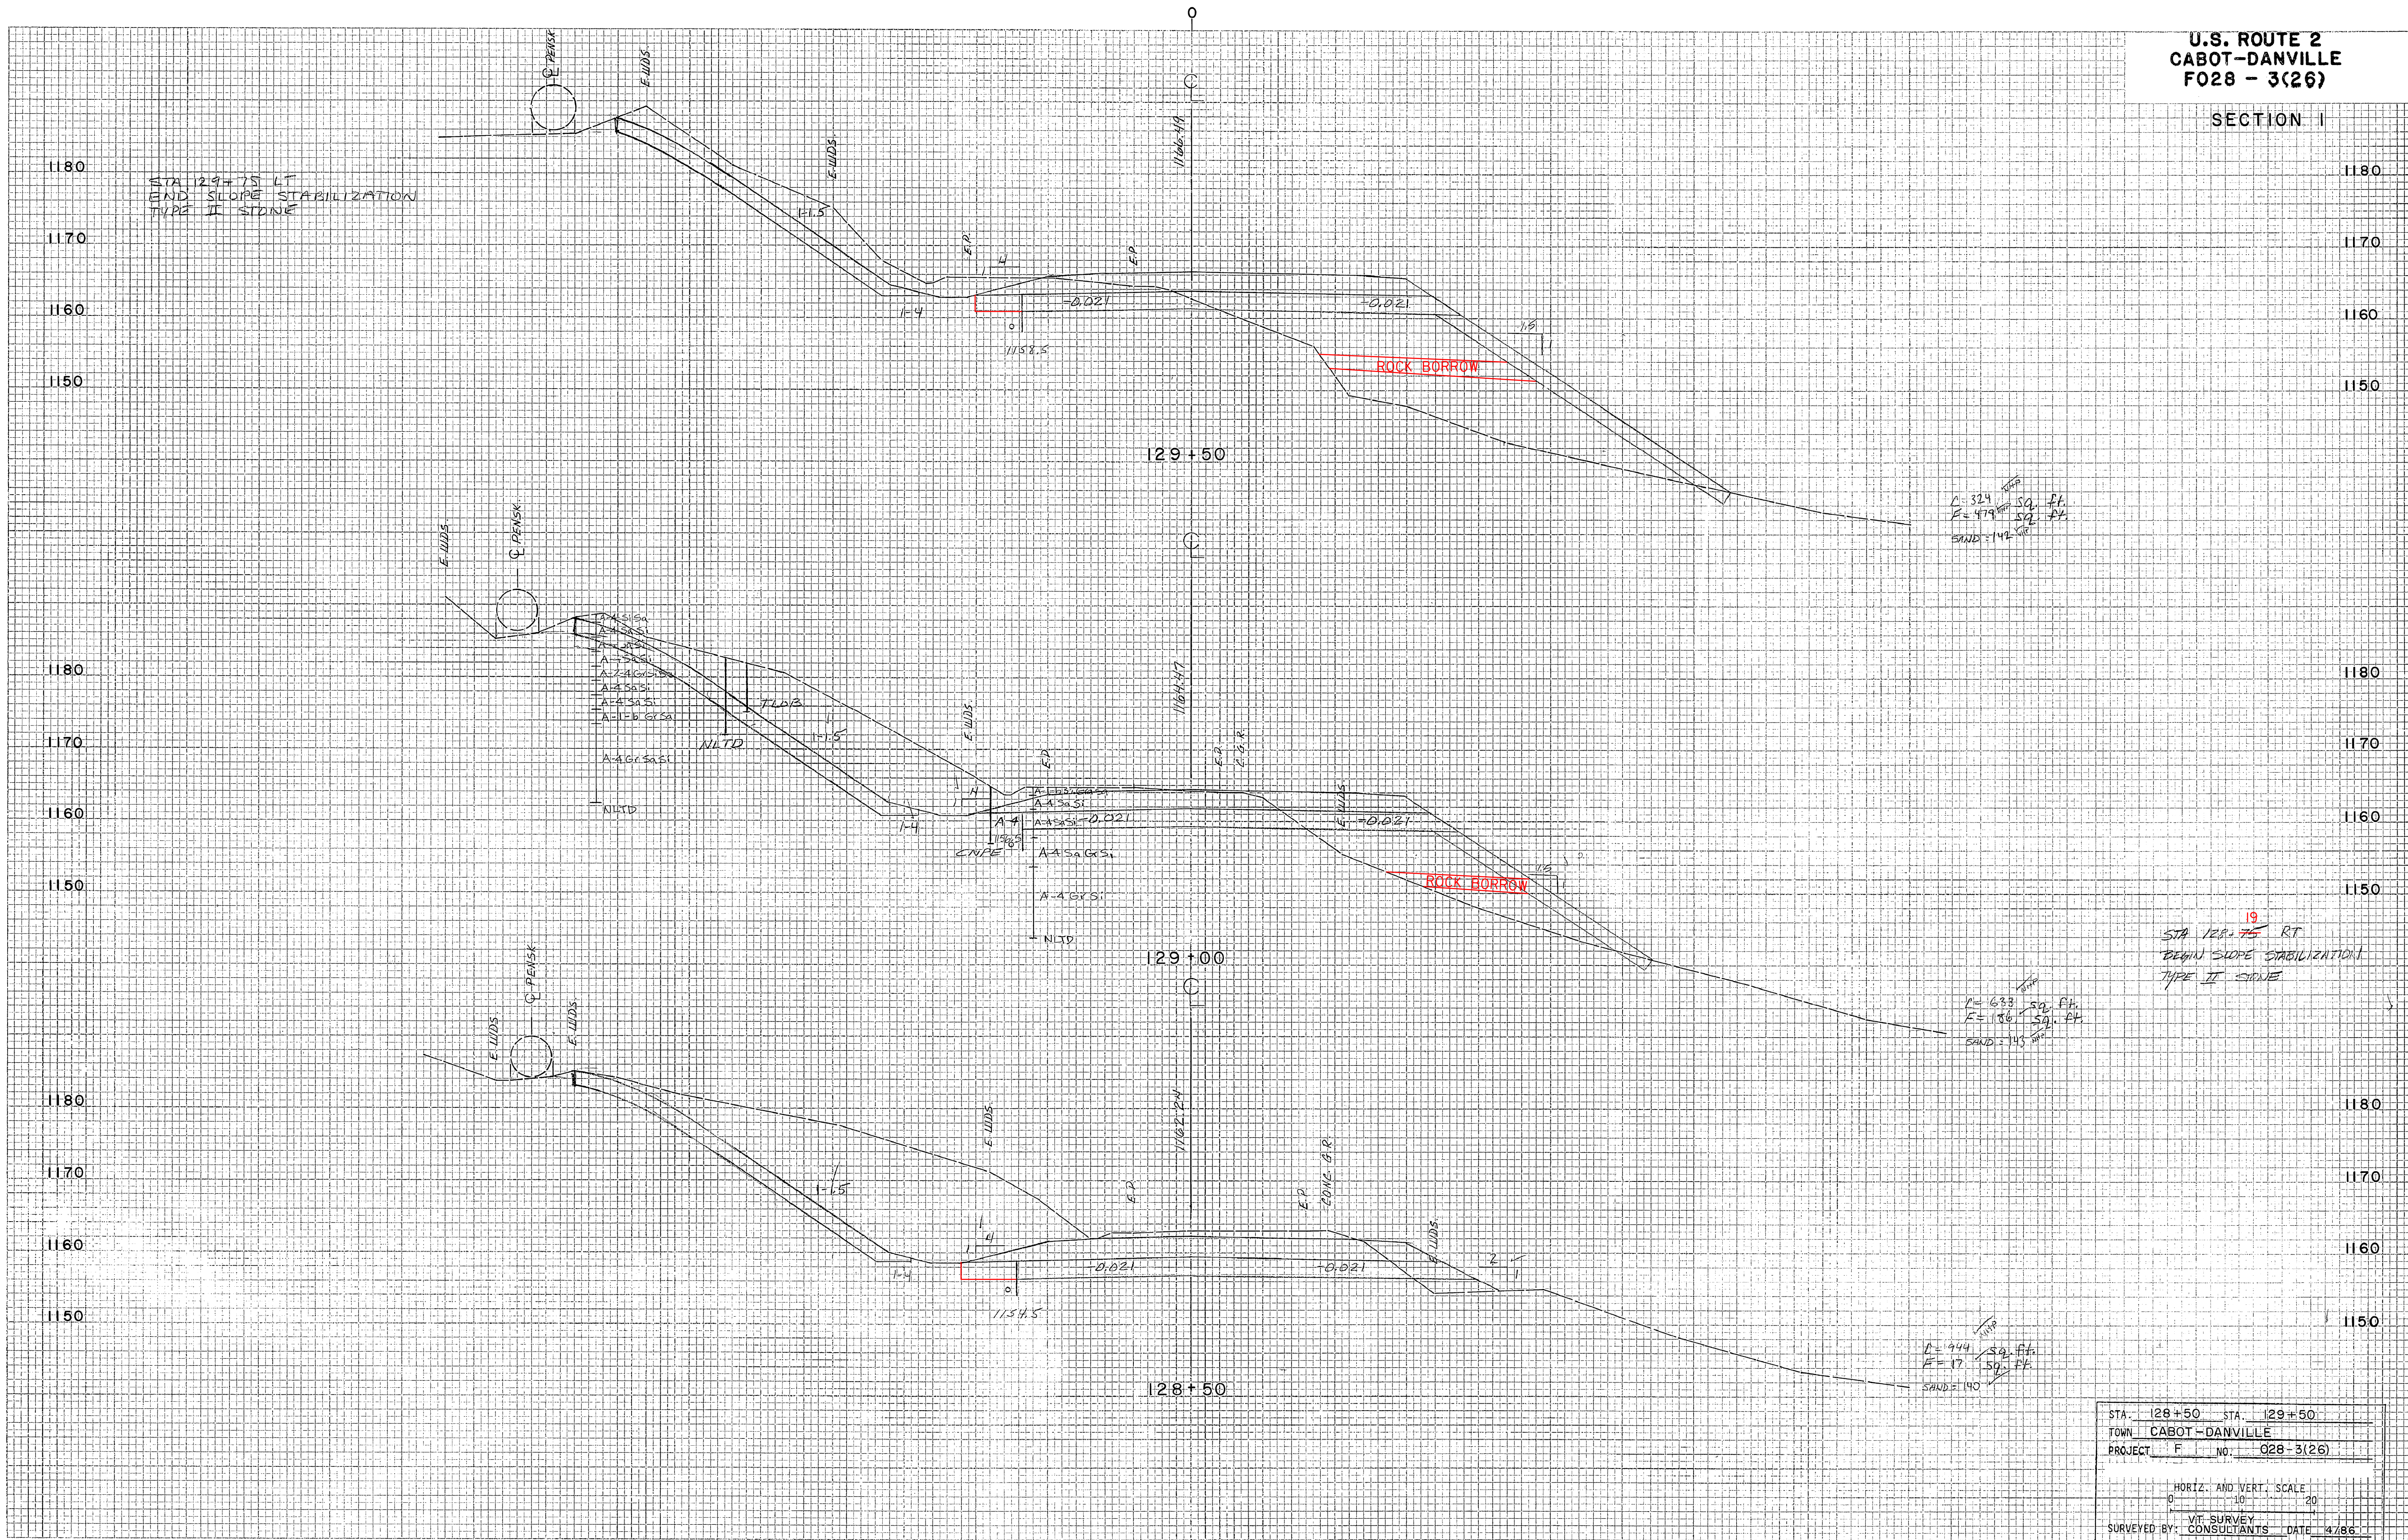

DATE: _____
BY: _____
REVIEWED: _____
SURVEYED: _____
NOTE BOOK: _____
NO. _____

DATE: 11/16/11
BY: I. SHEA
REVIEWED: _____
SURVEYED: _____
NOTE BOOK: _____
NO. _____

STA. 128+50	STA. 129+50
TOWN CABOT-DANVILLE	
PROJECT F NO. 028-3(26)	
HORIZ. AND VERT. SCALE 0 10 20	
SURVEYED BY: VIT SURVEY CONSULTANTS DATE 4/86	

PLATE 3 CROSS SECTION OF P. R. E. STANGARD
DET. CORPORATION

PROJECT NAME: CABOT-DANVILLE
PROJECT NUMBER: FECC F 028-3(26) C/1
FILE NAME: 78d058xs.dgn
PROJECT LEADER: K. ROBBE
DESIGNED BY: I. SHEA
MAINLINE CROSS SECTIONS 22
PLOT DATE: 06-OCT-2010
DRAWN BY: I. SHEA
CHECKED BY: S. MENARD
SHEET 154 OF 250