


U.S. ROUTE 2
CABOT-DANVILLE
FO28 - 3(26)

SECTION 1

ORIGINAL SURVEY
NOTE BOOK
NO. _____
DATE _____

ORIGINAL SURVEY
NOTE BOOK
NO. _____
DATE _____

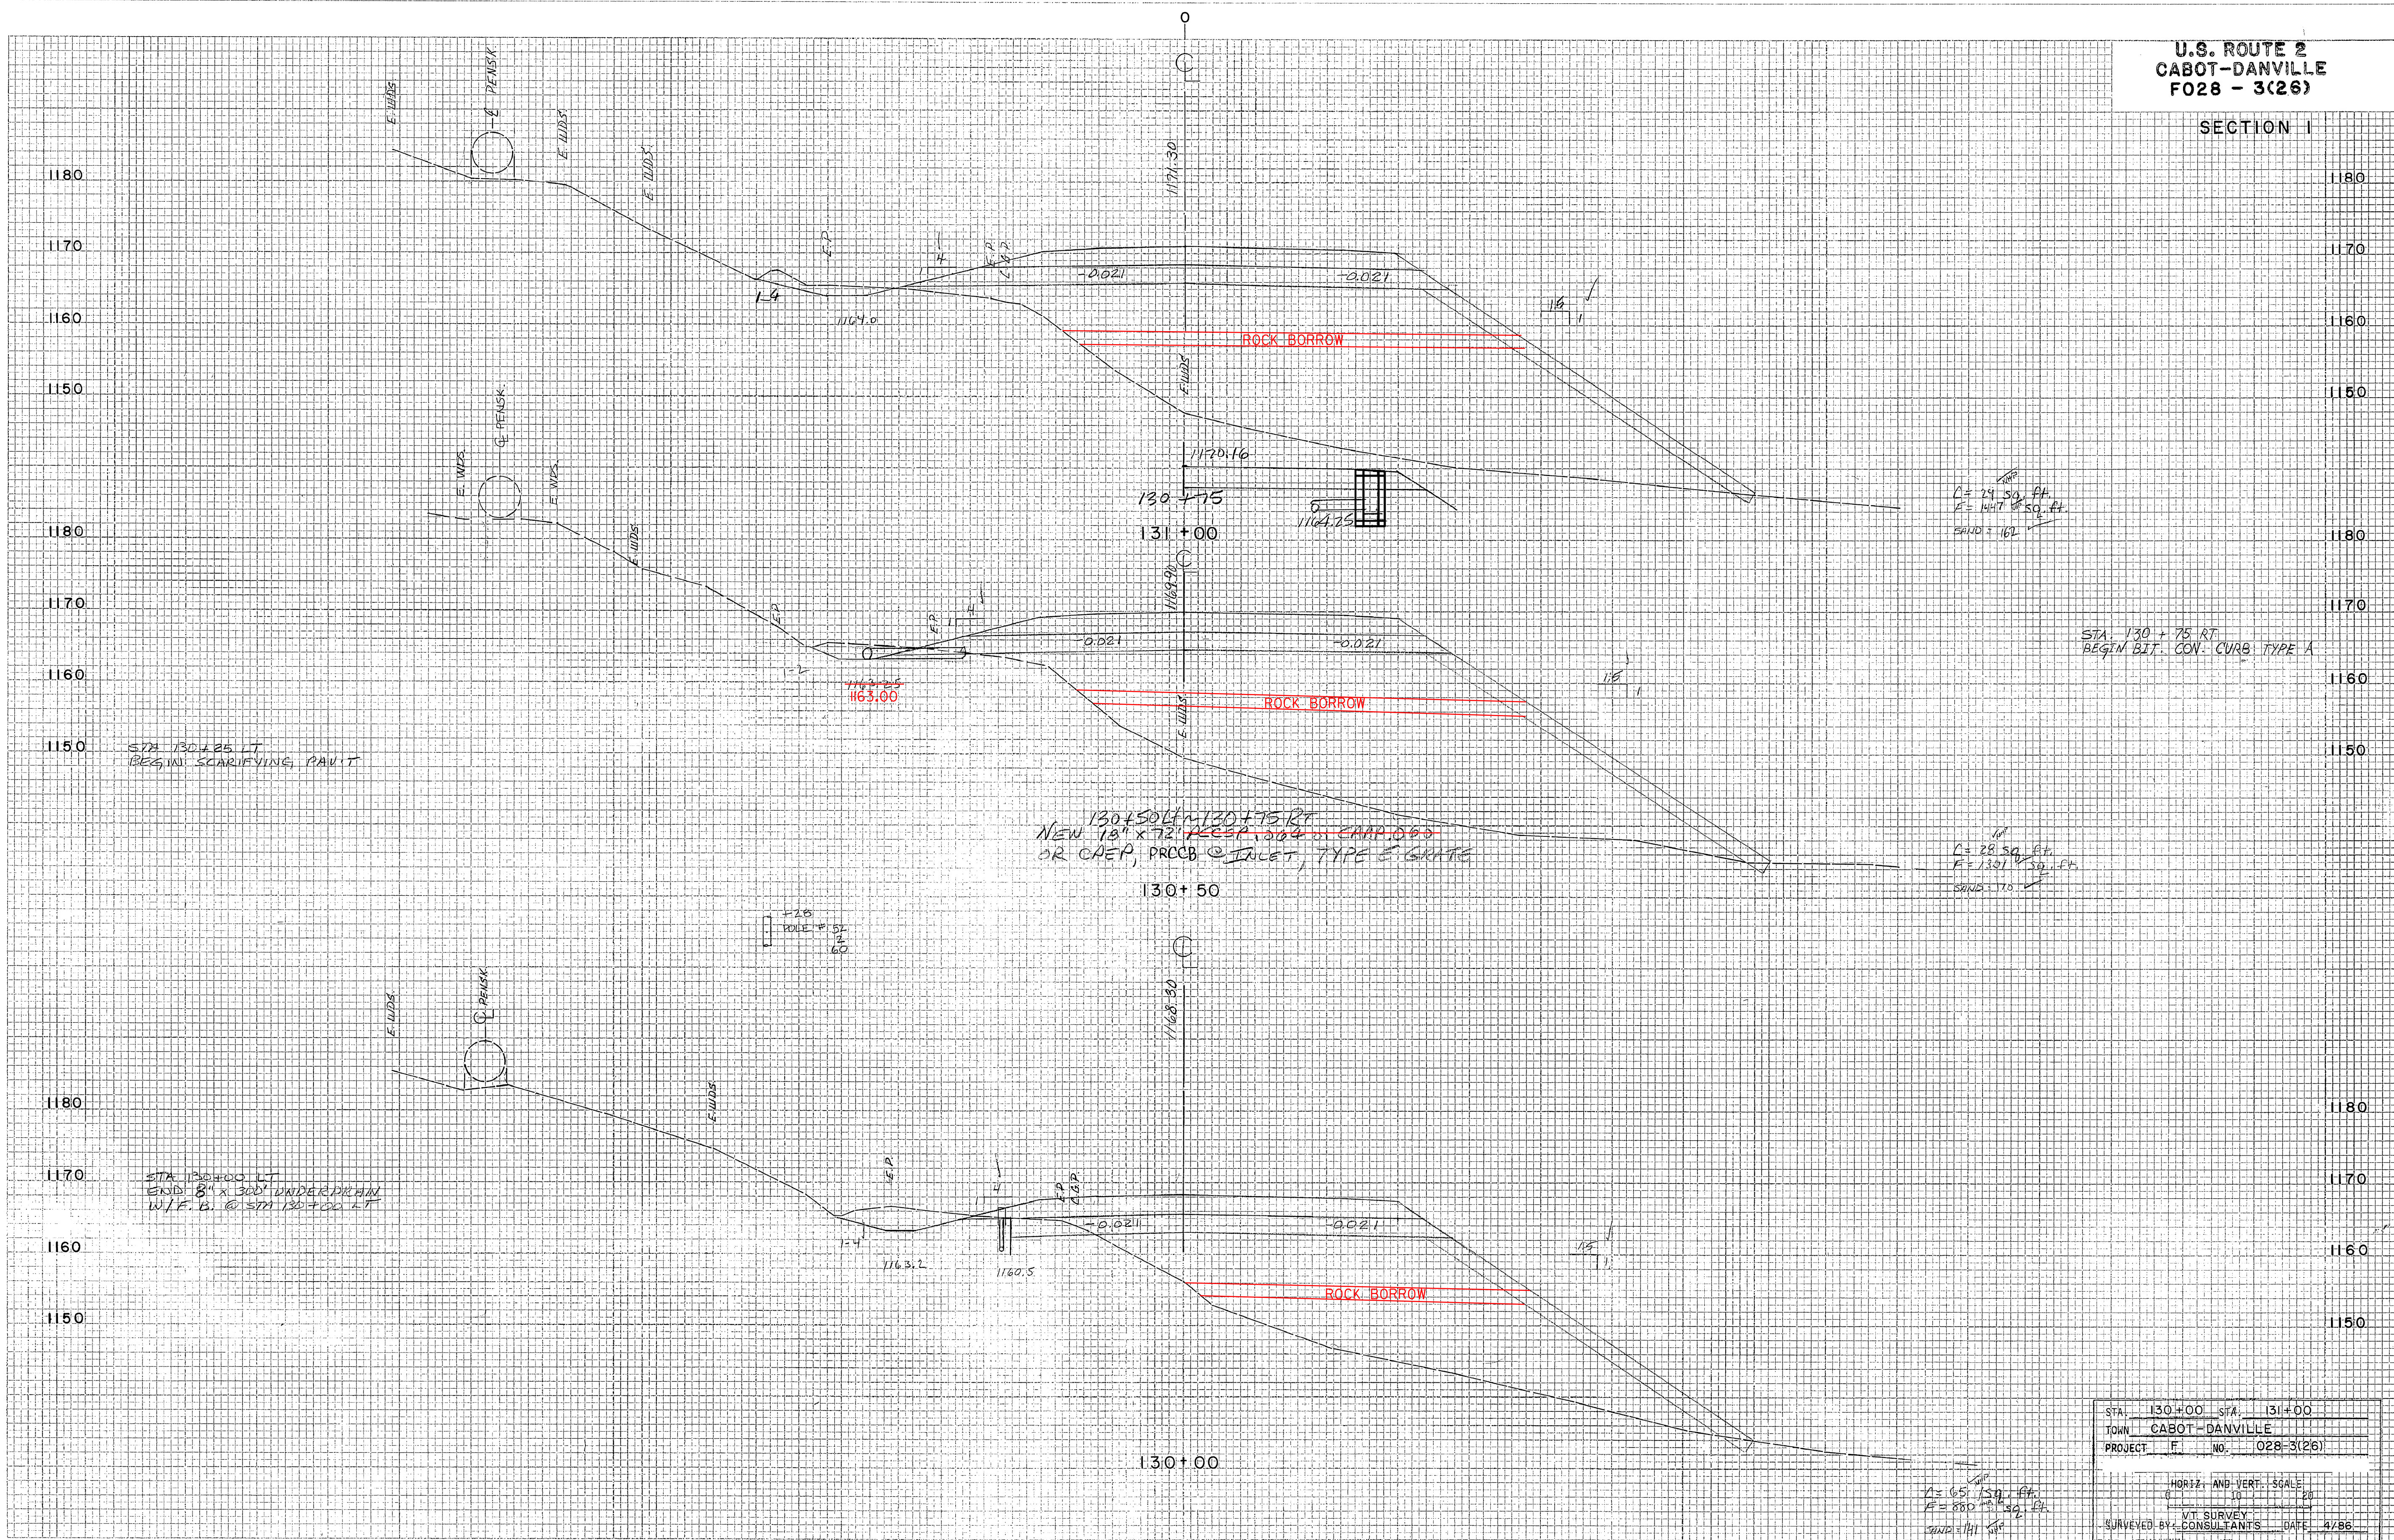

STA. 130+75 RT.
BEGIN BIT. CON. CURB TYPE A

130+50 LIMITED TO 15 RT.
NEW 18" x 72" RECP, 10x4" SNAP, 0.00
OR CRCP, PRECB @ JACKET, TYPE 5 GRATE

STA.	130+00	STA.	131+00
TOWN	CABOT-DANVILLE		
PROJECT	F.	NO.	028-3(26)

HORIZ. AND VERT. SCALE
1" = 20'
1" = 20'
DATE 4/86

PROJECT NAME: CABOT-DANVILLE
PROJECT NUMBER: FECC F 028-3(26) C/1
FILE NAME: 78d058xs.dgn
PROJECT LEADER: K. ROBBE
DESIGNED BY: I. SHEA
MAINLINE CROSS SECTIONS 23
PLOT DATE: 06-OCT-2010
DRAWN BY: I. SHEA
CHECKED BY: S. MENARD
SHEET 155 OF 250