


U.S. ROUTE 2
CABOT-DANVILLE
F028 - 3(26)

SECTION 1

DATE	BY
NO. _____	NO. _____
REVISIONS	DATE
PROPOSED	DATE
NOTED	DATE
REVISIONS	DATE
NO. _____	NO. _____

DATE	BY
NO. _____	NO. _____
REVISIONS	DATE
PROPOSED	DATE
NOTED	DATE
REVISIONS	DATE
NO. _____	NO. _____

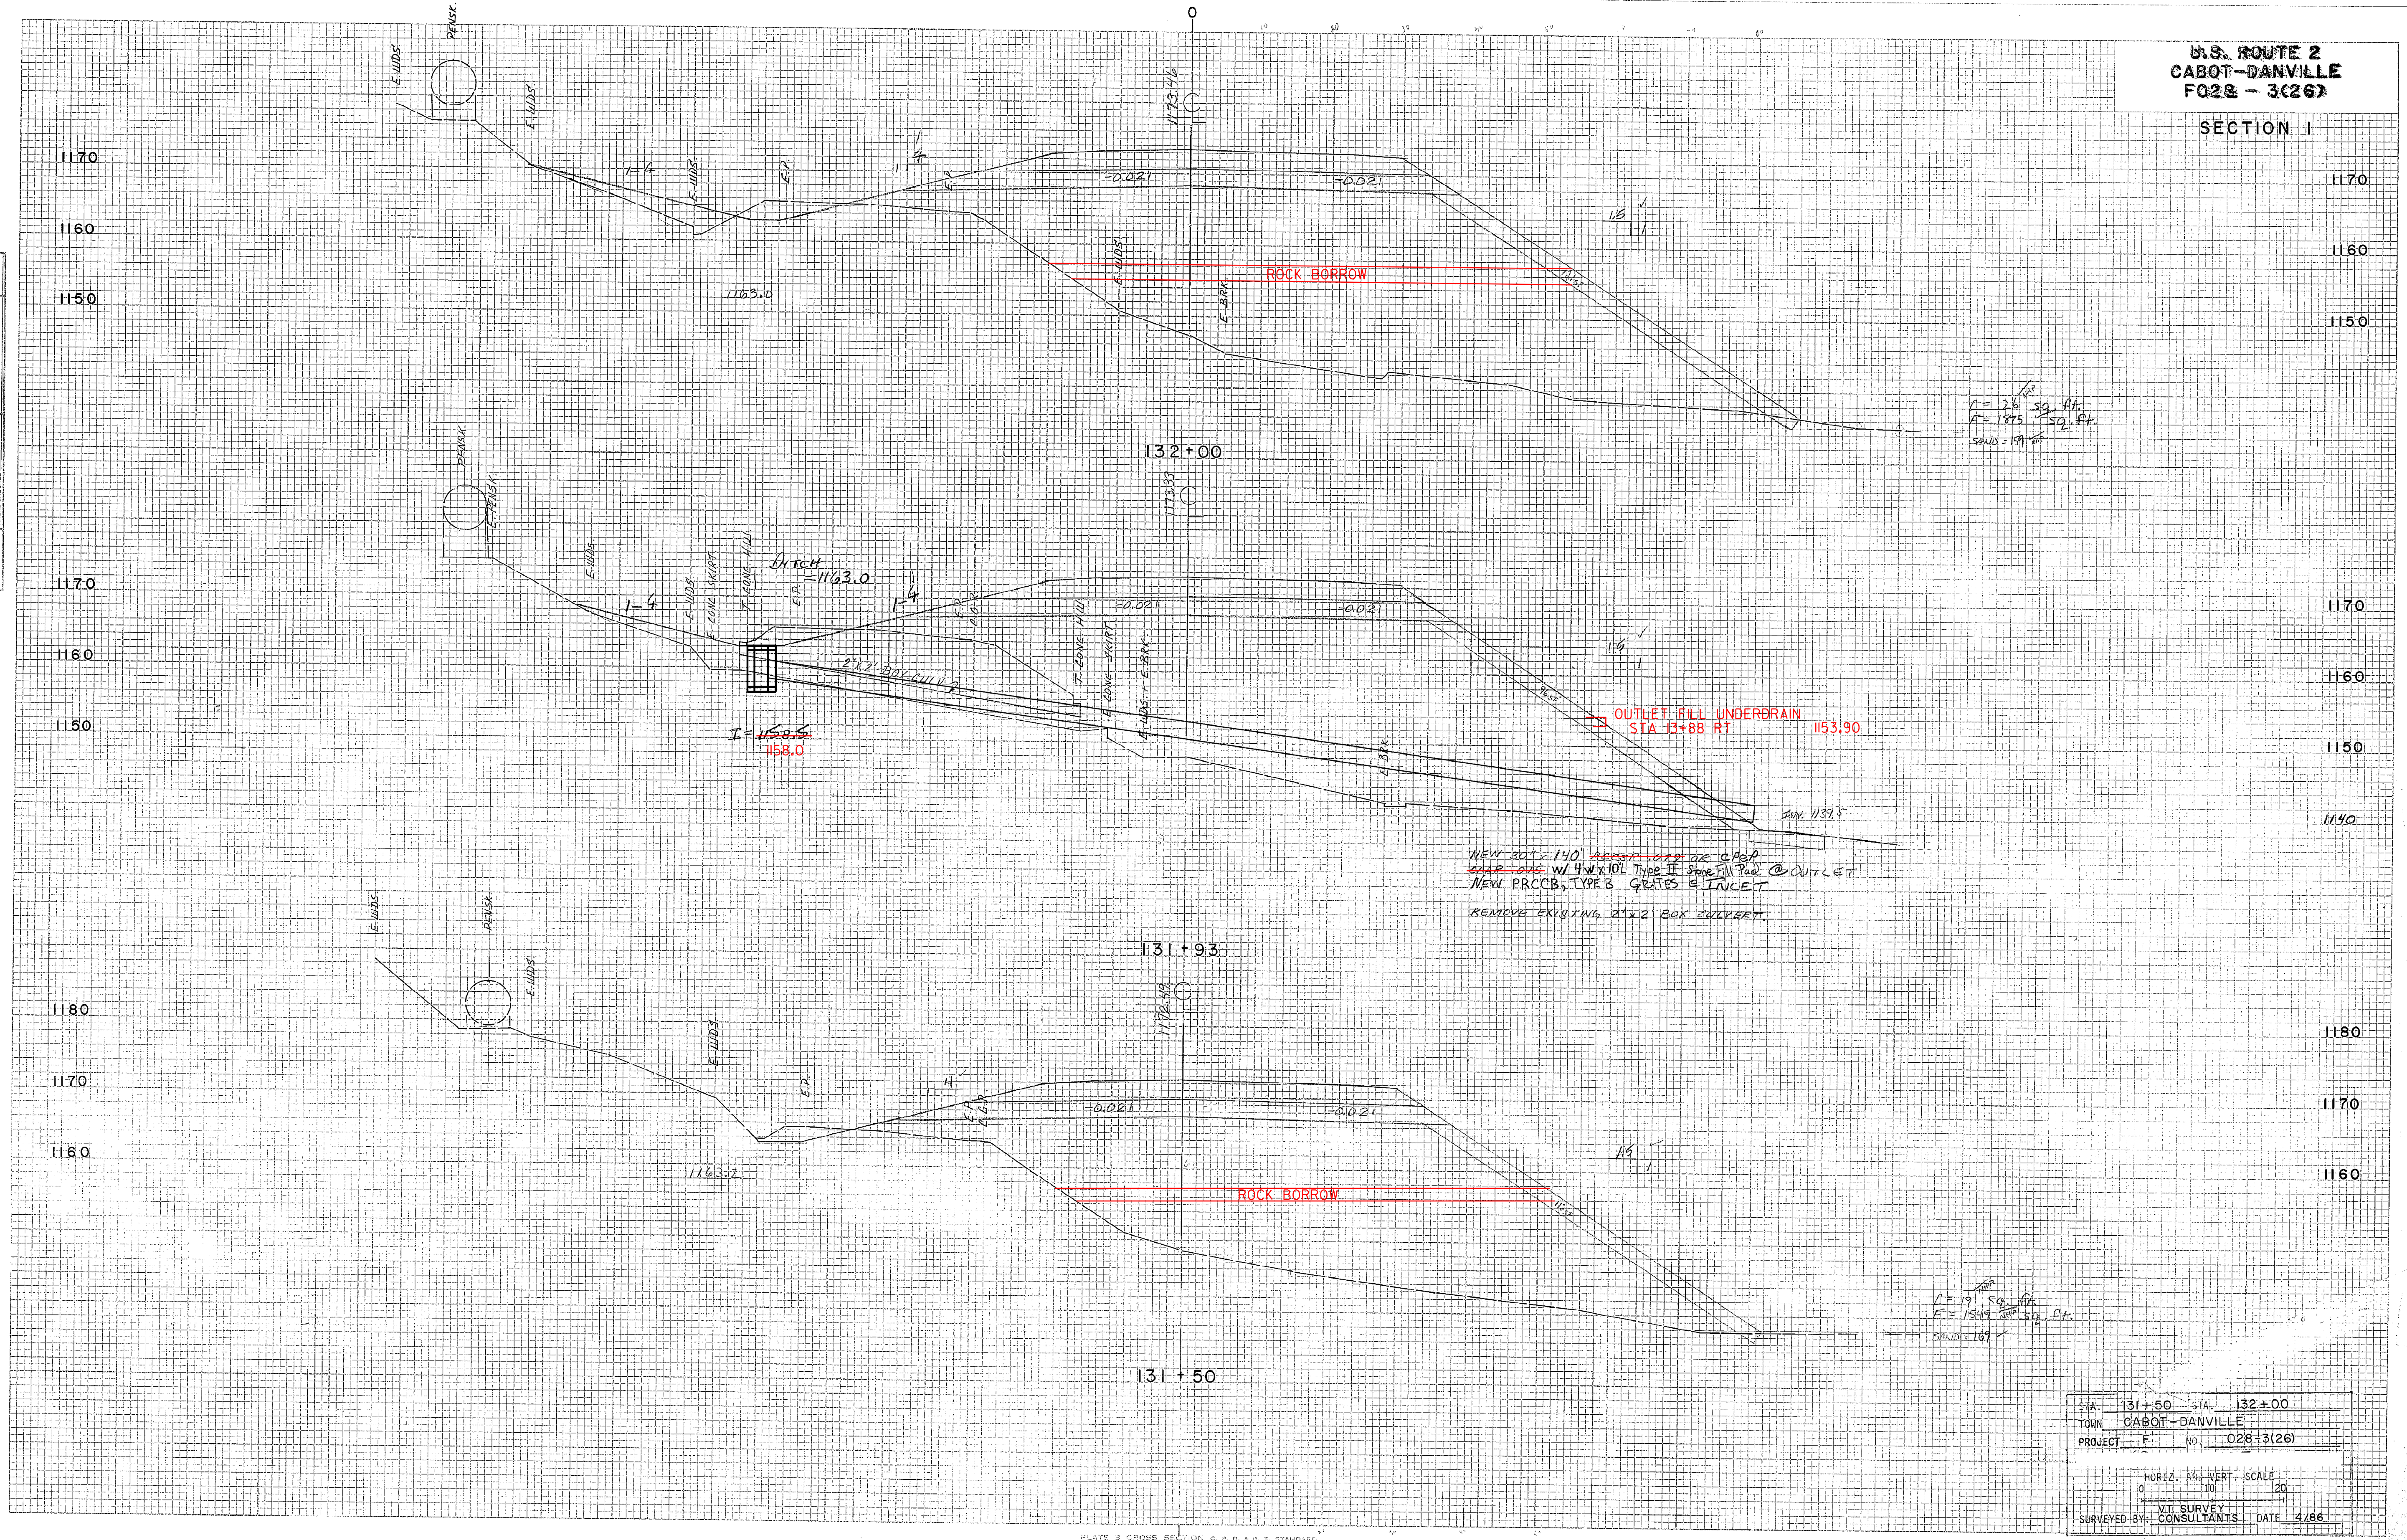

$V = 26 \frac{sq. ft.}{ft.}$
 $F = 1875 \frac{sq. ft.}{ft.}$
 $SPANS = 159'$

NEW 30" x 140" ACCESS ROAD OR C&P
 10' x 10' TYPE II SPREAD @ OUTLET
 NEW PROCB, TYPE 3 GRATES @ INLET
 REMOVE EXISTING 2' x 2' BOX CULVERT

$C = 19 \frac{sq. ft.}{ft.}$
 $F = 1549 \frac{sq. ft.}{ft.}$
 $SPANS = 167'$

STA.	131+50	STA.	132+00
TOWN	CABOT-DANVILLE		
PROJECT	F 028-3(26)		
HORIZ. - 1" = 40'			
VERT. - 1" = 20'			
SURVEYED BY: VIT SURVEY CONSULTANTS			
DATE: 4/86			

PLATE 3 CROSS SECTION, C.P.A.R.E. STANDARD
 DET. CORPORATION

PROJECT NAME:	CABOT-DANVILLE	PLOT DATE:	06-OCT-2010
PROJECT NUMBER:	FEGC F 028-3(26) C/1	DRAWN BY:	I. SHEA
FILE NAME:	78d058xs.dgn	DESIGNED BY:	I. SHEA
PROJECT LEADER:	K. ROBBE	CHECKED BY:	S. MENARD
MAINLINE CROSS SECTIONS 24		SHEET	156 OF 250