


U.S. ROUTE 2
CABOT-DANVILLE
FQ28 - 3(26)
SECTION 1

FINAL SURVEY NOTE BOOK
DATE: _____ BY: _____
DRAWN BY: _____
CHECKED BY: _____
NO. _____

ORIGINAL SURVEY NOTE BOOK
DATE: 7/26 BY: V.A. SURVEY COMPANY
DRAWN BY: BRYANT ASSOC.
CHECKED BY: _____
NO. _____

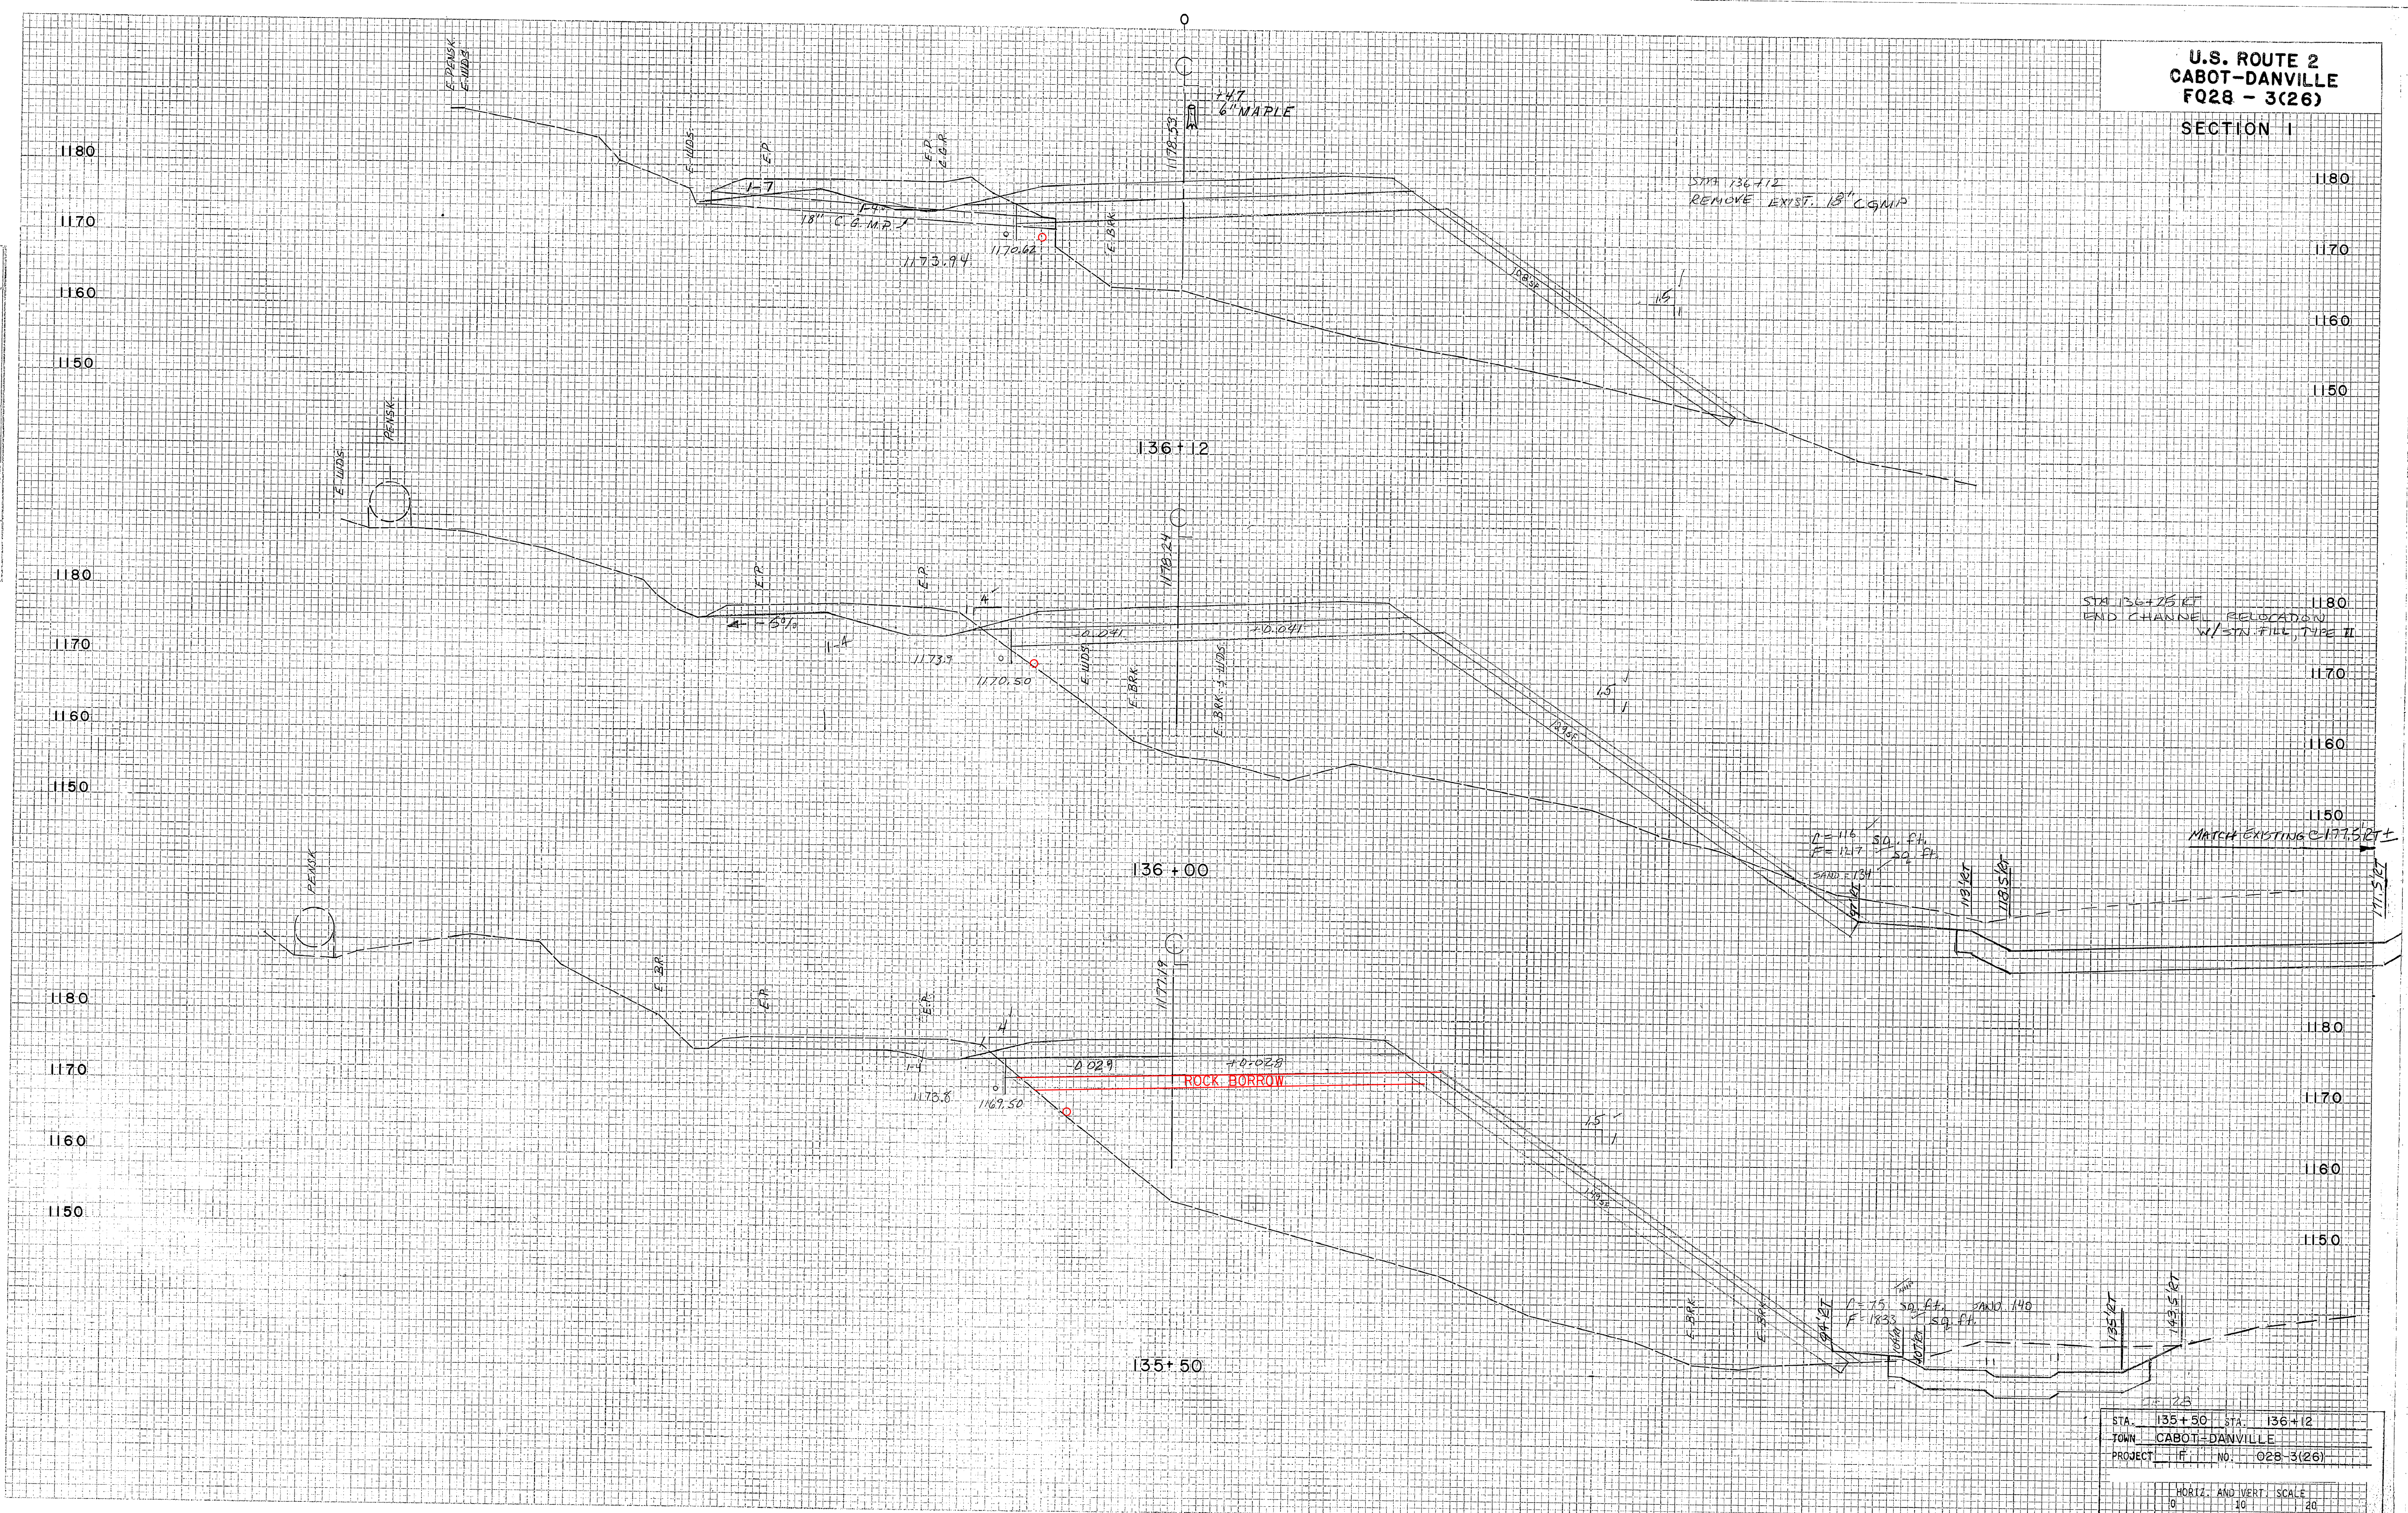

STA.	135+50	STA.	136+12
TOWN	CABOT-DANVILLE		
PROJECT	FEGC F 028-3(26)		
HORIZ. AND VERT. SCALE			
1" = 40'			
SURVEYED BY: I. SHEA			
DATE: 4/96			

PROJECT NAME: CABOT-DANVILLE
PROJECT NUMBER: FEGC F 028-3(26) C/1
FILE NAME: 78d058xs.dgn
PROJECT LEADER: K. ROBBE
DESIGNED BY: I. SHEA
MAINLINE CROSS SECTIONS 27
PLOT DATE: 06-OCT-2010
DRAWN BY: I. SHEA
CHECKED BY: S. MENARD
SHEET 159 OF 250