


U.S. ROUTE 138+66.5
 CABOT-DANVILLE
 F028 - 30
 SECTION 10

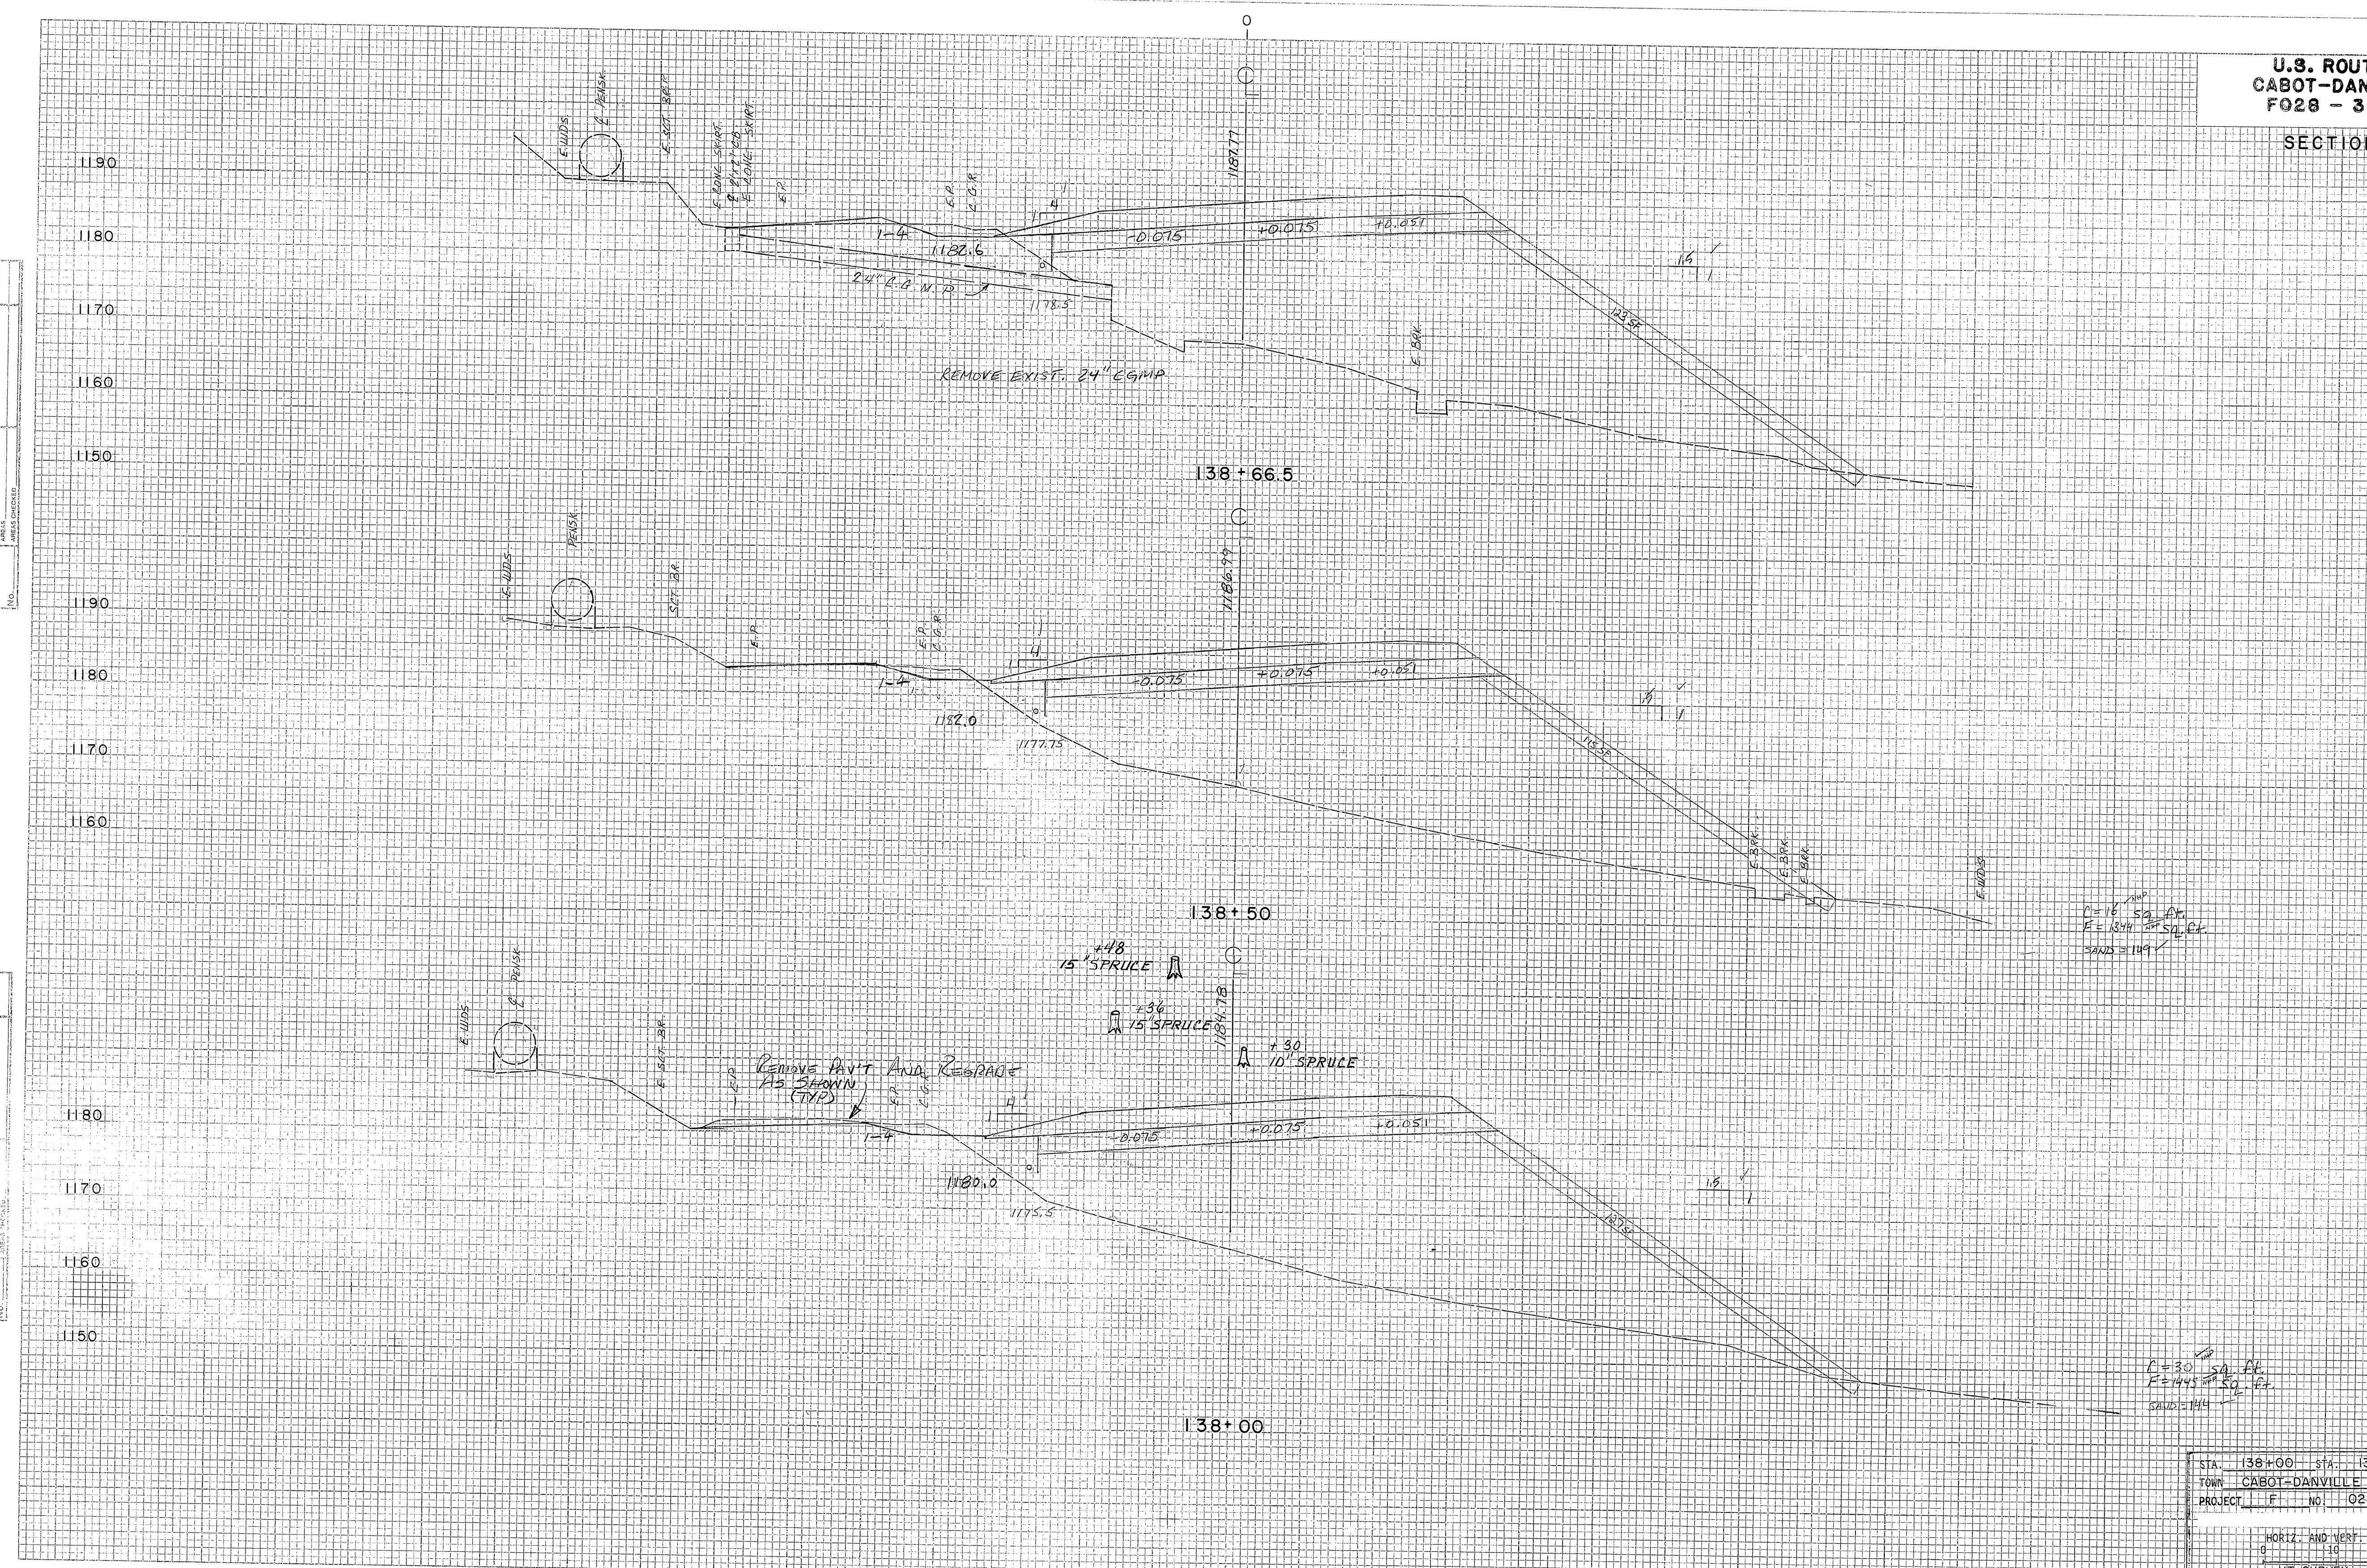

DATE: _____ BY: _____
 SURVEYED: _____
 DRAWN: _____
 CHECKED: _____
 SHEET NO.: _____

DATE: _____ BY: _____
 SURVEYED: _____
 DRAWN: _____
 CHECKED: _____
 SHEET NO.: _____

138+66.5
 1186.99
 +0.075 +0.051
 138+50
 1184.78
 +0.075 +0.051
 138+00
 1184.78
 +0.075 +0.051

C=16 SA. AL.
 E=1344 SQ. FT.
 SAND=1194

C=30 SA. AL.
 E=1445 SQ. FT.
 SAND=1194

STA. 138+00 STA. 138+135
 TOWN CABOT-DANVILLE
 PROJECT F No. 028
 HORIZ. AND VERT. ENGINEERING
 CIVIL SURVEY
 SURVEYED BY: CONSULTANTS

PLATE 3 CROSS SECTION O. P. S. R. E. STANDARD
 SHEET NO. 29

PROJECT NAME: CABOT-DANVILLE
 PROJECT NUMBER: FECC F 028-3(26)
 FILE NAME: 78d058xs.dgn
 PROJECT LEADER: K. ROBE
 DESIGNED BY: I. SHEA
 MAINLINE CROSS SECTIONS 29
 PLOT DRAWN
 CHECK SHEET