


U.S. ROUTE 2
CABOT-DANVILLE
FO28 - 3(26)

SECTION 1

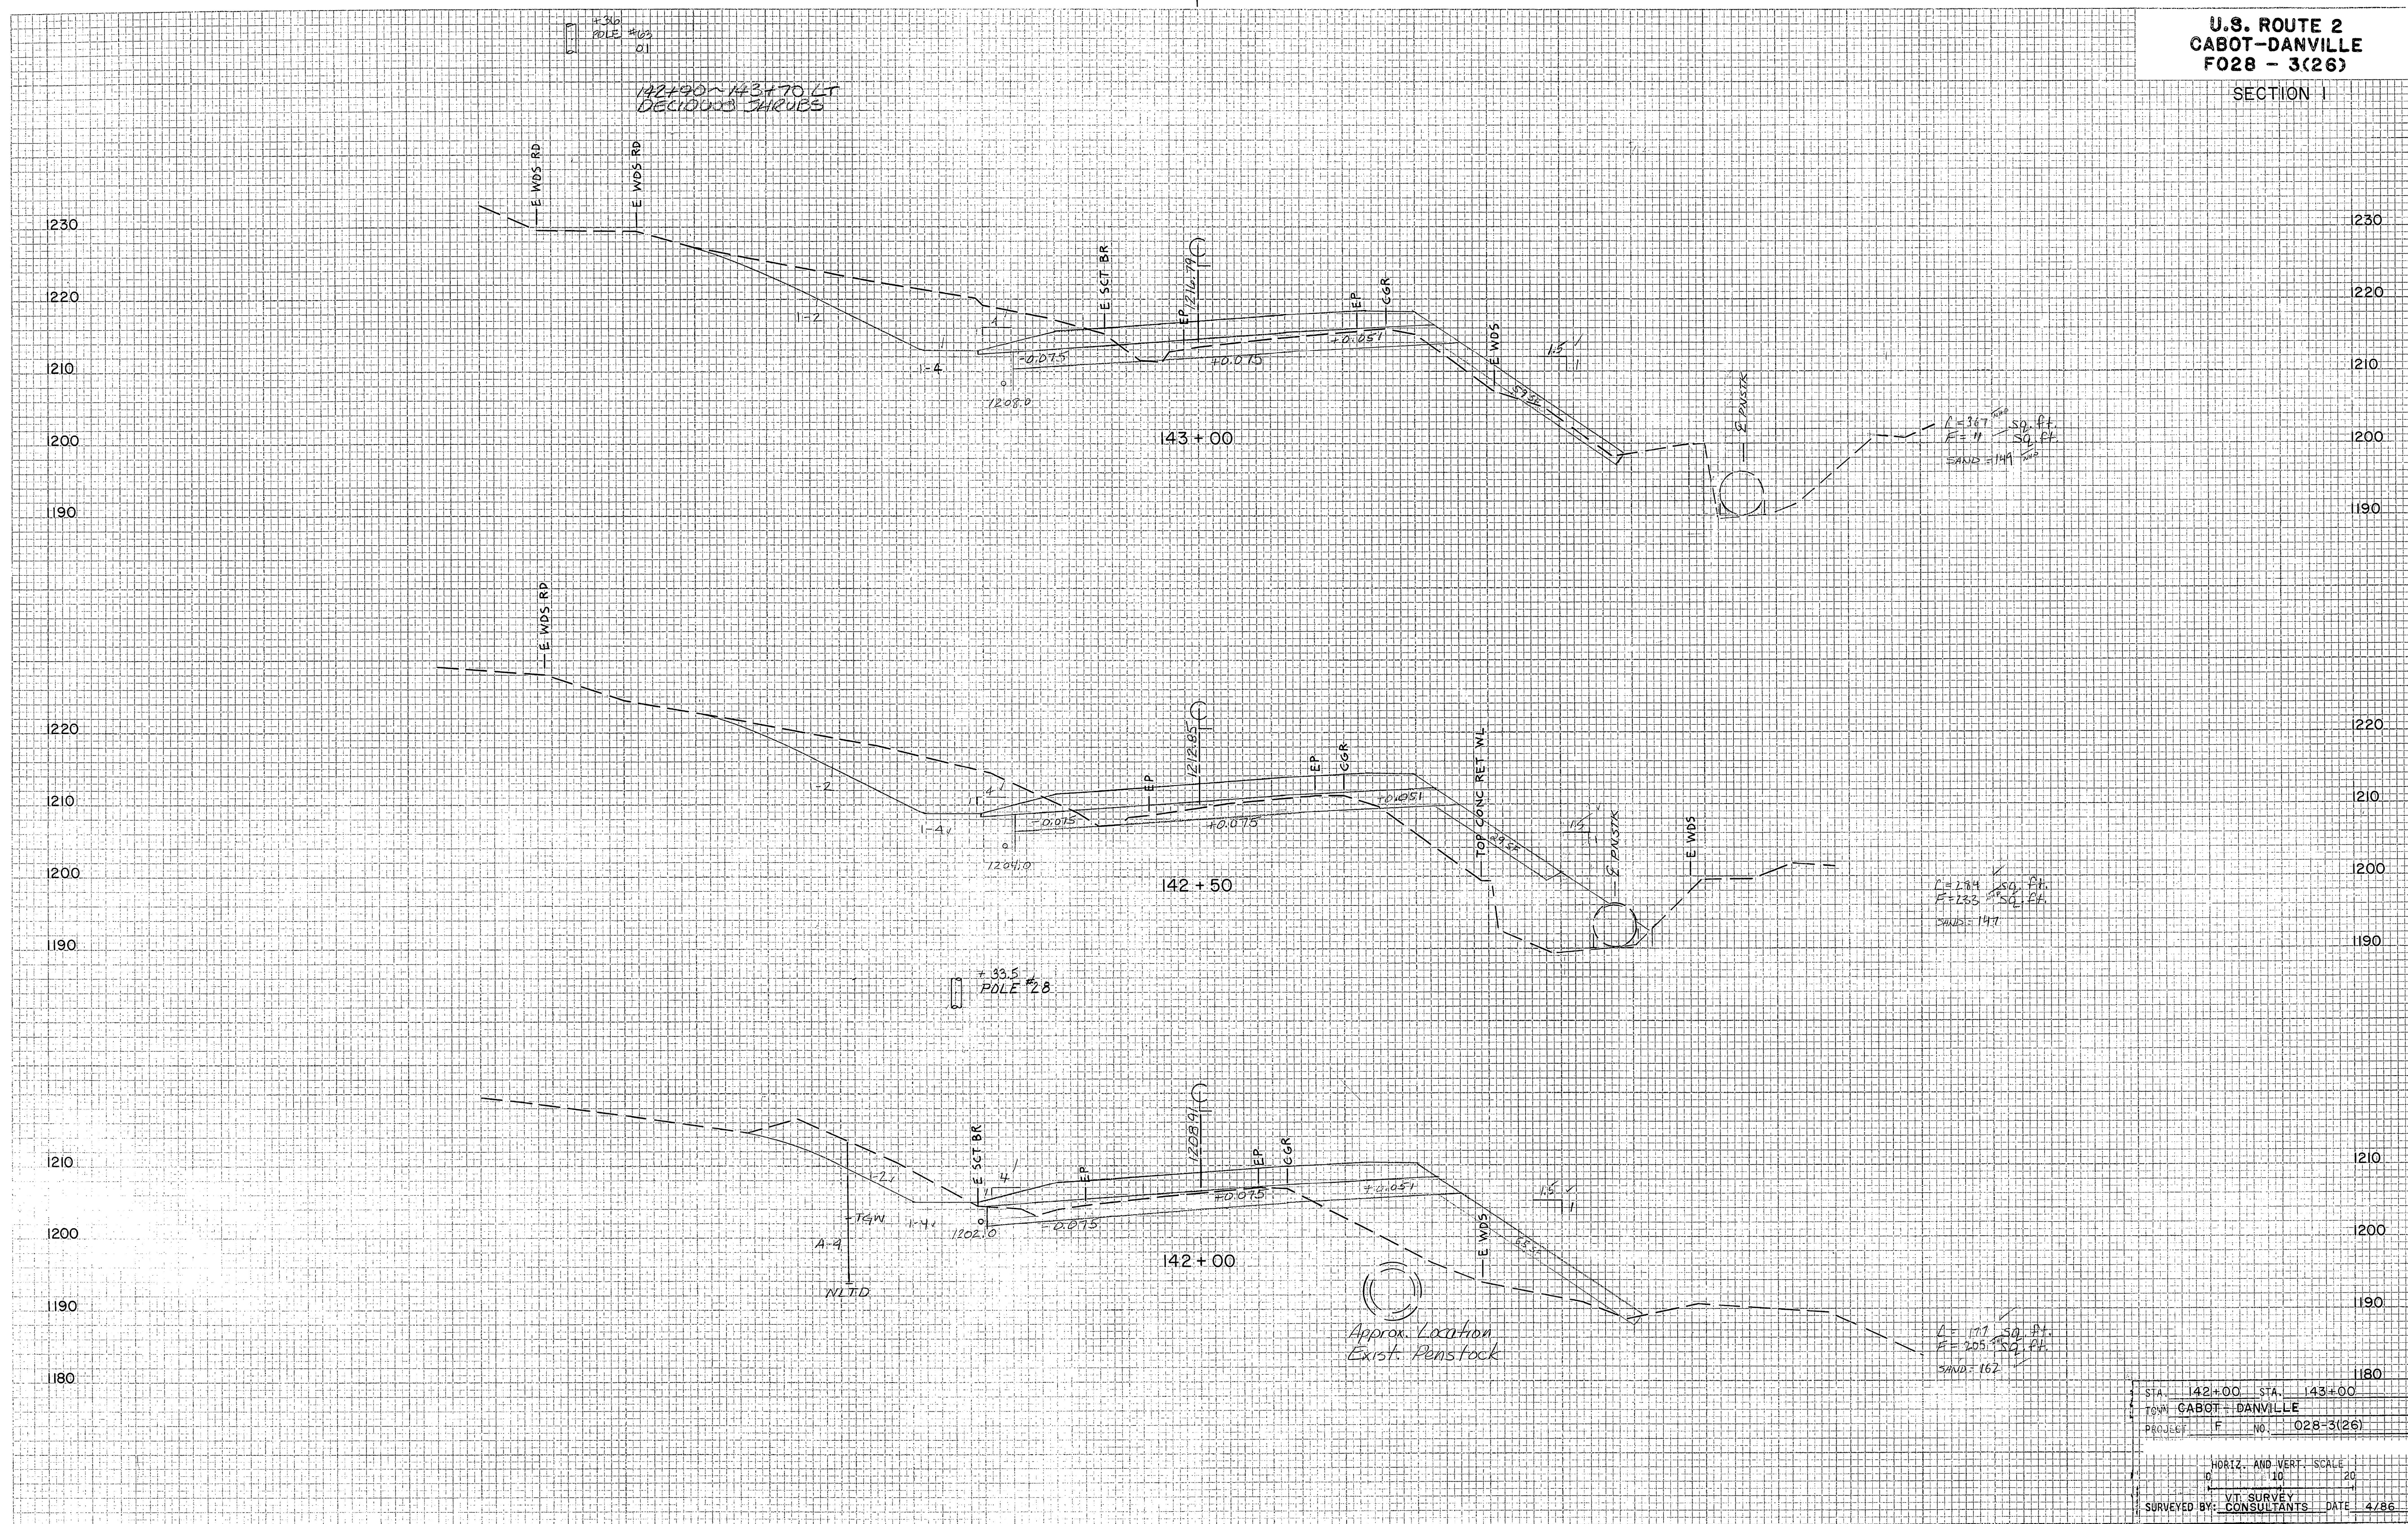

FINAL SURVEY NOTE BOOK

VT SURVEY CONSULTANTS ASSOC. 4/86

STA.	142+00	STA.	143+00
TOWN	CABOT-DANVILLE		
PROJECT	F	NO.	028-3(26)
HORIZ. AND VERT. SCALE			
1" = 10'			
1" = 20'			
SURVEYED BY: CONSULTANTS DATE 4/86			

PROJECT NAME: CABOT-DANVILLE
 PROJECT NUMBER: FECC F 028-3(26) C/1
 FILE NAME: 78d058xs.dgn
 PROJECT LEADER: K. ROBIE
 DESIGNED BY: I. SHEA
 MAINLINE CROSS SECTIONS 32
 PLOT DATE: 06-OCT-2010
 DRAWN BY: I. SHEA
 CHECKED BY: S. MENARD
 SHEET 164 OF 250