


U.S. ROUTE 2  
CABOT-DANVILLE  
F028 - 3(26)

SECTION I

FINAL SURVEY	DATE
NOTED	BY
PLOTTED	
REPLATE	
AREA CHECKED	
NO.	

ORIGINAL SURVEY	DATE
NOTED	BY
PLOTTED	
REPLATE	
AREA CHECKED	
NO.	

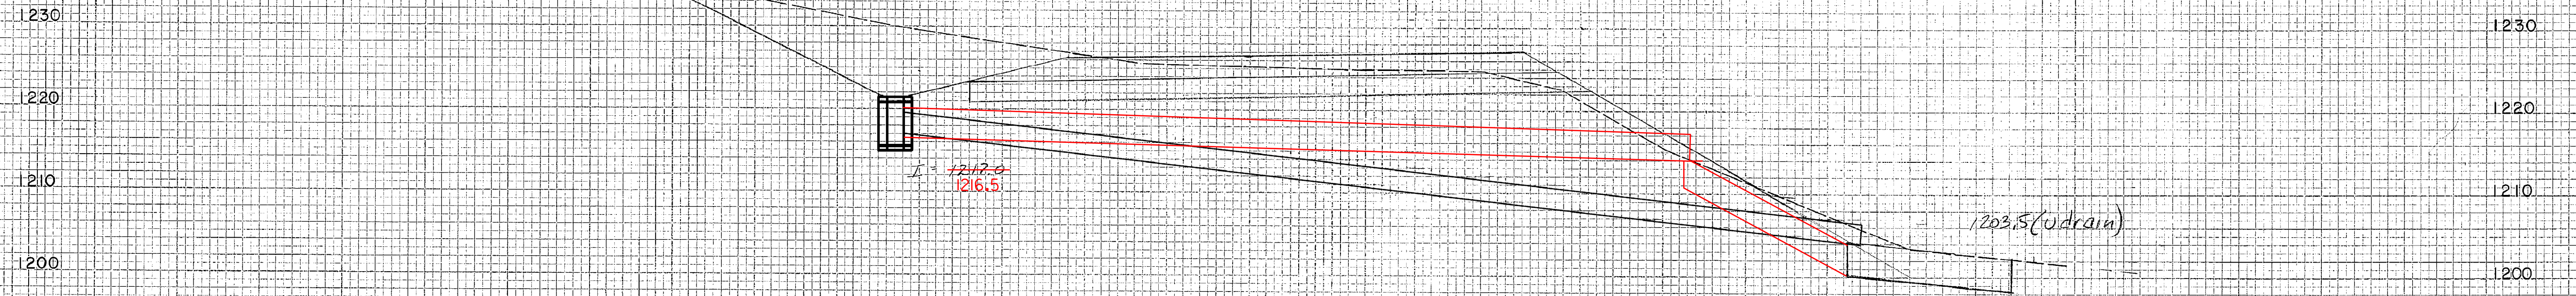

144 + 32  
ASKEWED 64° 30' LT

98'  
NEW 30' X 10' INLET OR C&G  
4' X 20' PAD, TYPE B GRATES  
INLET STONE FILL PAD, TYPE II

STA. 144 + 32	STA. 144 + 32
TOWN CABOT-DANVILLE	
PROJECT F	NO. 028-3(26)
HORIZ. AND VERT. SCALE	
0	10 20
SURVEYED BY: CONSULTANTS DATE 4/88	

PLATE 3 CROSS SECTION C. P. R. & H. C. STANARD  
REPORT COOPERATION

PROJECT NAME:	CABOT-DANVILLE	PLOT DATE:	06-OCT-2010
PROJECT NUMBER:	FEGC F 028-3(26) C/1	DRAWN BY:	I. SHEA
FILE NAME:	78d058xs.dgn	DESIGNED BY:	I. SHEA
DESIGNED BY:	I. SHEA	CHECKED BY:	S. MENARD
MAINLINE CROSS SECTIONS 34		SHEET	166 OF 250