


U.S. ROUTE 2
CABOT-DANVILLE
F028 - 3(26)

SECTION 1

FINAL SURVEY NOTE BOOK NO. DATE BY

ORIGINAL SURVEY NOTE BOOK NO. DATE BY
BY STATE CONSULTANT
BY STATE CONSULTANT

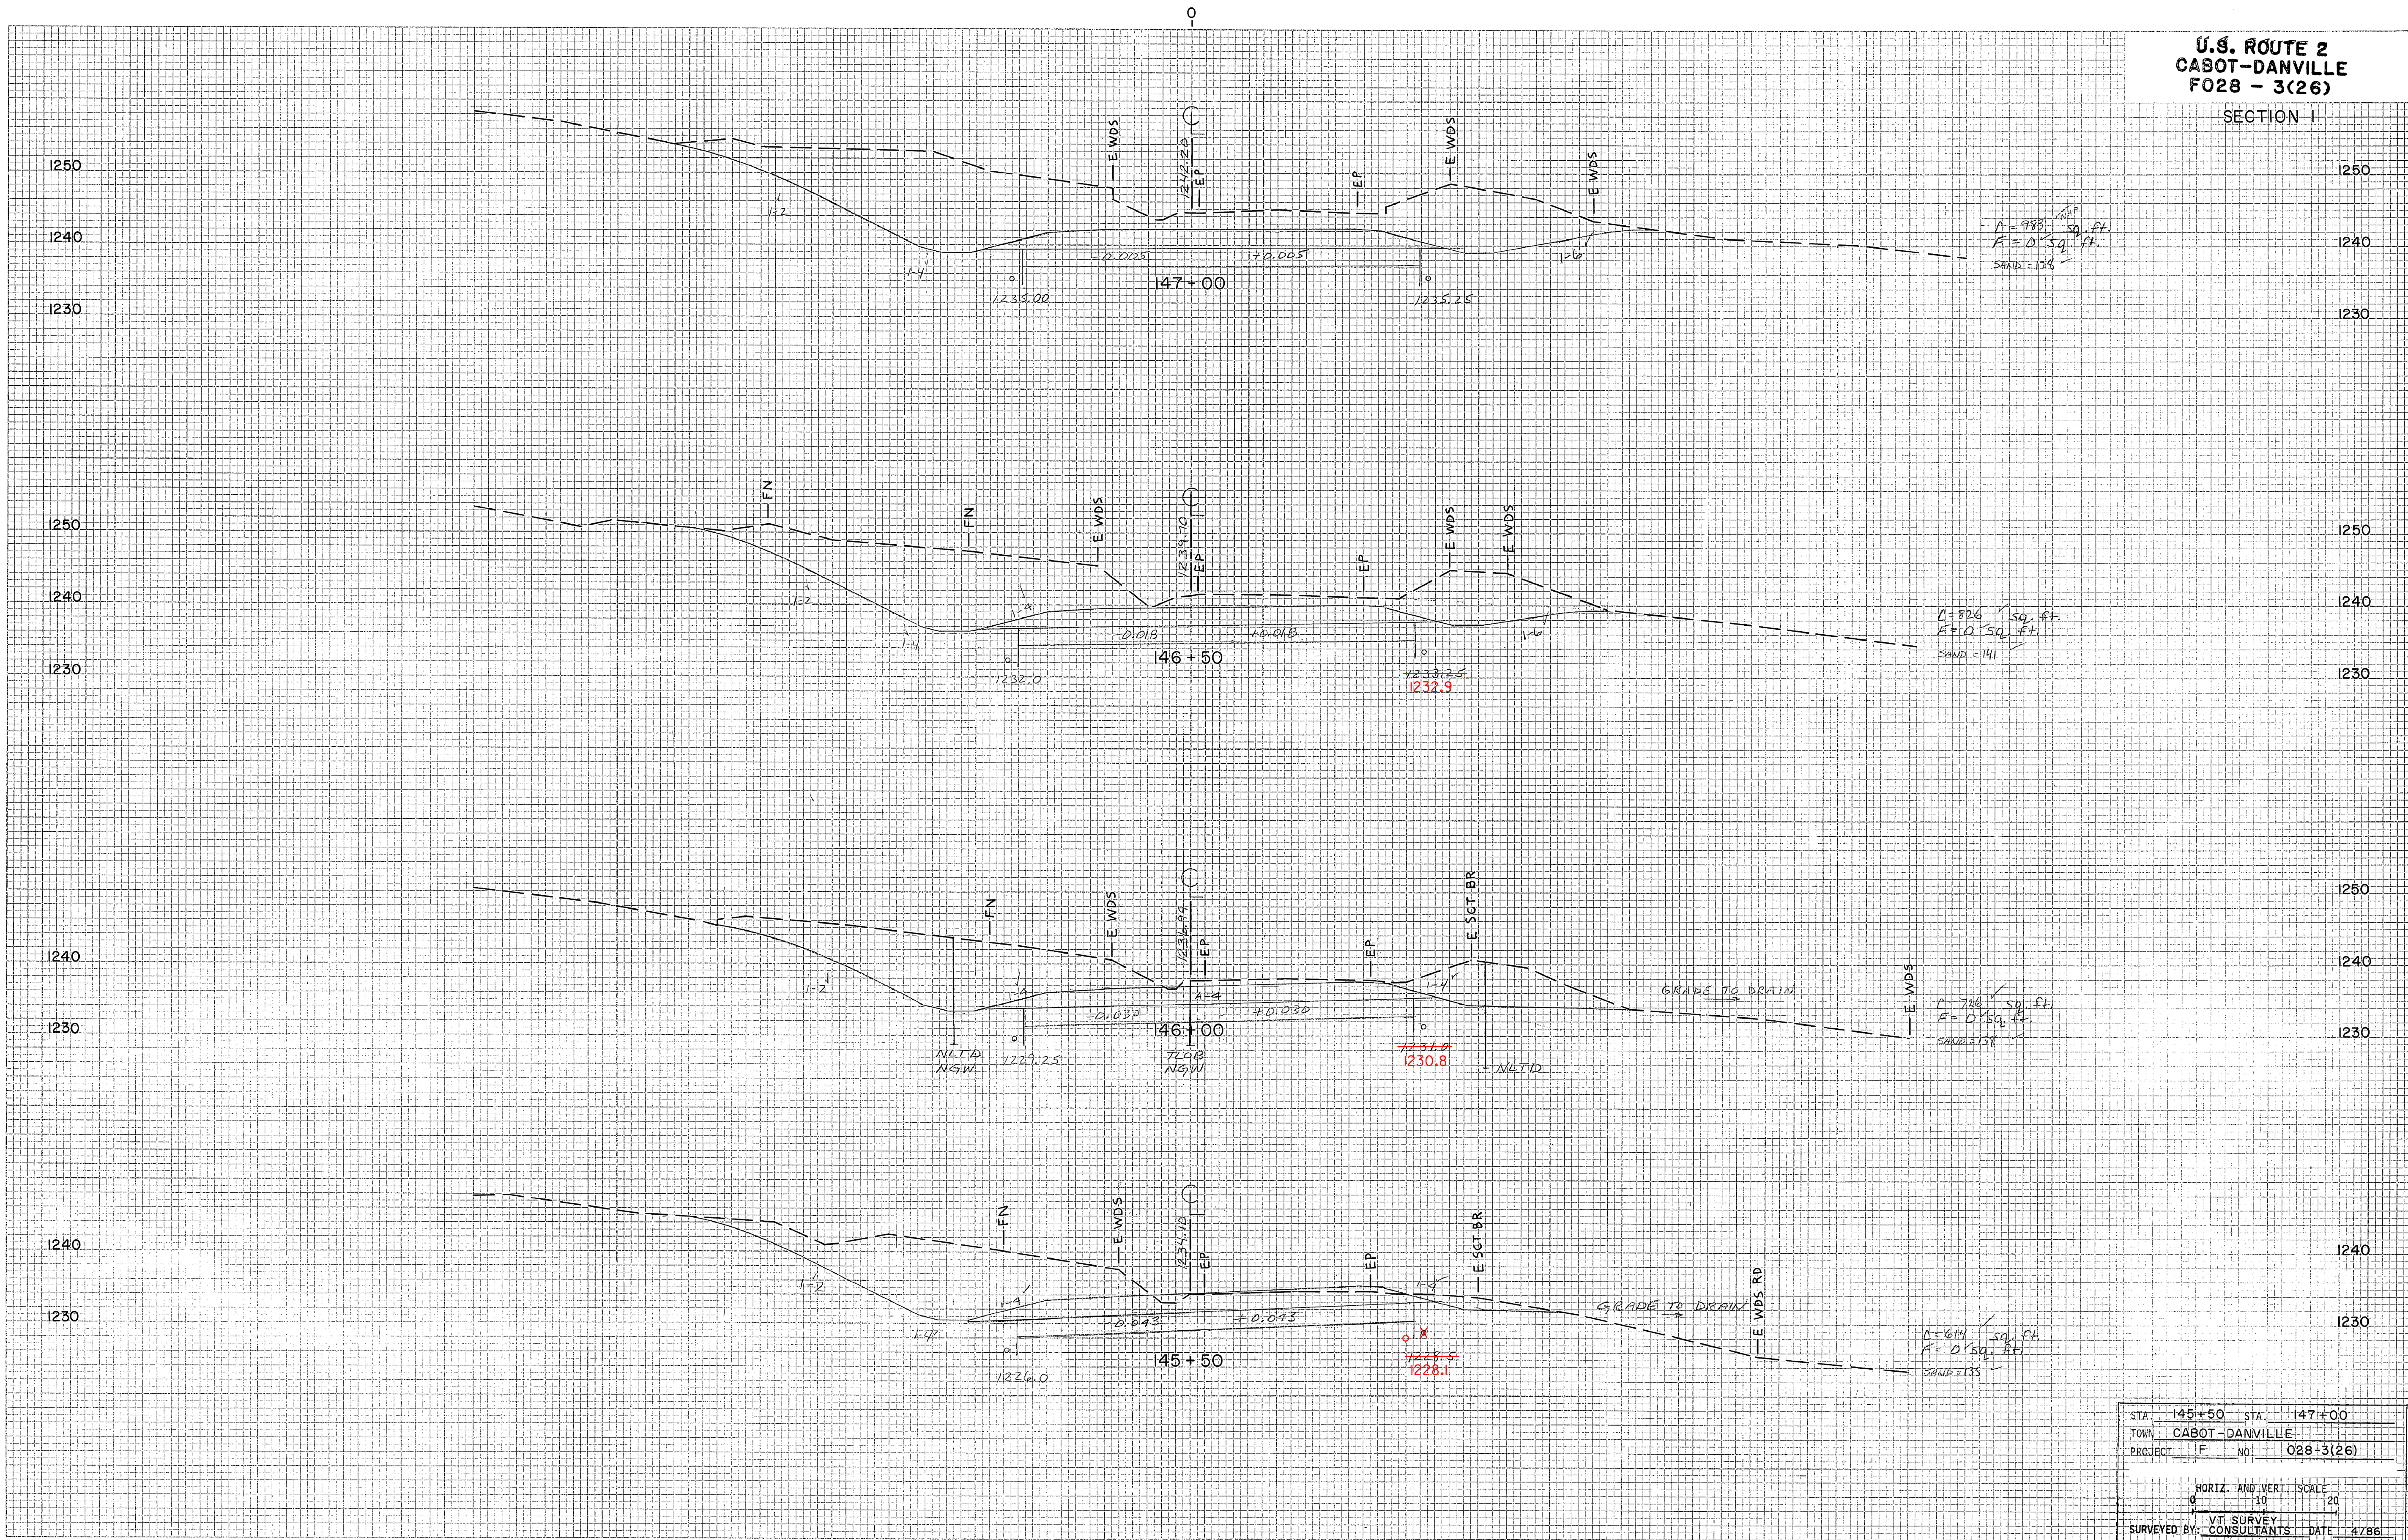

STA. 145+50	STA. 147+00
TOWN CABOT-DANVILLE	
PROJECT F	NO. 028-3(26)
HORIZ. AND VERT. SCALE	
0	10 20
V.T. SURVEY	
SURVEYED BY: CONSULTANTS	DATE 4/86

PLATE 2 CROSS SECTION 0, P. R. & F. E. STANBARD
SHEILA CORPORATION

PROJECT NAME: CABOT-DANVILLE
PROJECT NUMBER: FECC F 028-3(26) C/1
FILE NAME: 78d058xs.dgn PLOT DATE: 06-OCT-2010
PROJECT LEADER: K. ROBBE DRAWN BY: I. SHEA
DESIGNED BY: I. SHEA CHECKED BY: S. MENARD
MAINLINE CROSS SECTIONS 36 SHEET 168 OF 250