


U.S. ROUTE 2
CABOT-DANVILLE
FO28 - 3(26)

SECTION 1

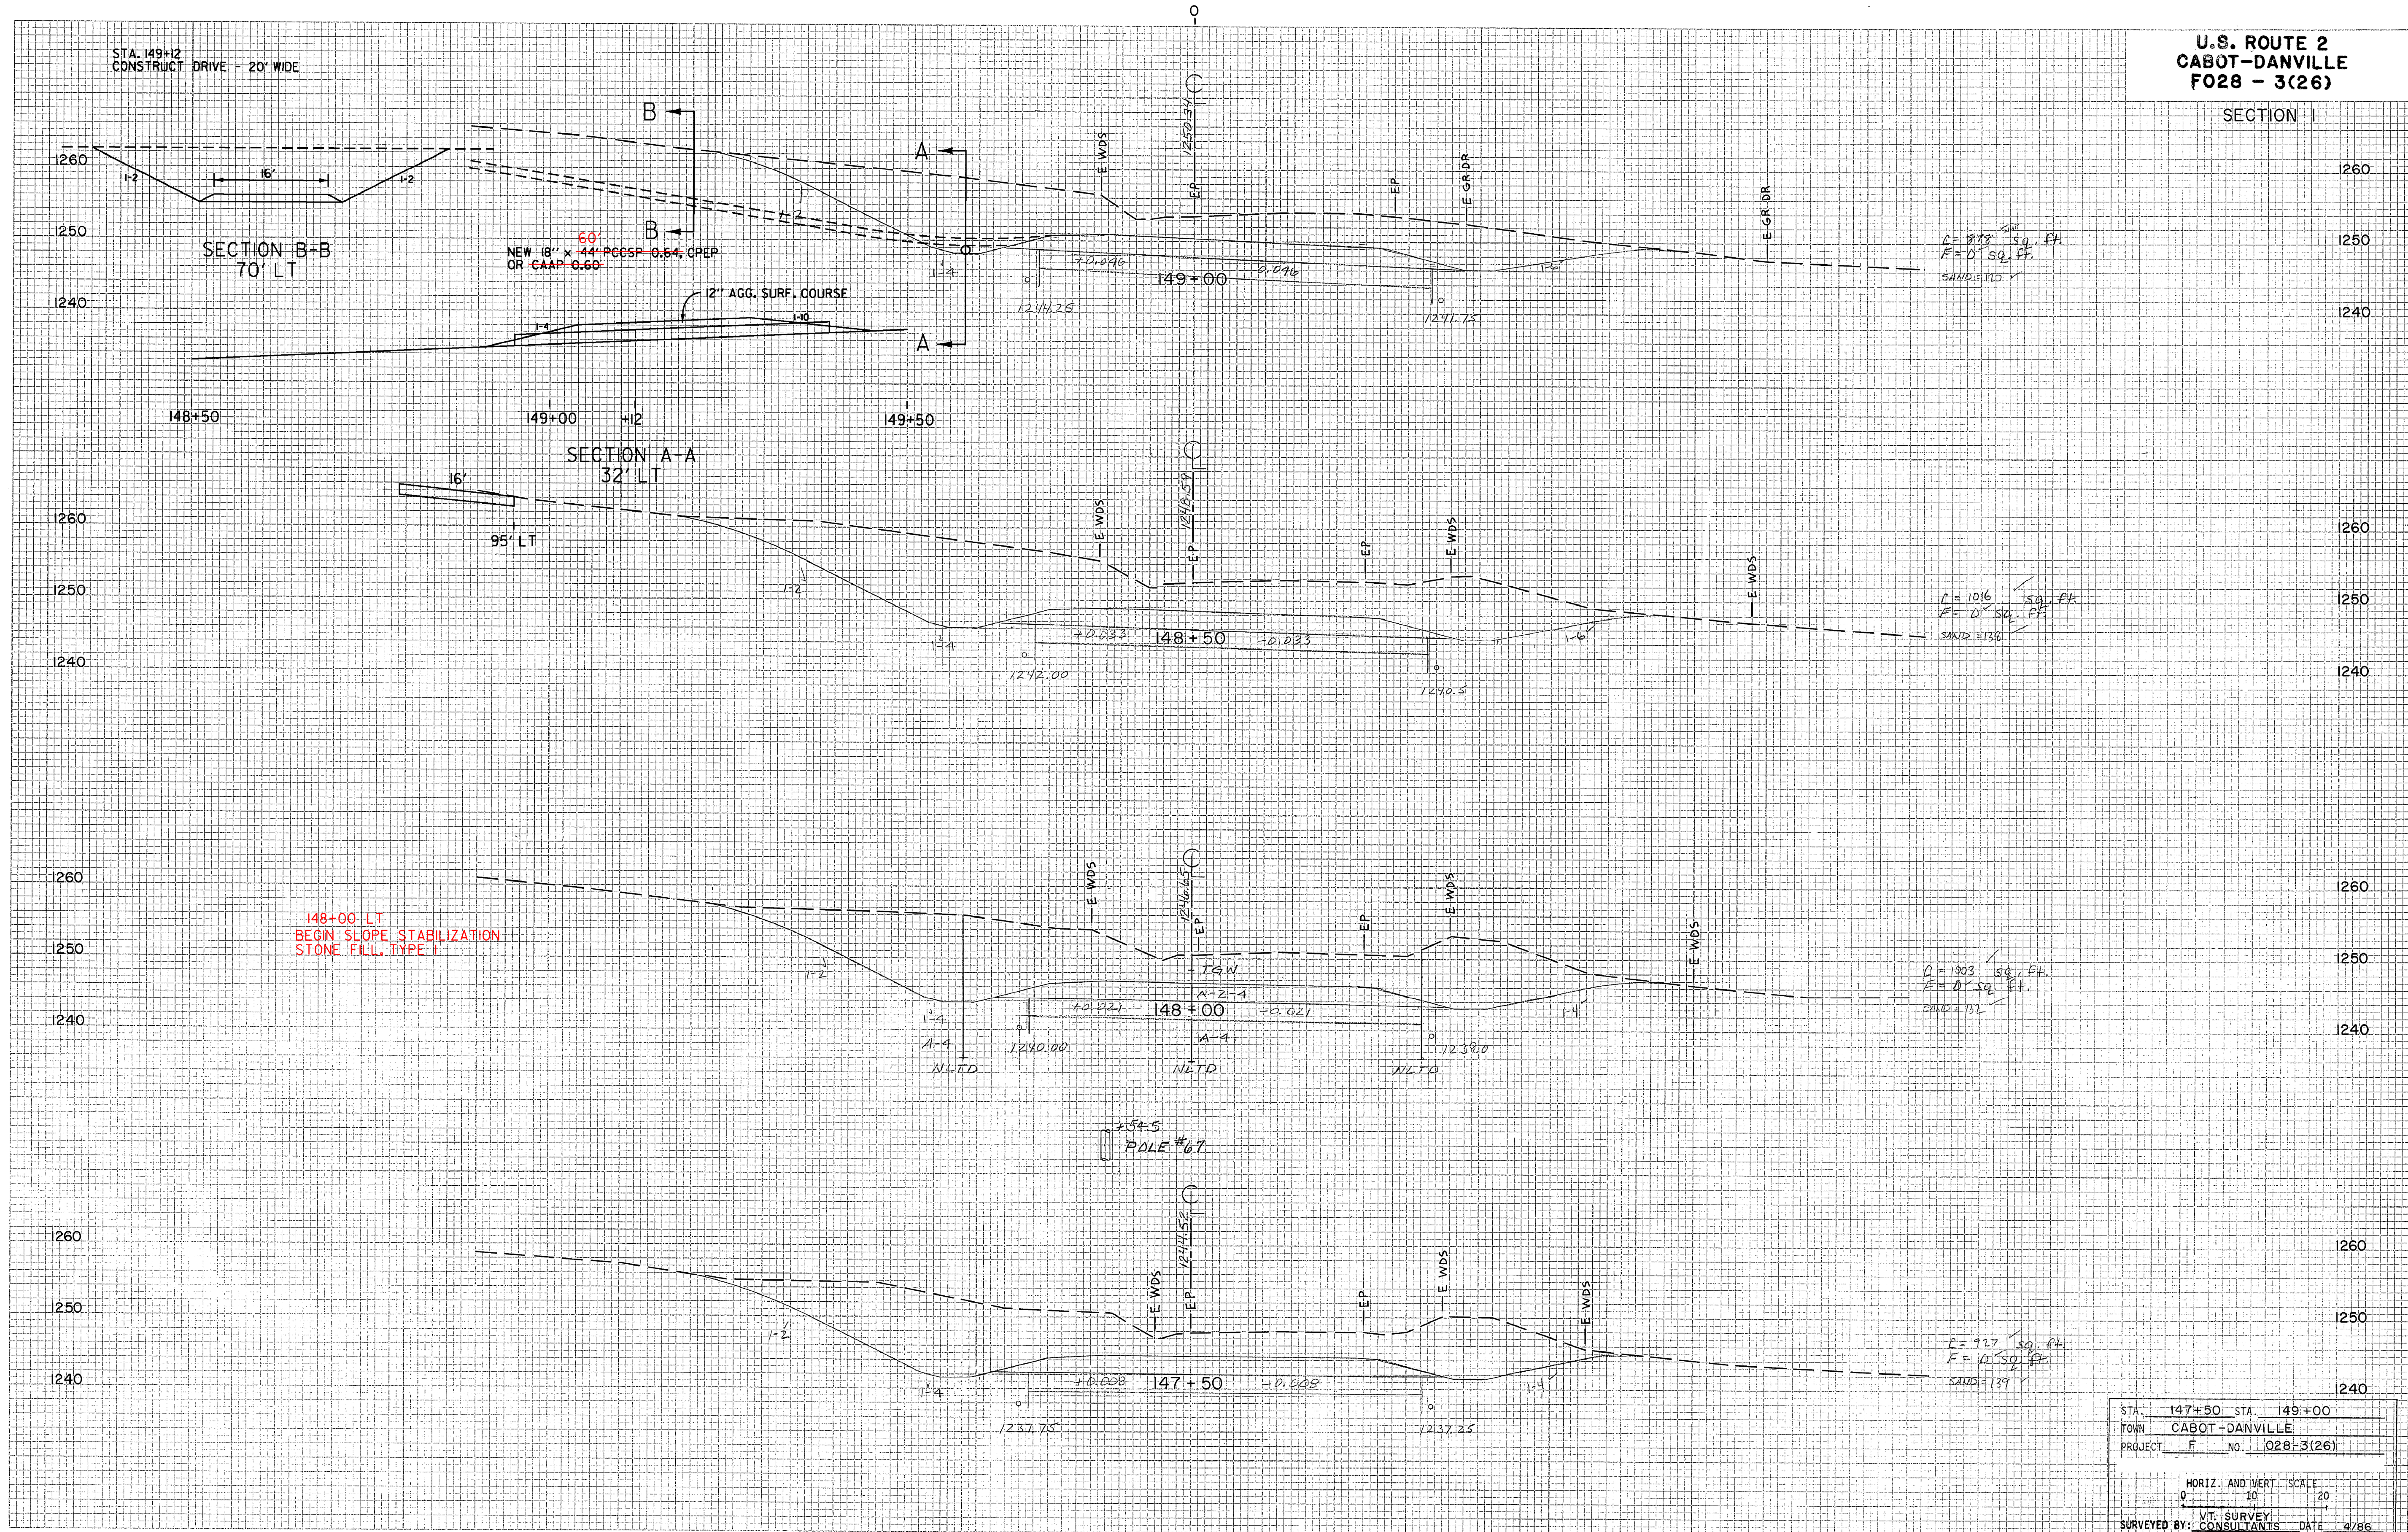

DATE	
BY	
REVISION	
NO.	
DESCRIPTION	
DATE	
BY	
REVISION	
NO.	
DESCRIPTION	

DATE	
BY	
REVISION	
NO.	
DESCRIPTION	
DATE	
BY	
REVISION	
NO.	
DESCRIPTION	

STA.	147+50	STA.	149+00
TOWN	CABOT-DANVILLE		
PROJECT	F NO. 028-3(26)		
HORIZ. AND VERT. SCALE			
0 10 20			
VT. SURVEY			
SURVEYED BY: CONSULTANTS		DATE 4/86	

PLATE 3 - CROSS SECTION O. P. & R. E. STANDARD
DET. CO. CORPORATION

PROJECT NAME:	CABOT-DANVILLE
PROJECT NUMBER:	FEGC F 028-3(26) C/1
FILE NAME:	78d058xs.dgn
PROJECT LEADER:	K. ROBBE
DESIGNED BY:	I. SHEA
MAINLINE CROSS SECTIONS 37	
PLOT DATE:	06-OCT-2010
DRAWN BY:	I. SHEA
CHECKED BY:	S. MENARD
SHEET	169 OF 250