


**U.S. ROUTE 2
CABOT-DANVILLE
F028 - 3(26)**

SECTION 1

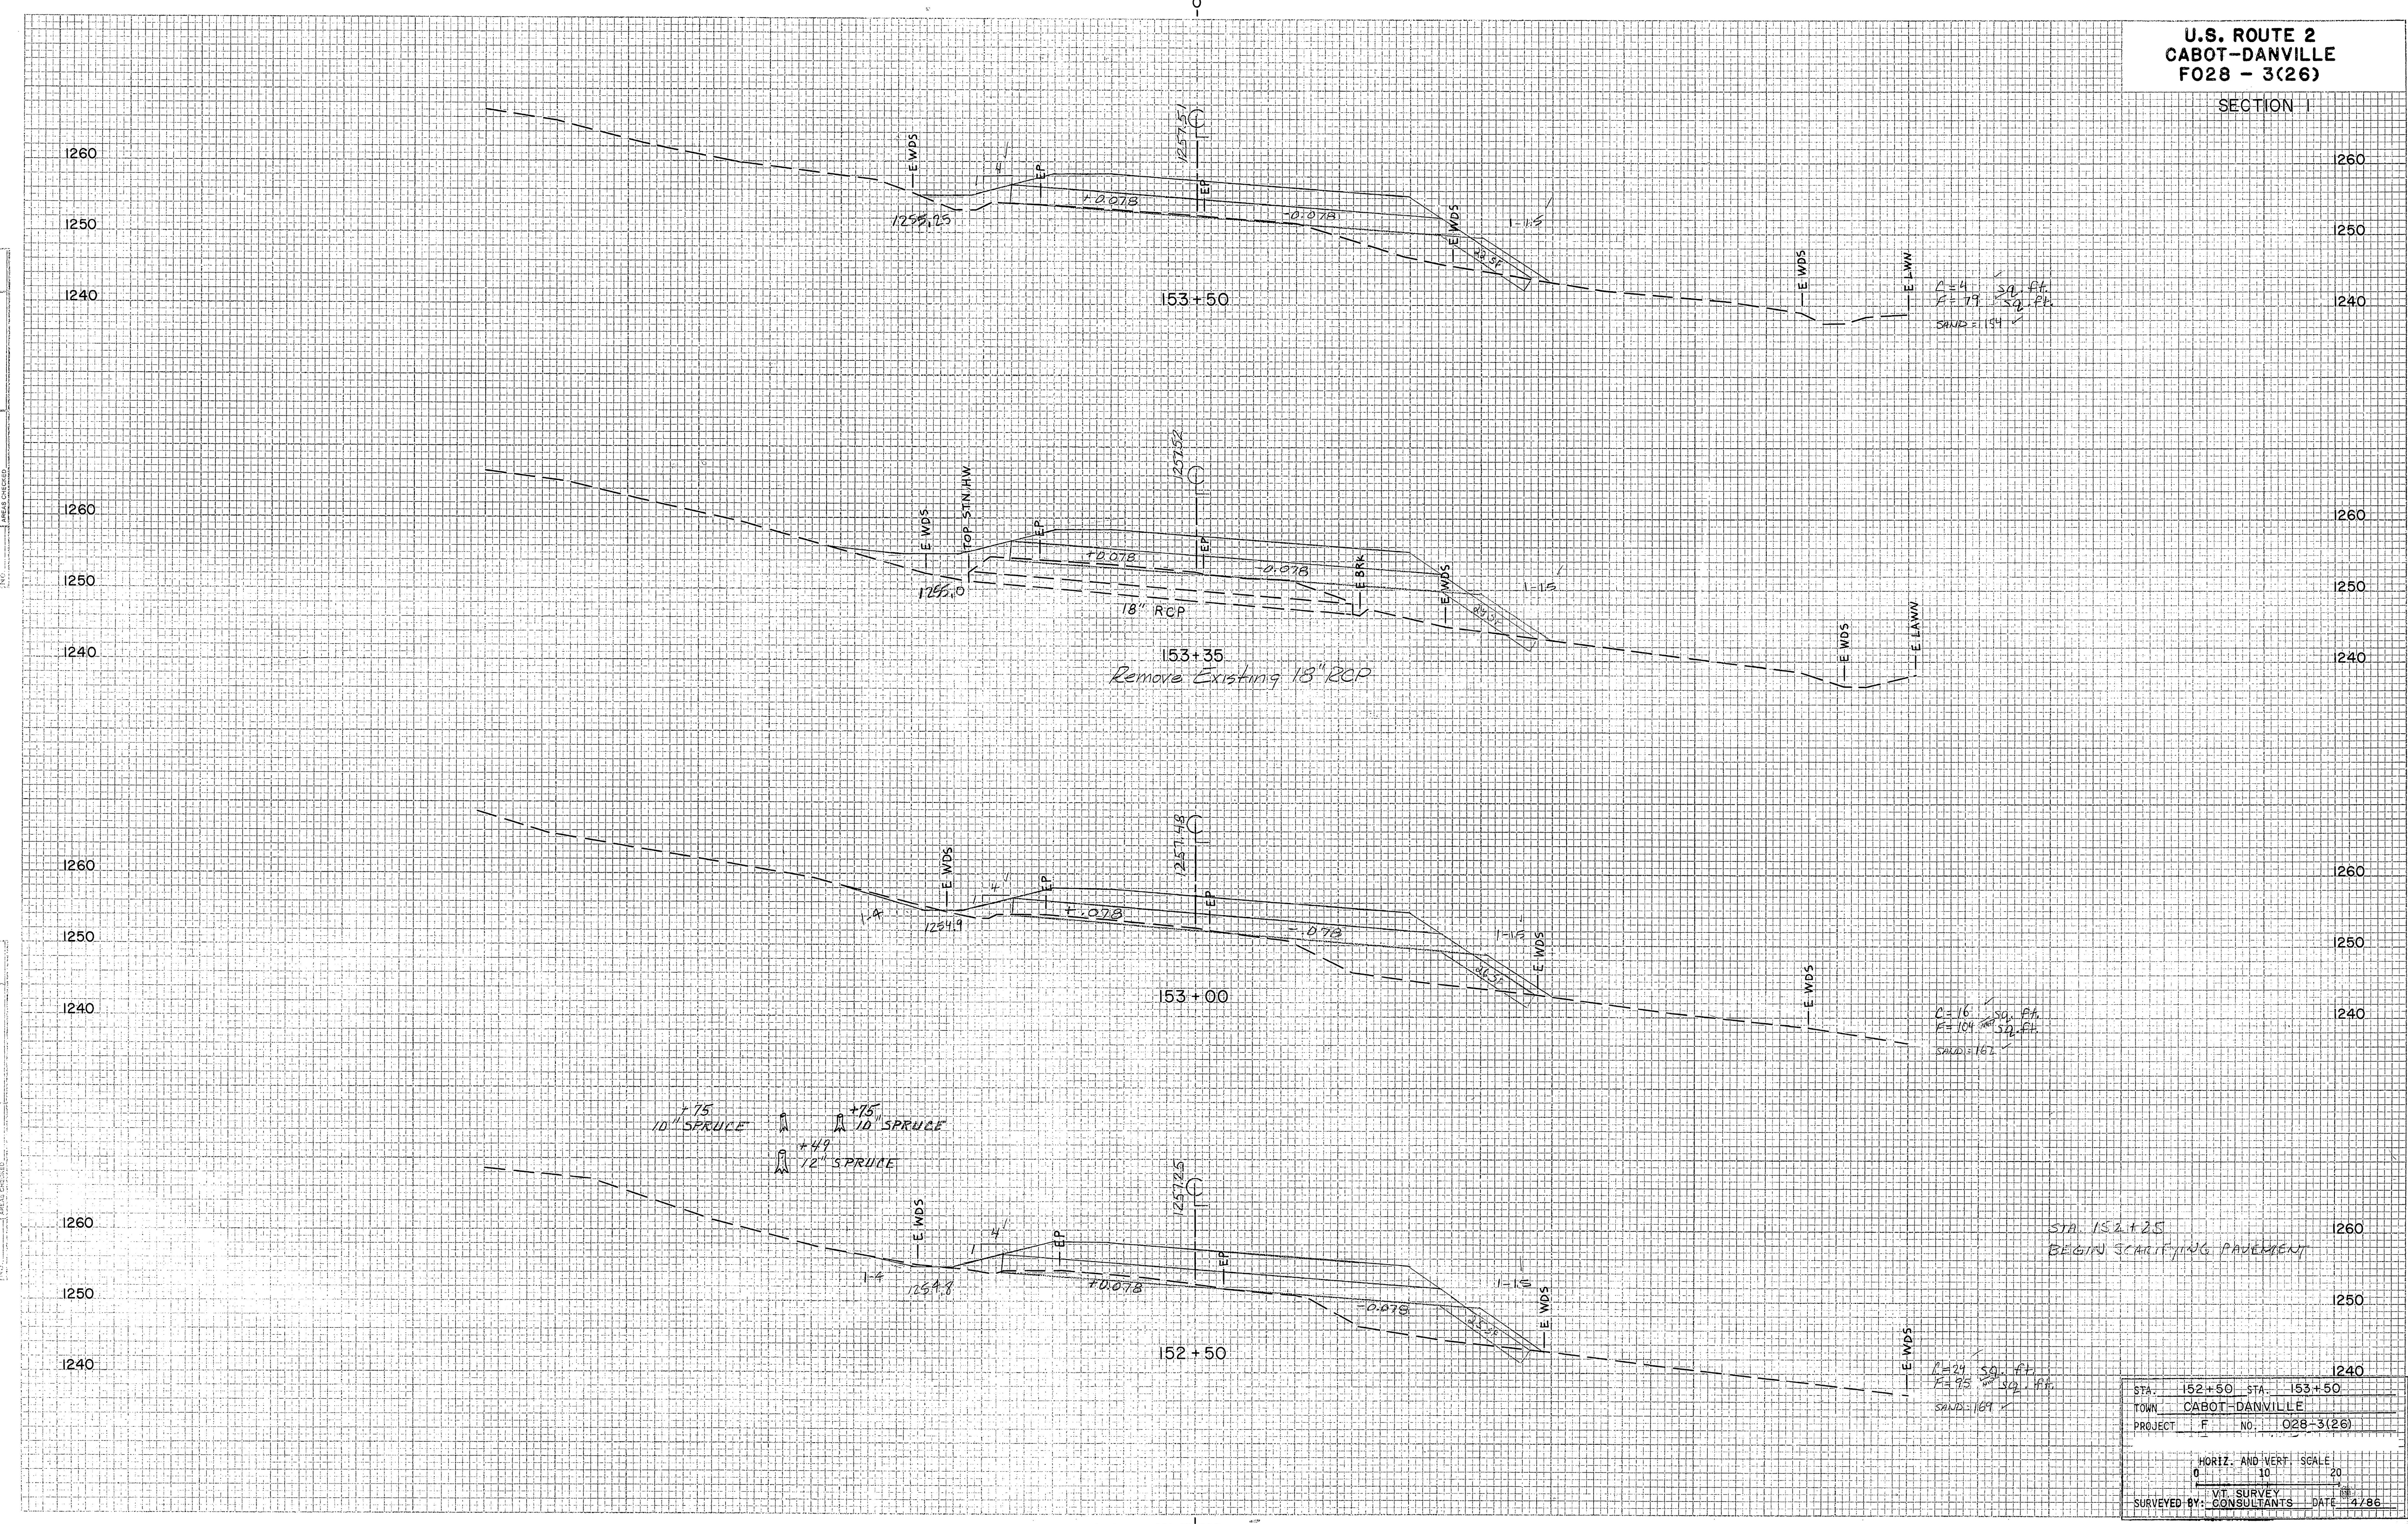

DATE	
BY	
REVISION	
NO.	
DESCRIPTION	

DATE	4/86
BY	VT SURVEY CONSULTANTS
REVISION	
NO.	
DESCRIPTION	

A=14
F=79
S=14
C=16
SAND=154

C=16
F=104
S=162
SAND=162

STA. 152+25
BEGIN SCARIFYING PAVEMENT

A=24
F=75
S=104
C=16
SAND=164

STA.	152+50	STA.	153+50
TOWN	CABOT-DANVILLE		
PROJECT	F	NO.	028-3(26)
HORIZ. AND VERT. SCALE			
0		20	
SURVEYED BY: VT SURVEY CONSULTANTS			
DATE: 4/86			

PROJECT NAME: CABOT-DANVILLE
 PROJECT NUMBER: FECC F 028-3(26) C/1
 FILE NAME: 78d058xs.dgn
 PROJECT LEADER: K. ROBIE
 DESIGNED BY: I. SHEA
 MAINLINE CROSS SECTIONS 40
 PLOT DATE: 06-OCT-2010
 DRAWN BY: I. SHEA
 CHECKED BY: S. MENARD
 SHEET 172 OF 250