

U.S. ROUTE 2
CABOT-DANVILLE
F028 - 3(26)
SECTION 1

DATE	
BY	
SURVEYED	
PLOTTED	
AREA	
AREAS CHECKED	
FINAL SURVEY NOTE BOOK NO.	

DATE	
BY	
SURVEYED	
PLOTTED	
AREA	
AREAS CHECKED	
FINAL SURVEY NOTE BOOK NO.	

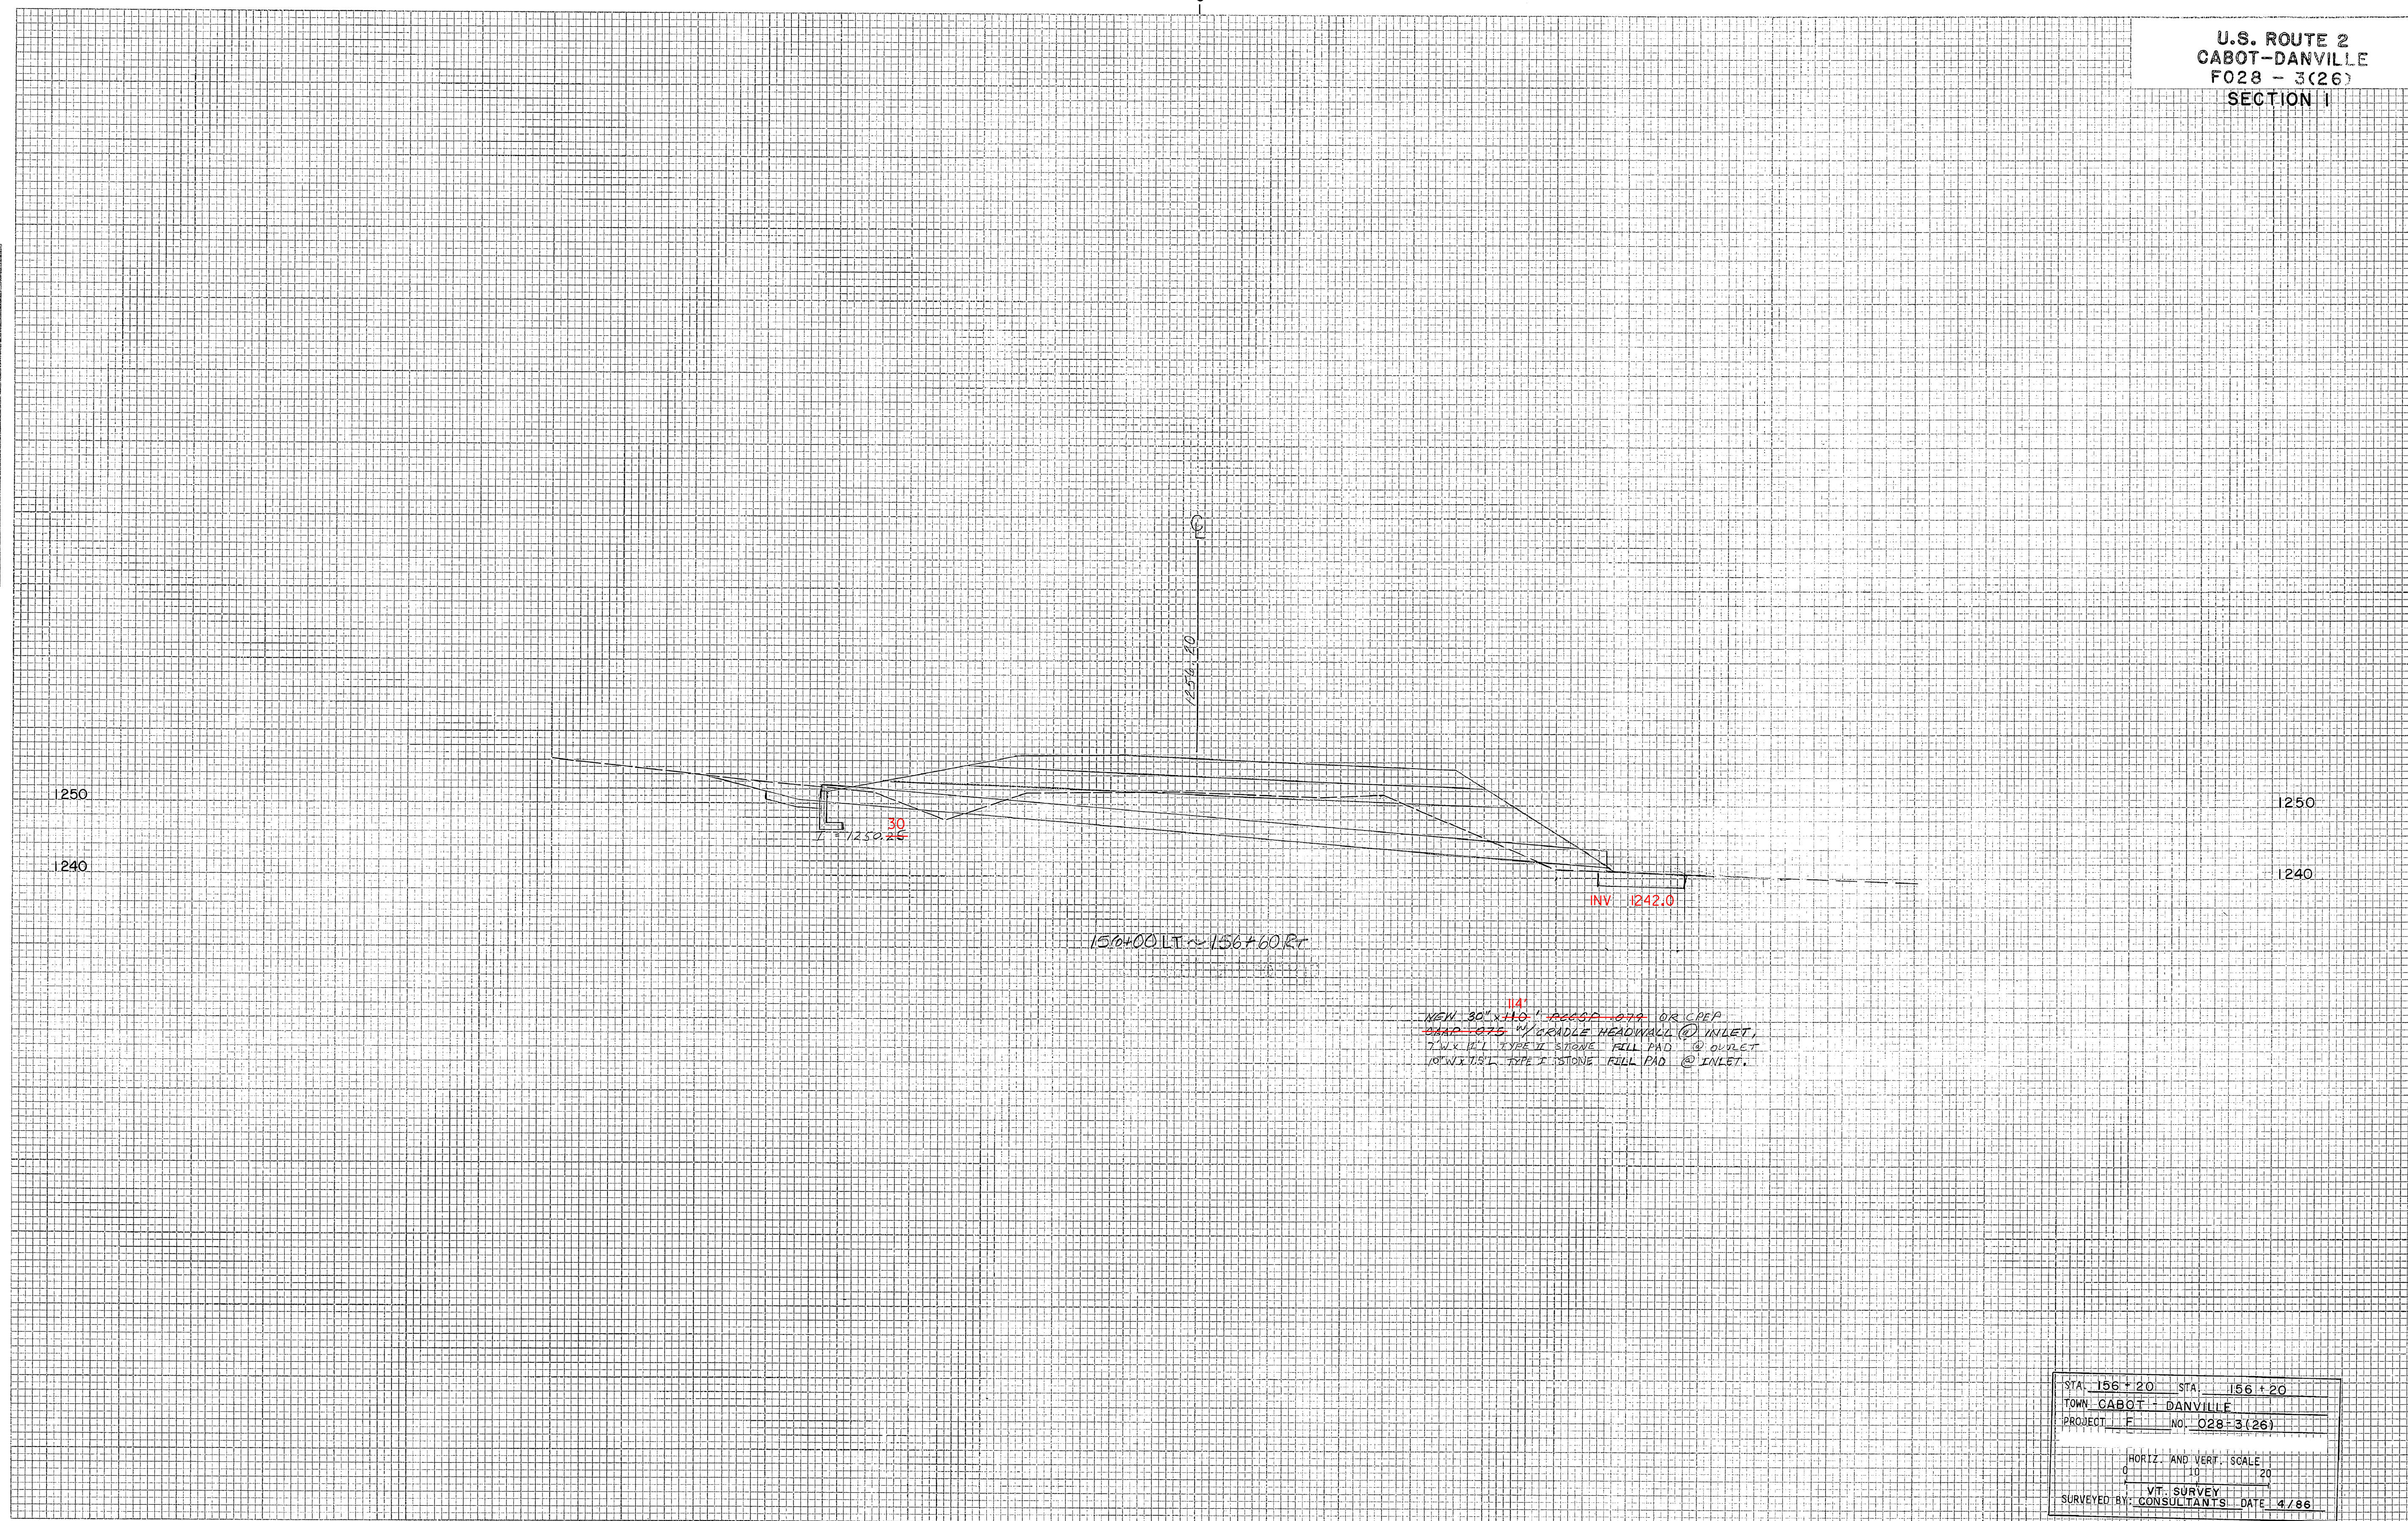


PLATE 3 CROSS SECTION O. P. R. & R. E. STANDARD
DUTCHEN CORPORATION

STA: 156+20	STA: 156+20
TOWN: CABOT - DANVILLE	
PROJECT: F	NO. 028-3(26)
HORIZ. AND VERT. SCALE	
1" = 10'	1" = 20'
VT. SURVEY	
SURVEYED BY: CONSULTANTS	DATE: 4/86

PROJECT NAME:	CABOT-DANVILLE	PLOT DATE:	06-OCT-2010
PROJECT NUMBER:	FEGC F 028-3(26) C/1	DRAWN BY:	I. SHEA
FILE NAME:	78d058xs.dgn	CHECKED BY:	S. MENARD
DESIGNED BY:	I. SHEA	MAINLINE CROSS SECTIONS:	43
		SHEET:	175 OF 250