


**U.S. ROUTE 2
CABOT-DANVILLE
FO28 - 3(26)**
SECTION 1

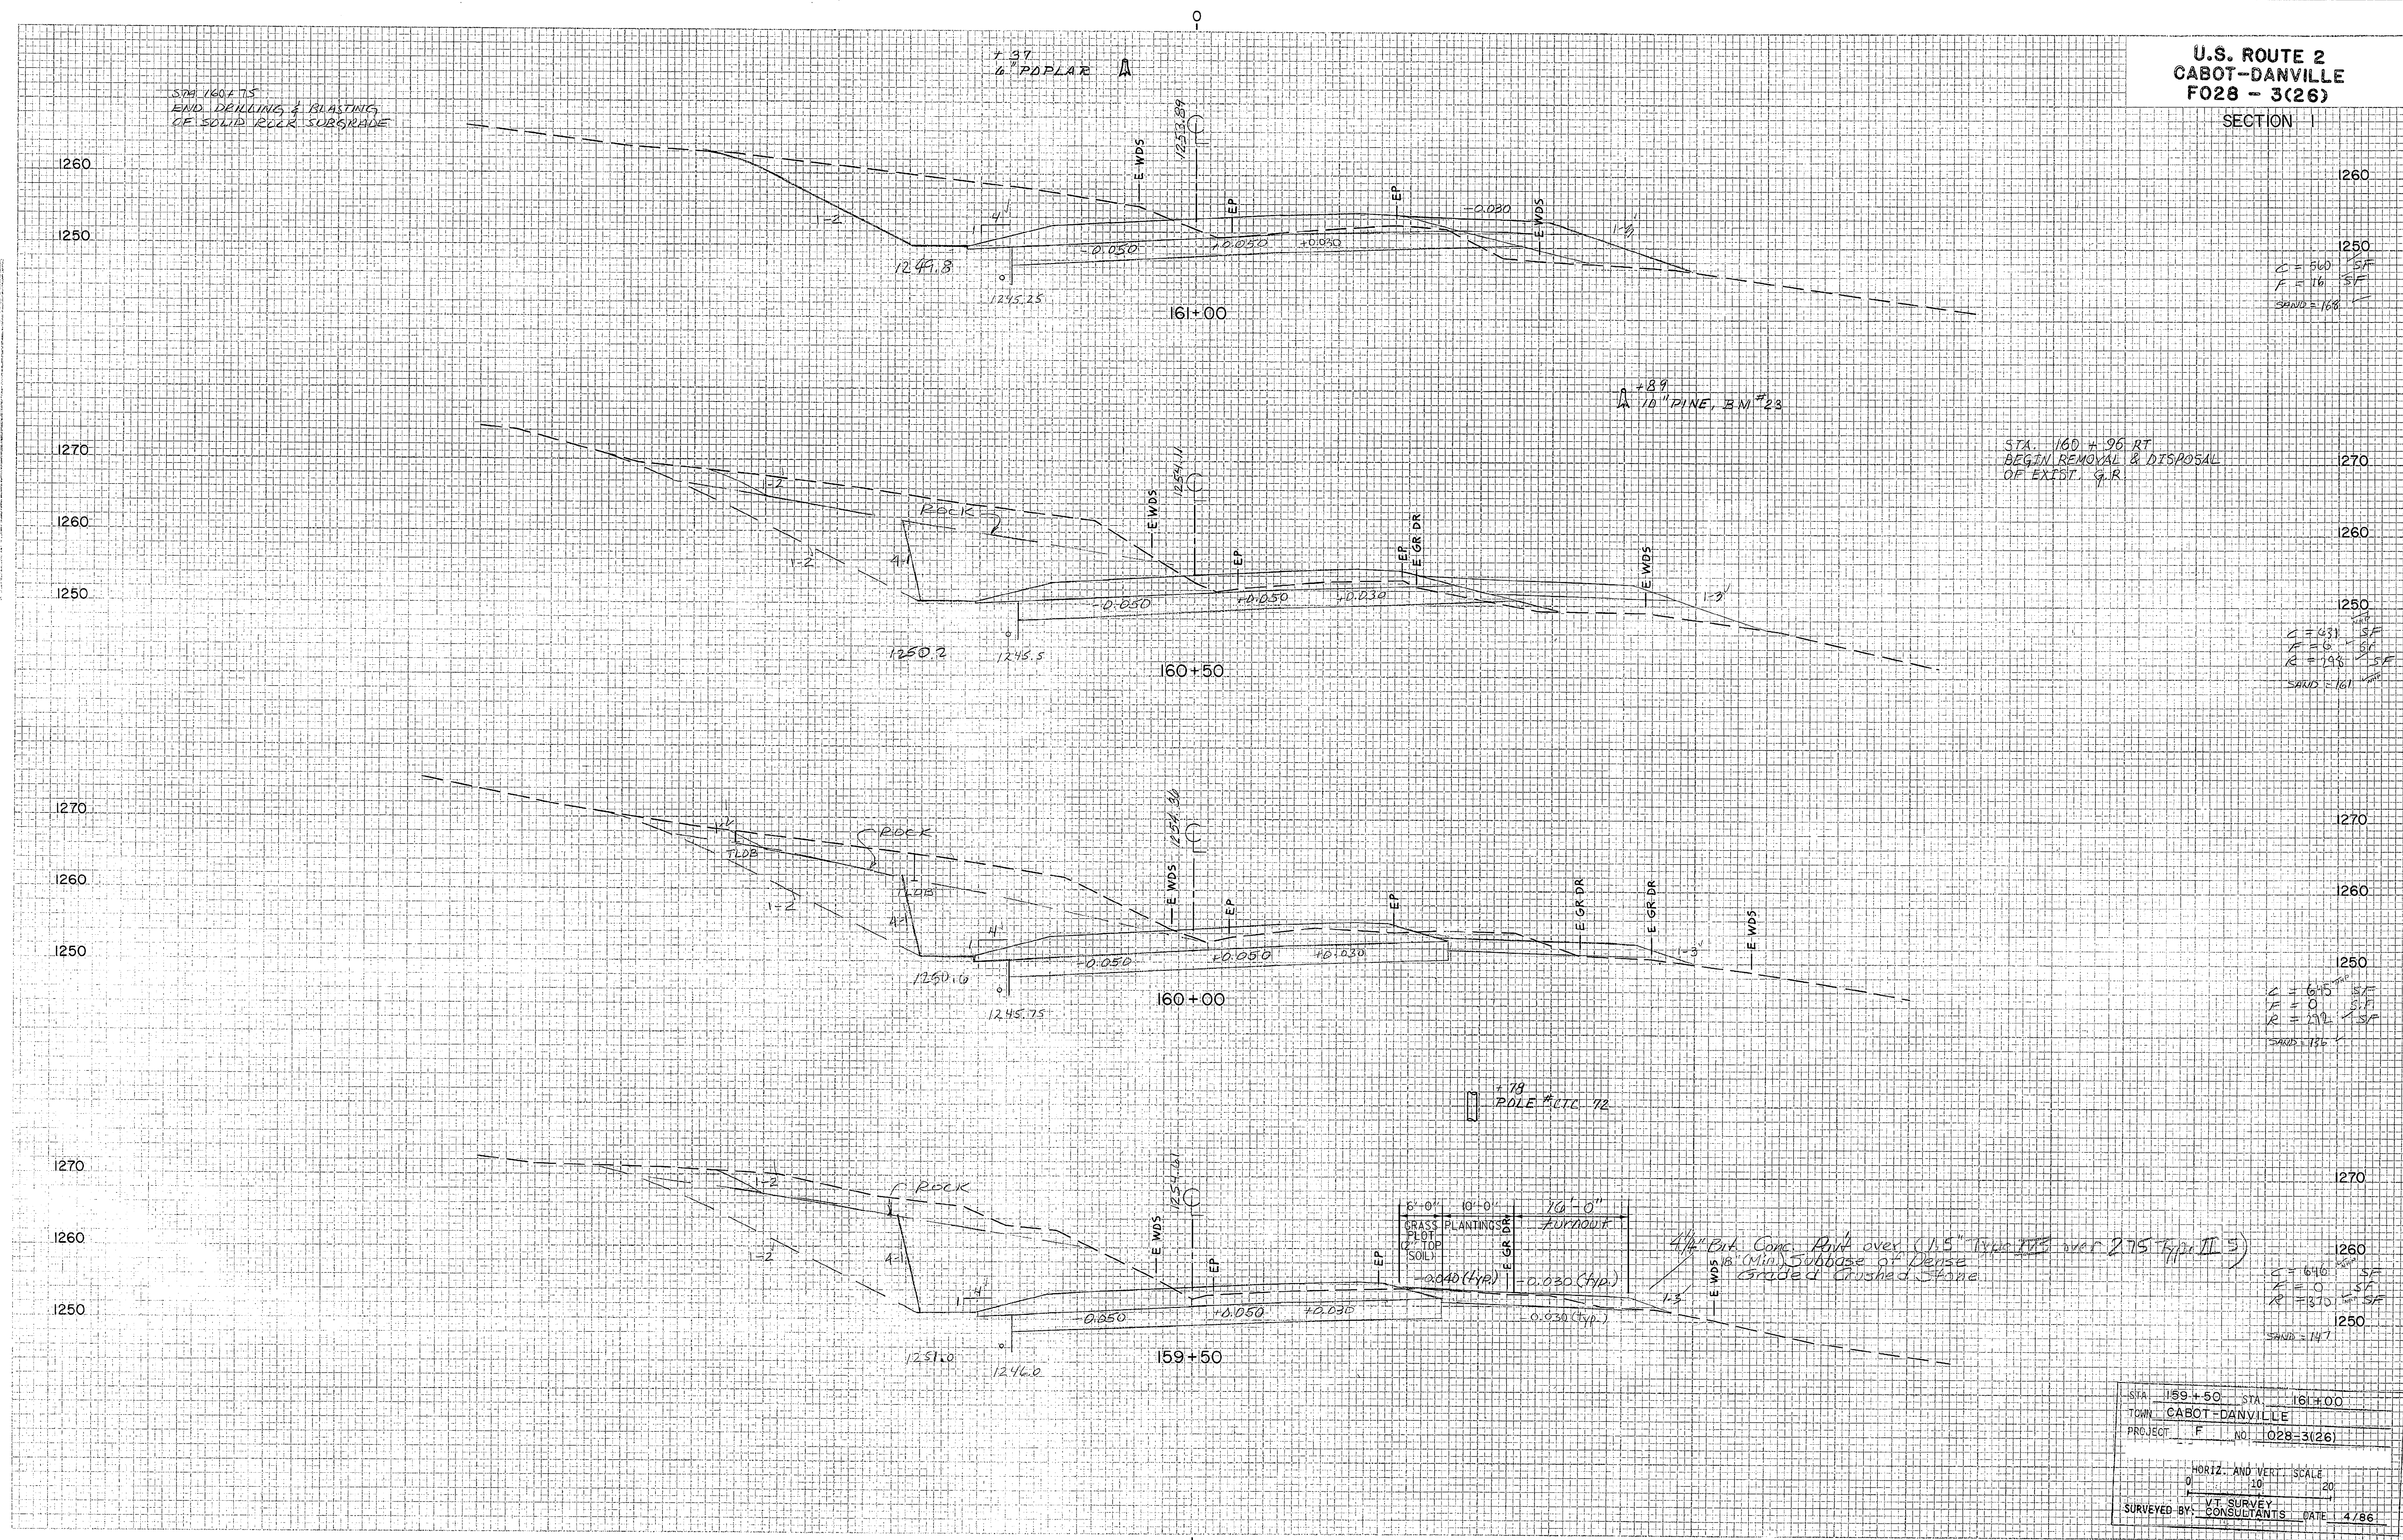

C = 560 SF
F = 16 SF
SAGS = 118

C = 431 SF
F = 0 SF
R = 198 SF
SAGS = 161

C = 615 SF
F = 0 SF
R = 170 SF
SAGS = 156

C = 646 SF
F = 0 SF
R = 1870 SF
SAGS = 147

STA 159+50	STA 161+00
TOWN CABOT-DANVILLE	
PROJECT F NO. 028-3(26)	
HORIZ. AND VERT. SCALE 1" = 10'	
SURVEYED BY: VT SURVEY CONSULTANTS DATE 4/86	

FINAL SHEET
NOTE BOOK

VT SURVEY CONSULTANTS
BRYANT ASSOC. 2/86

PLATE 2 CROSS SECTION OF U.S. ROUTE 2
DRAWN BY: I. SHEA

PROJECT NAME: CABOT-DANVILLE
PROJECT NUMBER: FECC F 028-3(26) C/1
FILE NAME: 78d058xs.dgn
PROJECT LEADER: K. ROBBIE
DESIGNED BY: I. SHEA
MAINLINE CROSS SECTIONS 45
PLOT DATE: 06-OCT-2010
DRAWN BY: I. SHEA
CHECKED BY: S. MENARD
SHEET 177 OF 250