

U.S. ROUTE 2  
CABOT-DANVILLE  
F028 - 3(26)

SECTION 1

C = 304 SF  
F = 0 SF  
SAND = 124 SF

C = 326 SF  
F = 0 SF  
SAND = 124 SF

DATE	
BY	
DIRECTED BY	
TEMPERATURE	
AREA	
NO.	

DATE	7/16
BY	J. SHEA
DIRECTED BY	K. ROBBIE
TEMPERATURE	
AREA	
NO.	

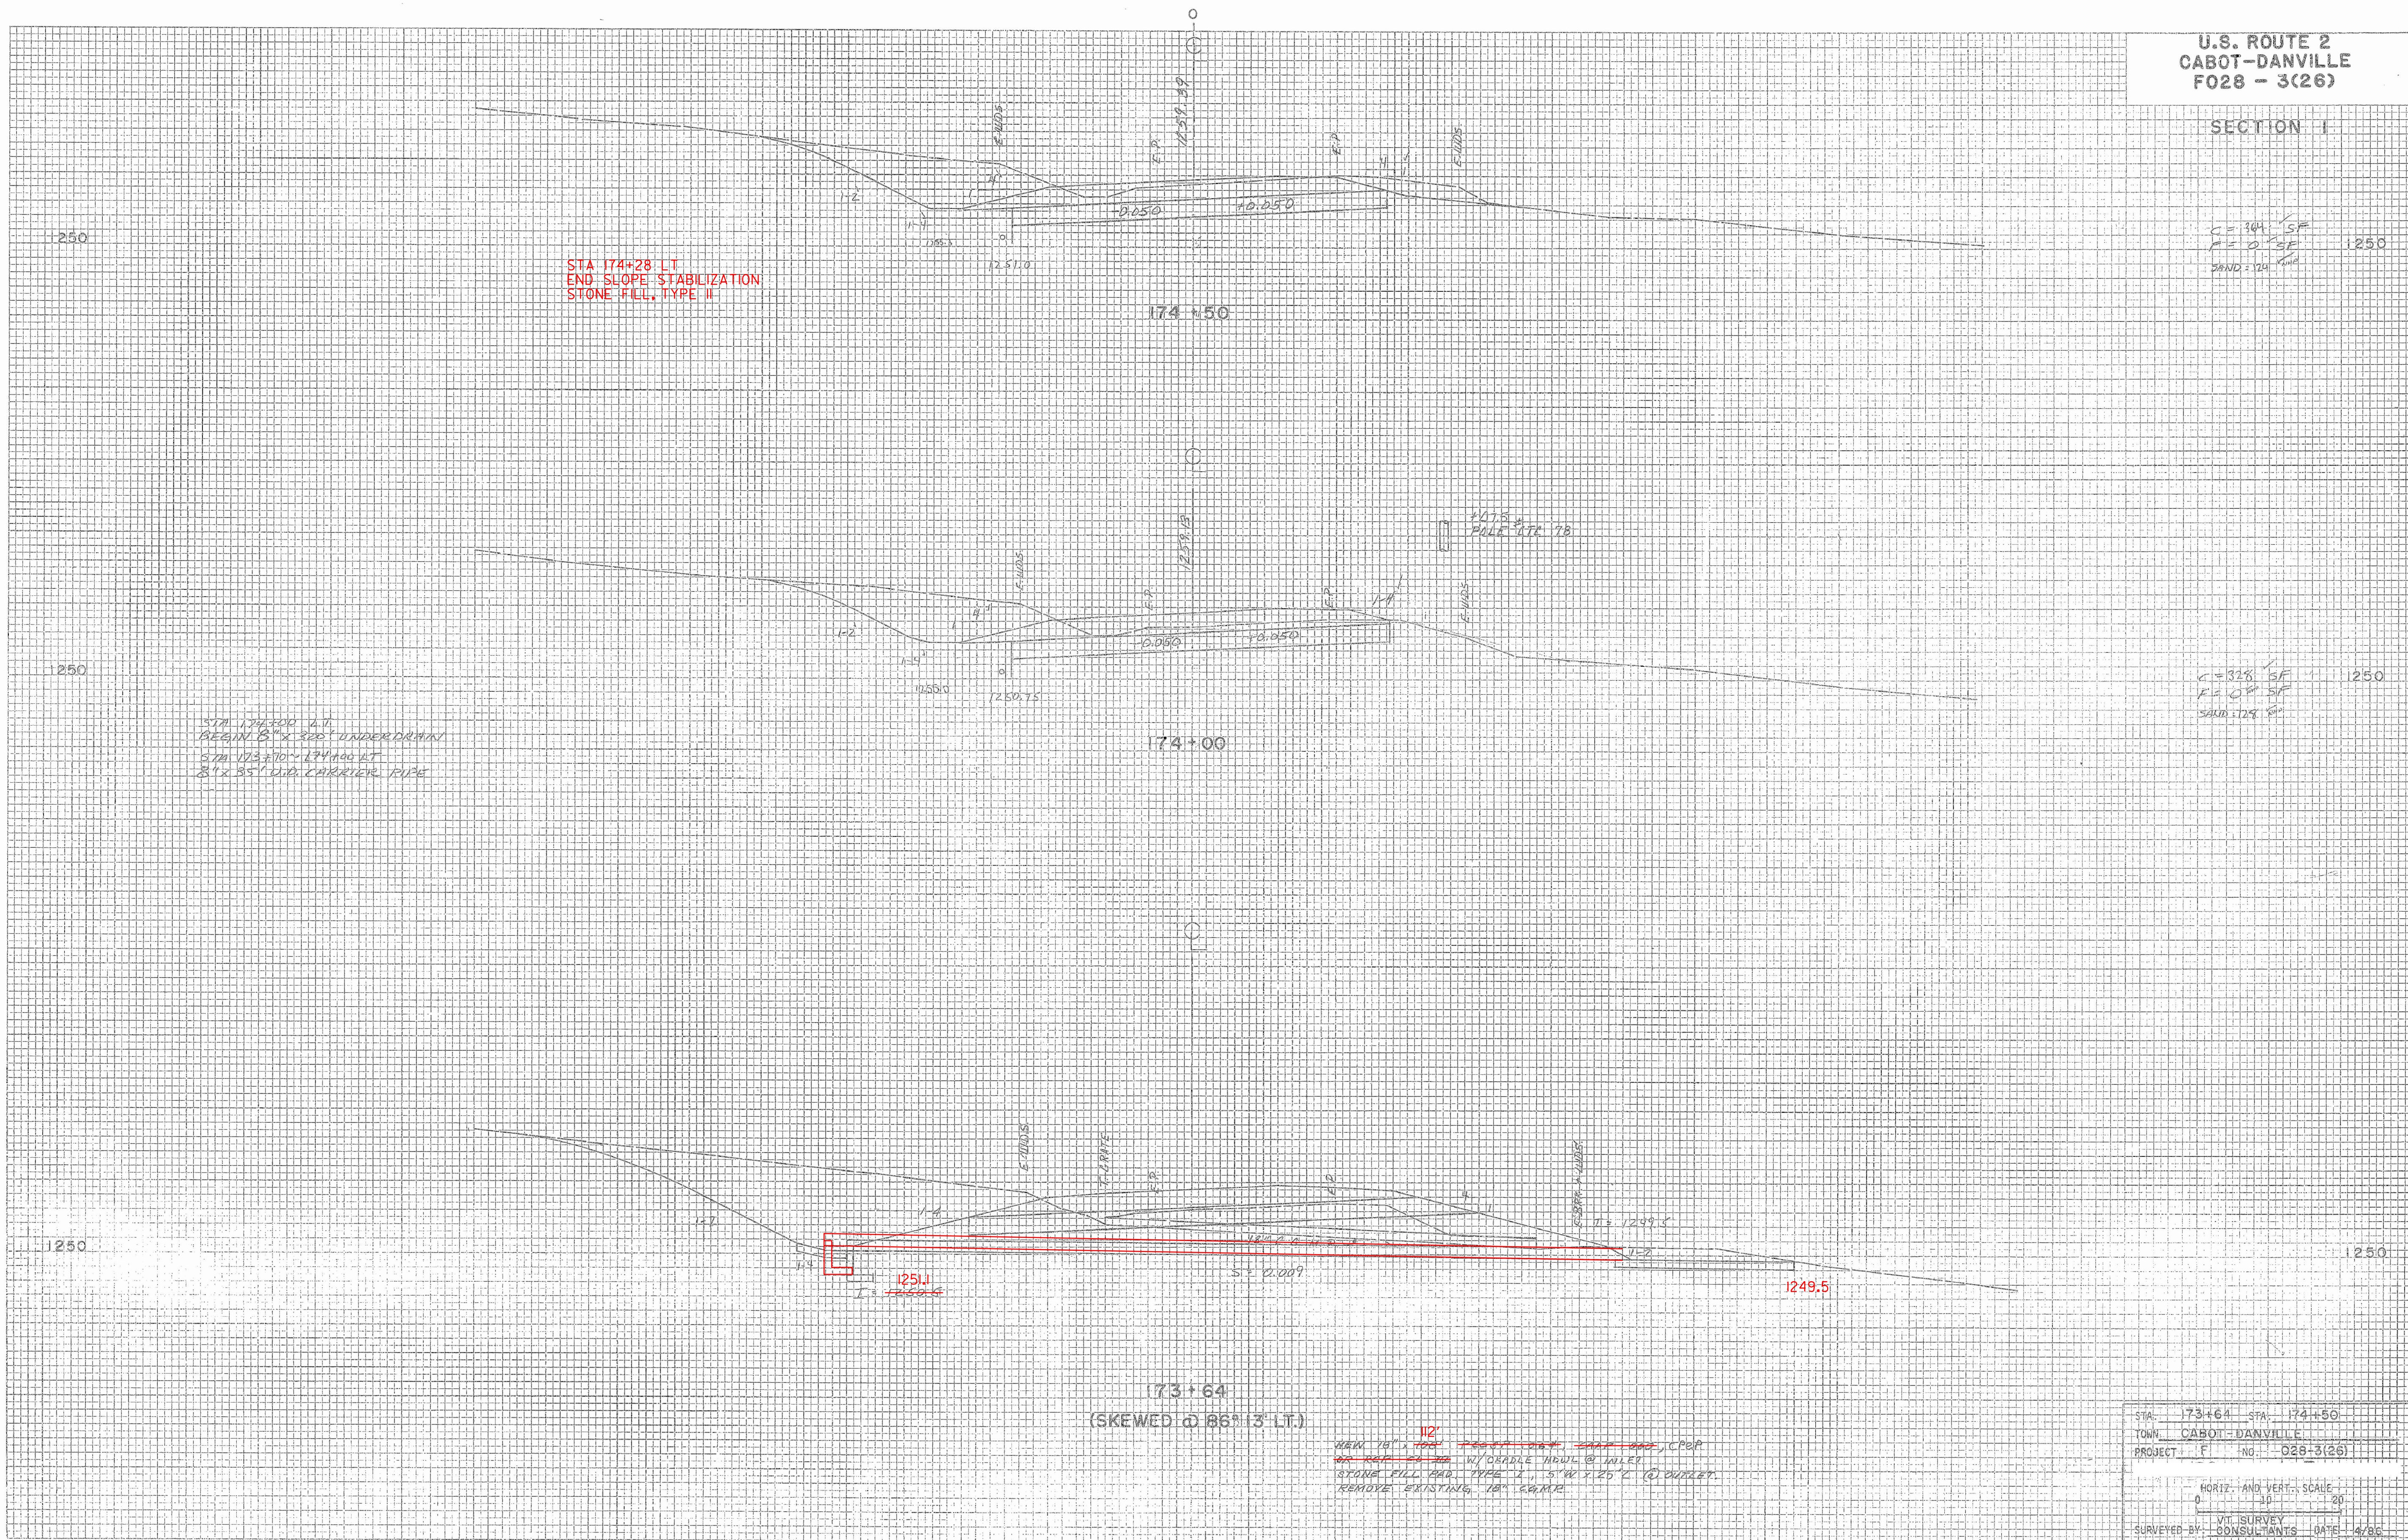


PLATE 2 CROSS SECTION 0. P. R. E. S. STANDARD  
DET. 02 - CORPORATION

STA.	173+64	STA.	174+50
TOWN	CABOT-DANVILLE		
PROJECT	F	NO.	028-3(26)
HORIZ. AND VERT. SCALE			
0 10 20			
DATE SURVEYED			
DATE 4/06			

PROJECT NAME:	CABOT-DANVILLE	PLOT DATE:	06-OCT-2010
PROJECT NUMBER:	FEGC F 028-3(26) C/1	DRAWN BY:	J. SHEA
FILE NAME:	78d058xs.dgn	CHECKED BY:	S. MENARD
DESIGNED BY:	J. SHEA	SHEET	188 OF 250
MAINLINE CROSS SECTIONS	56		