
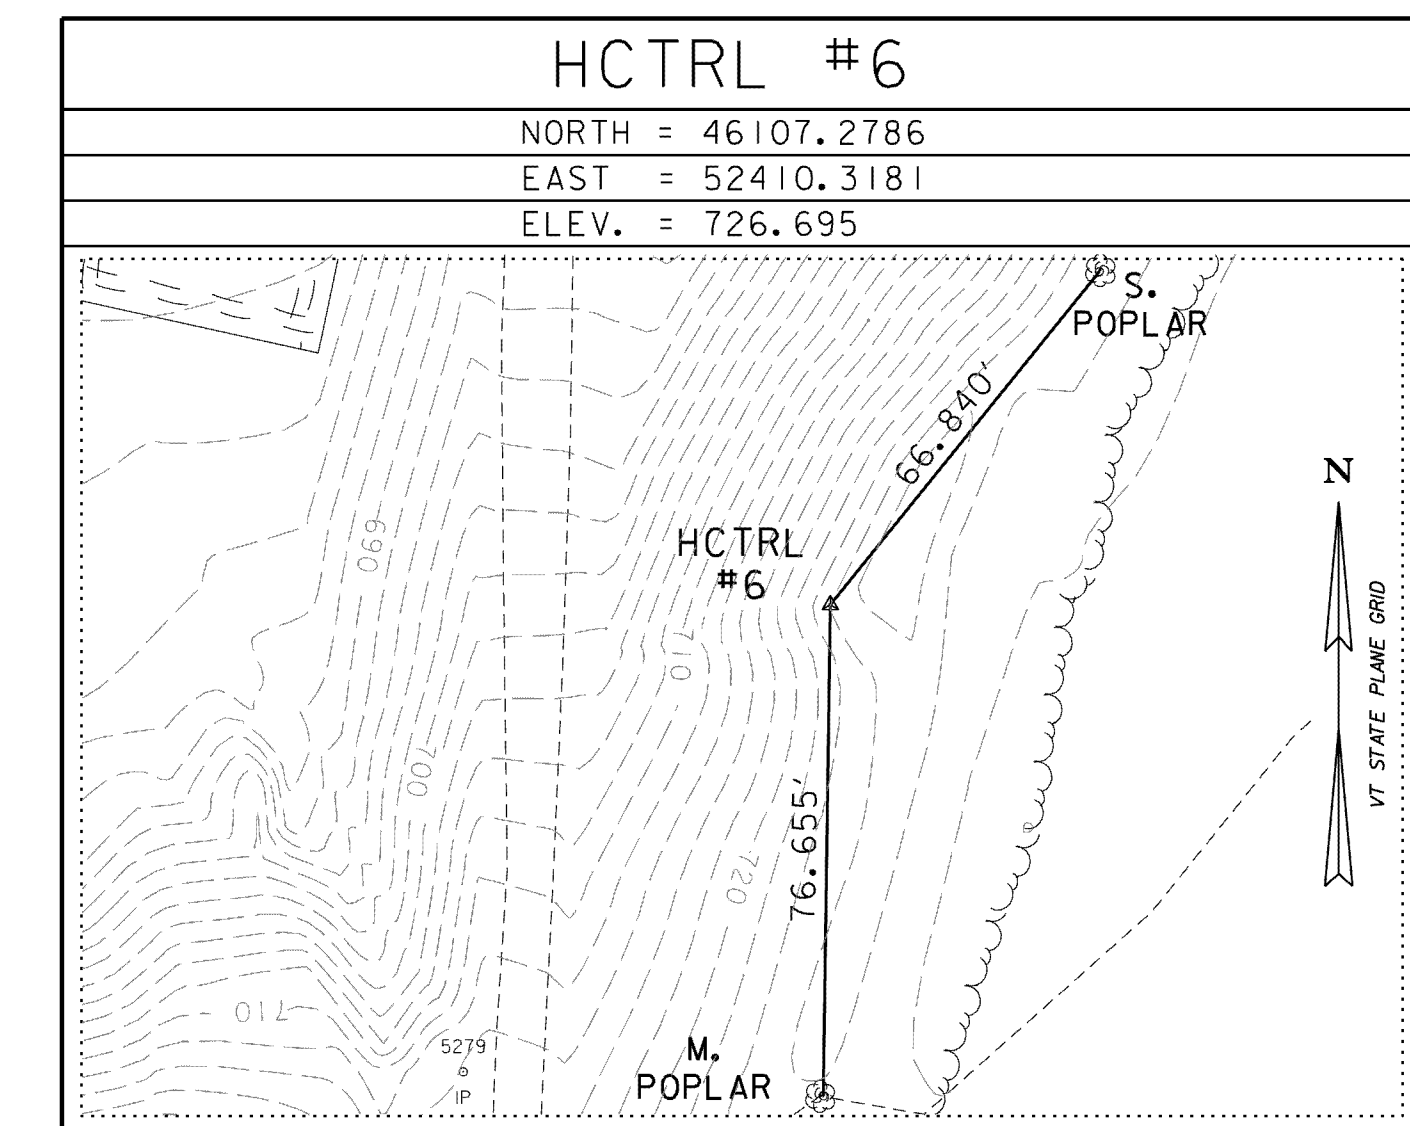
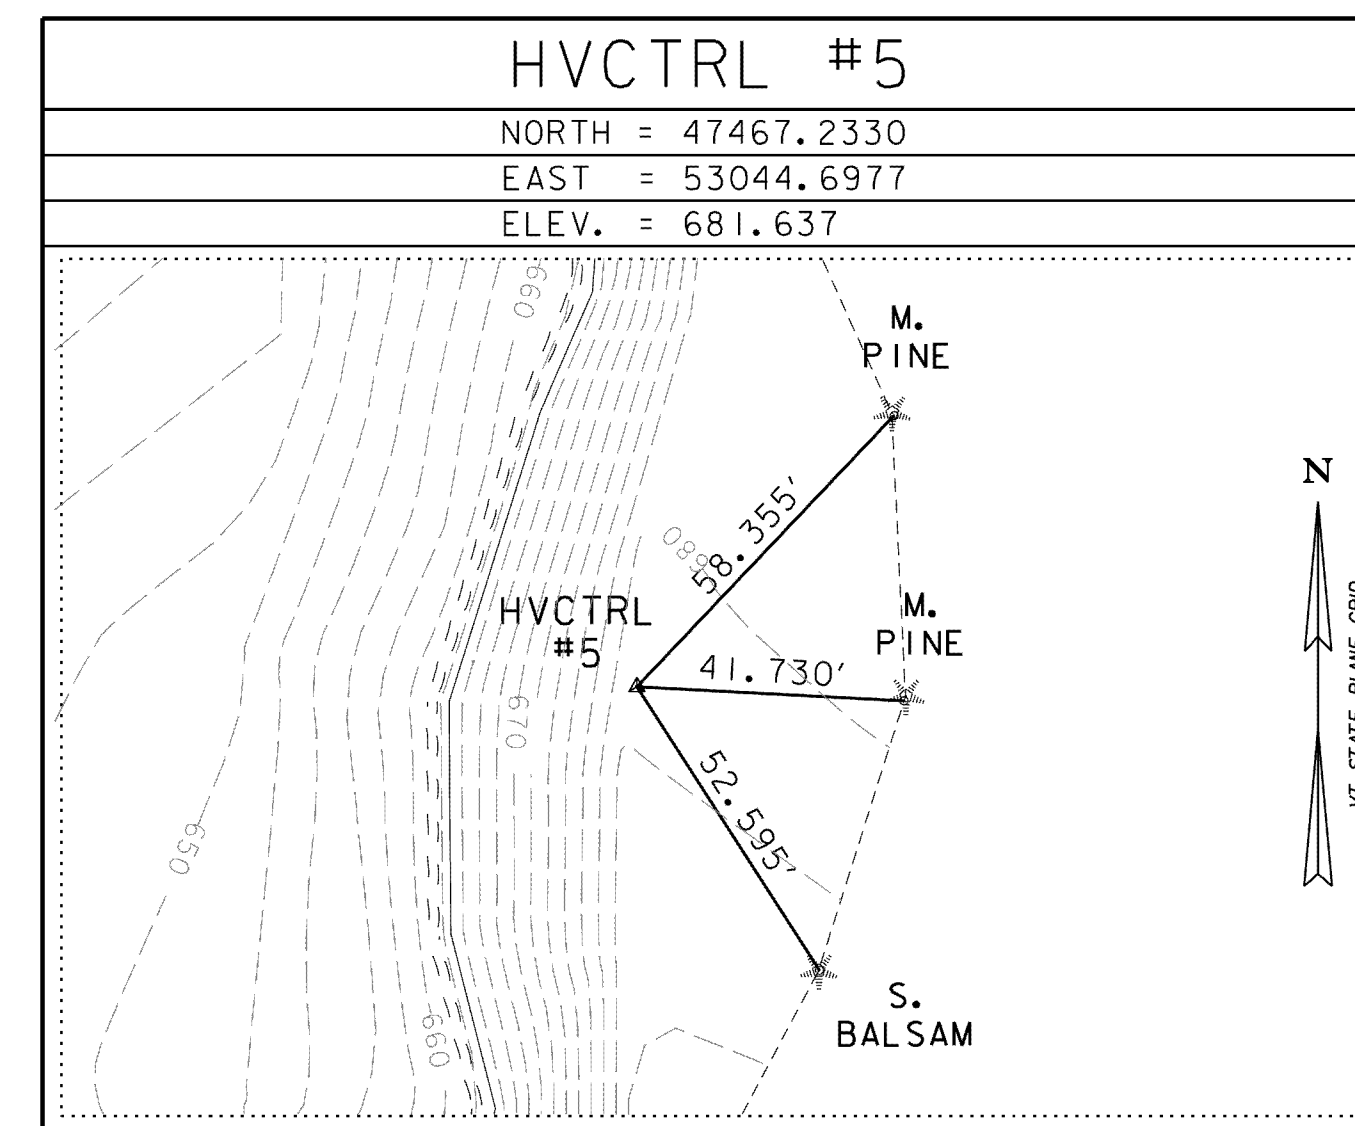
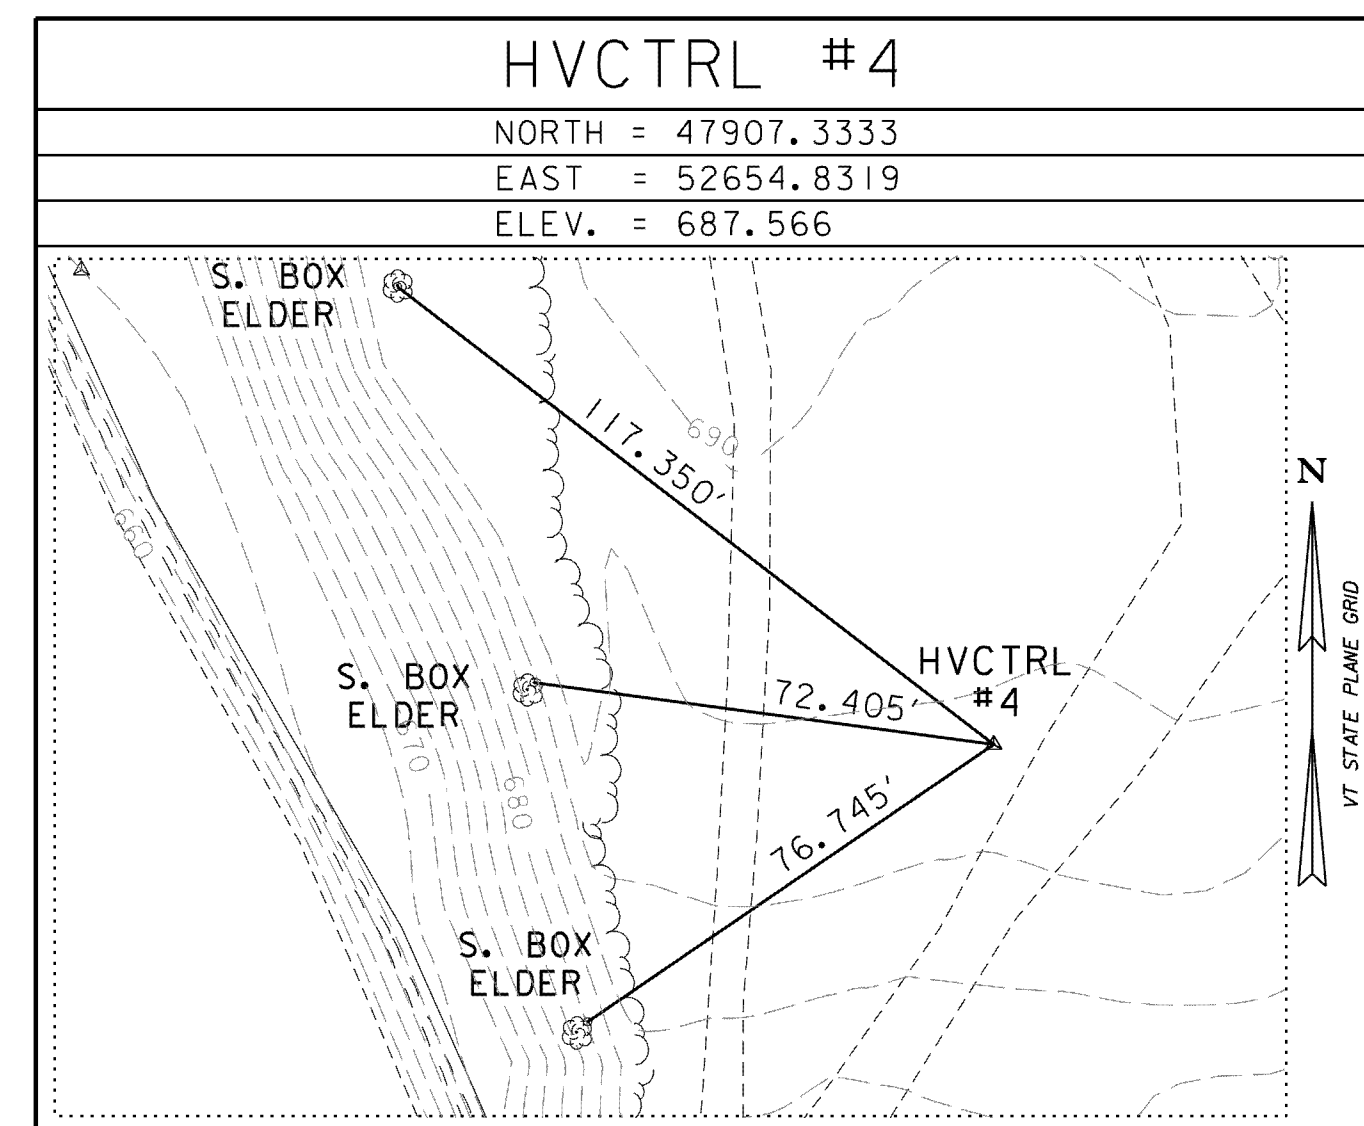


GPS CONTROL POINTS



KINGSBURY AZ MK

KINGSBURY

TRAVERSE TIES

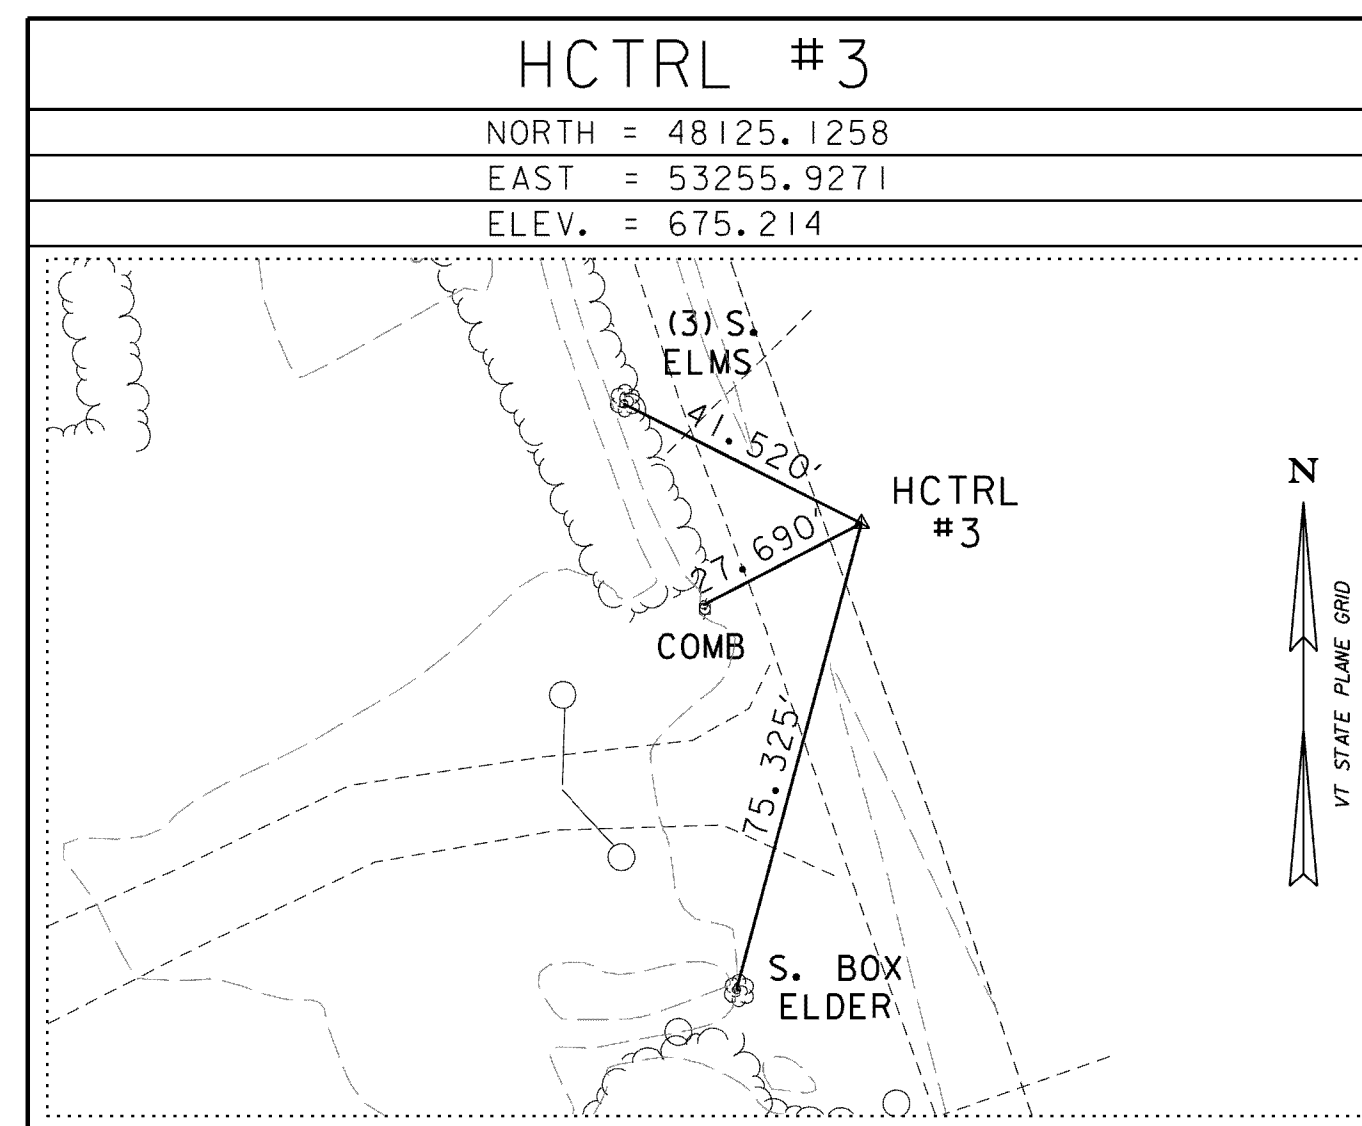

ALIGNMENT TIES

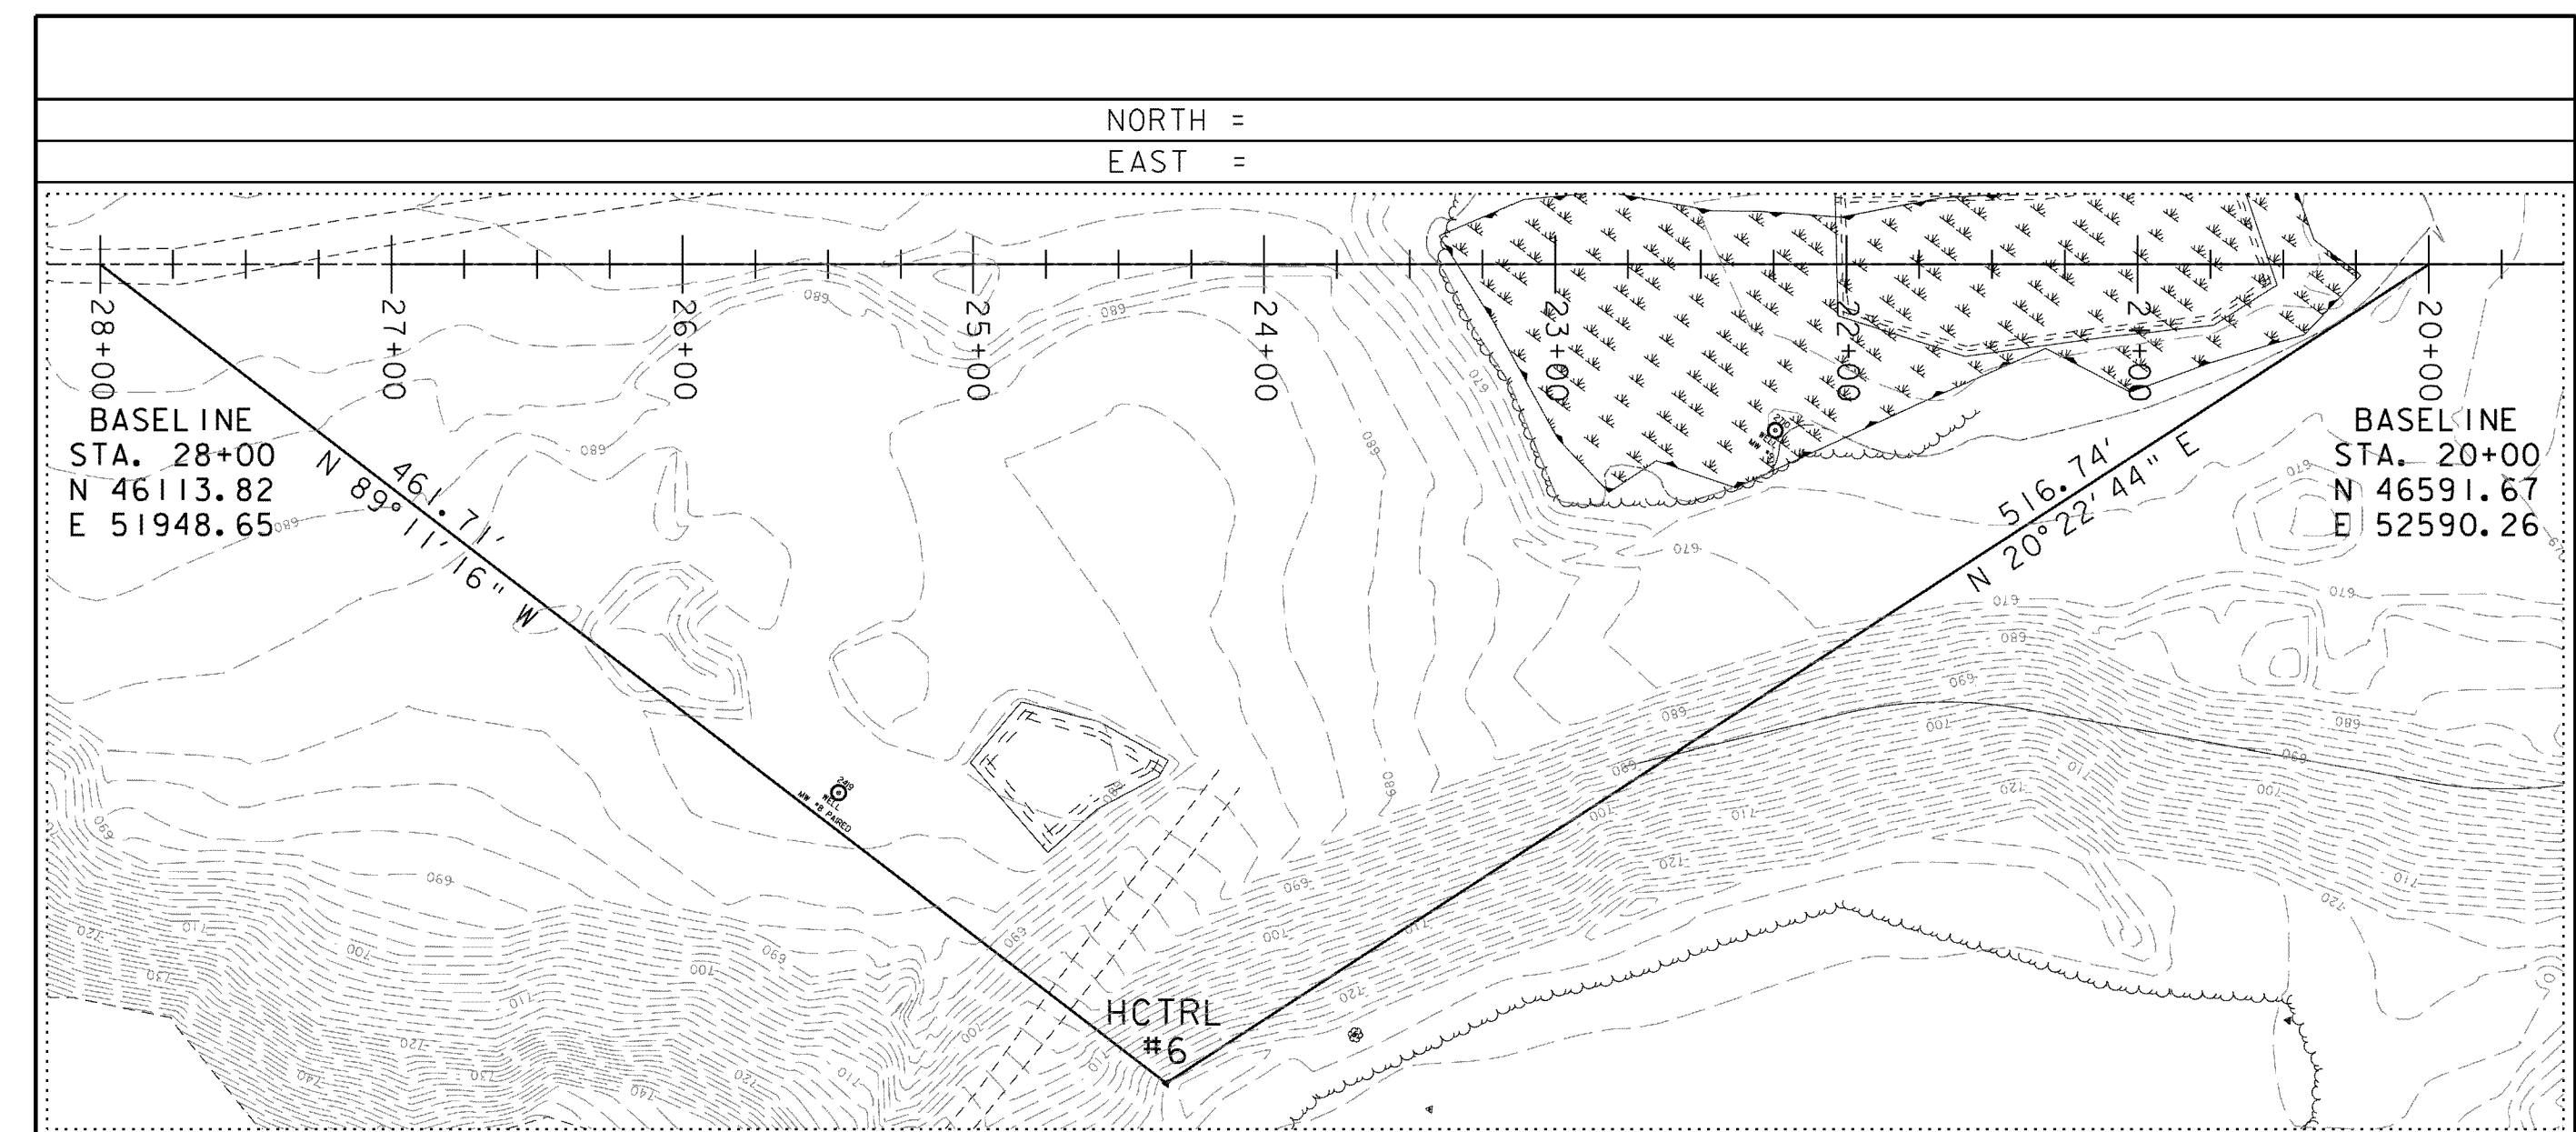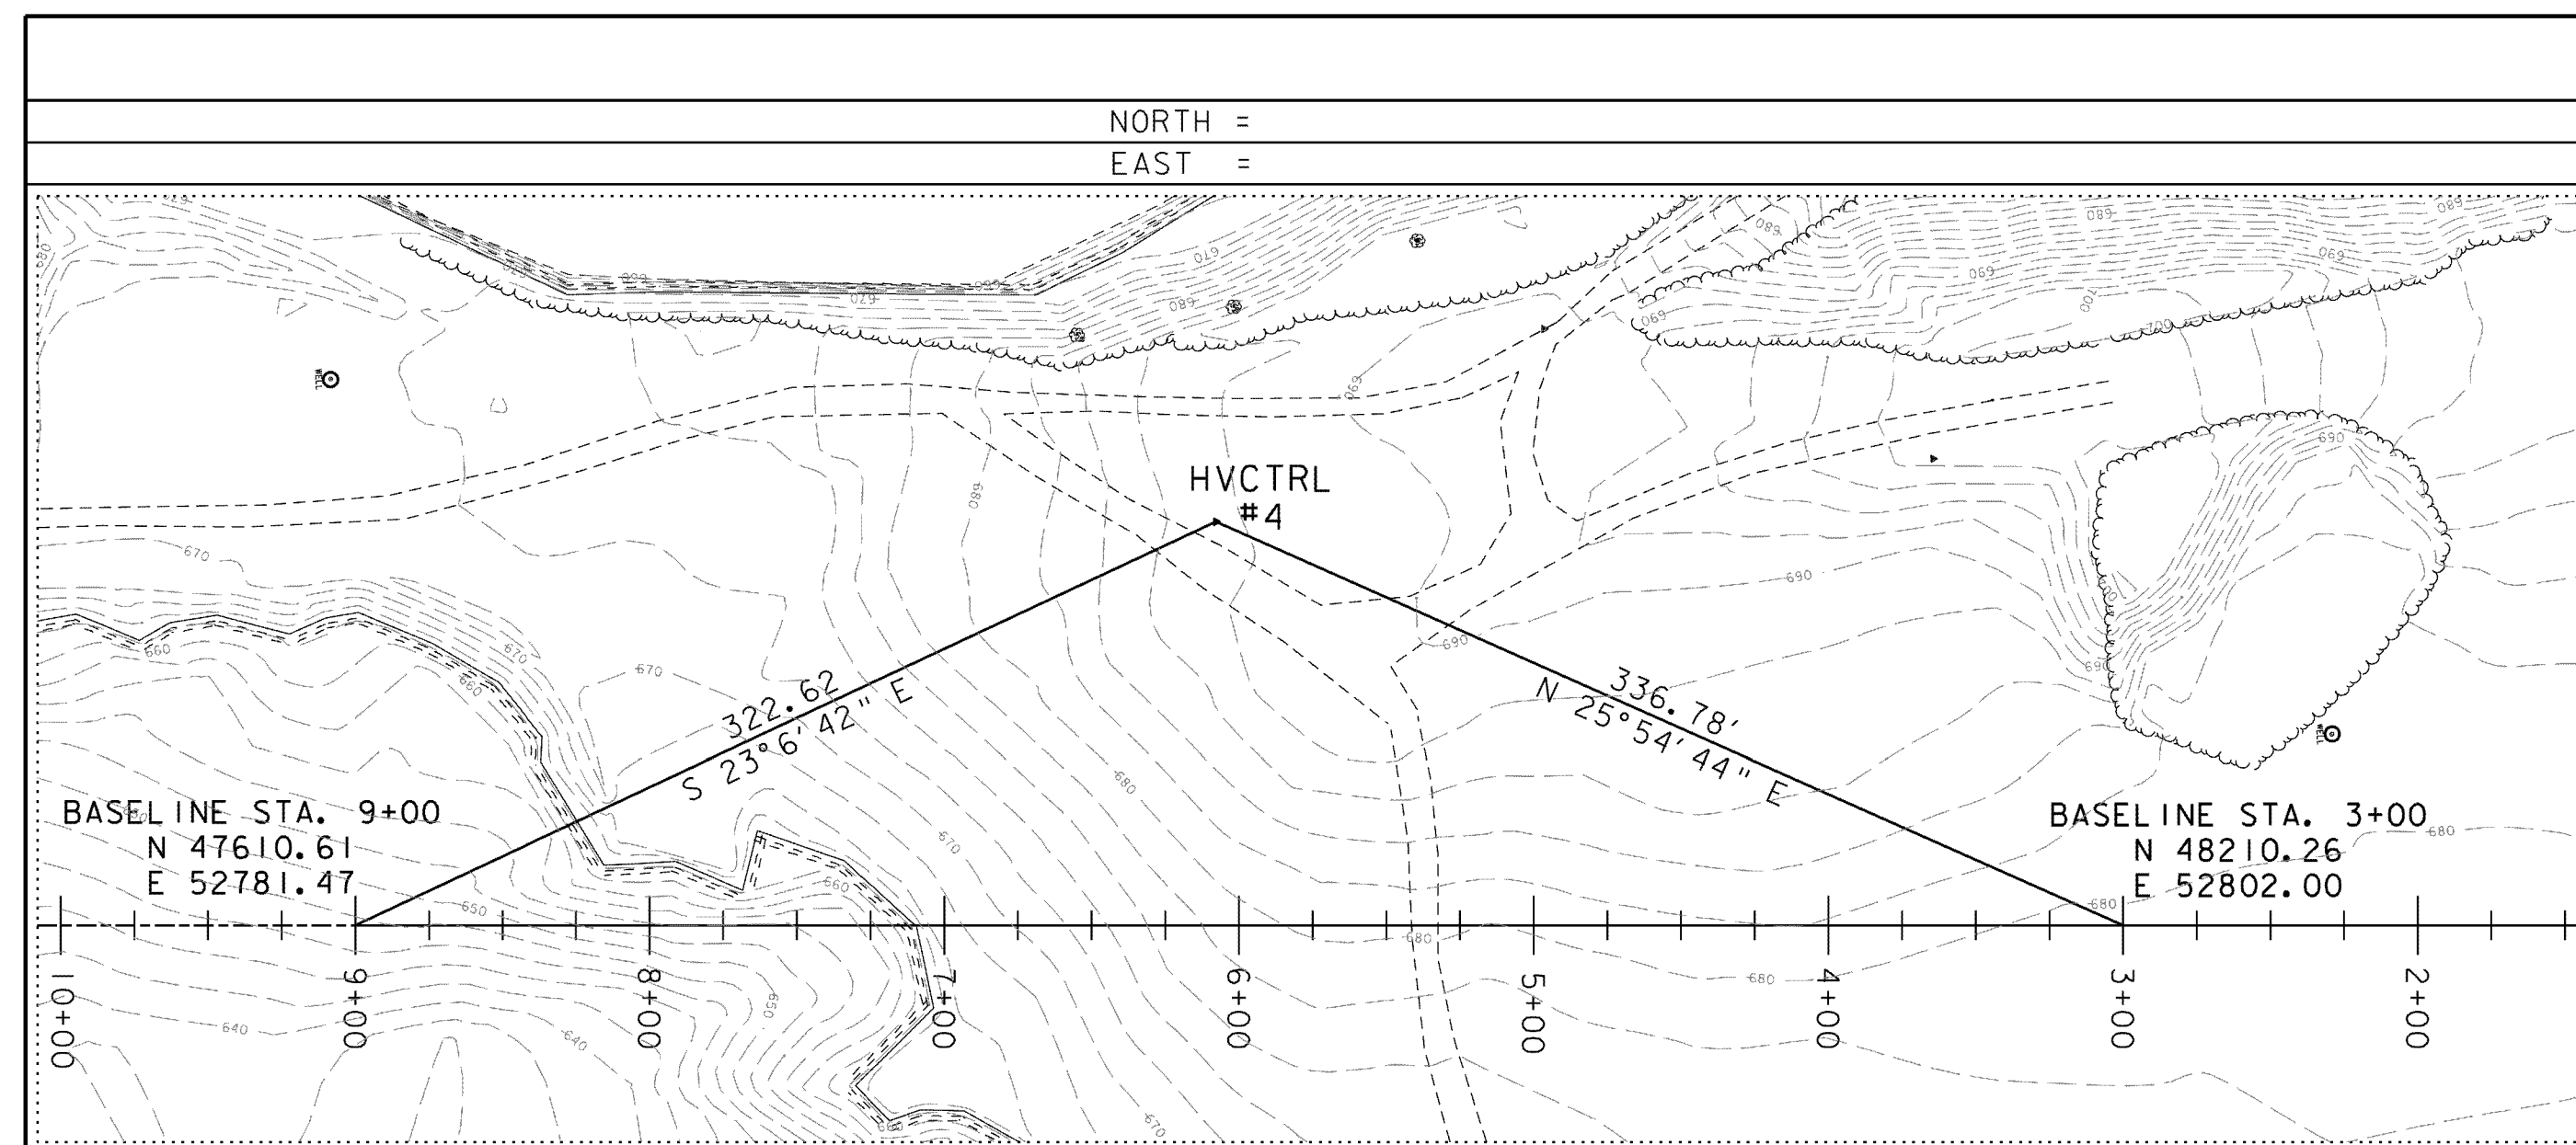

DATUM	
VERTICAL	NAD 83 (92)
HORIZONTAL	NAVD 88
ADJUSTMENT	-600000 FT N, -1600000 FT E

PROJECT NAME:	CABOT-DANVILLE	PLOT DATE:	9/30/2010
PROJECT NUMBER:	FECG F 028-3(26)	PROJECT LEADER:	C.W. BRODIE
FILE NAME:	xd079t1e.dgn	DESIGNED BY:	C.W. BRODIE
		CHECKED BY:	J.K. BENSON
		TIE SHEET	SHEET 196 OF 250