


**END PROJECT STA. 36+10
END YEAR 1 MITIGATION FOR
HIGHWAY SEGMENT ONE STA. 36+10.00**

**END YEAR 2 MITIGATION
BEGIN YEAR 1 MITIGATION FOR
HIGHWAY SEGMENT ONE STA. 29+00.00**

**BEGIN YEAR 2 MITIGATION FOR
HIGHWAY SEGMENT ONE STA. 16+00.00**


**BEGIN PROJECT
STA. 0+00**

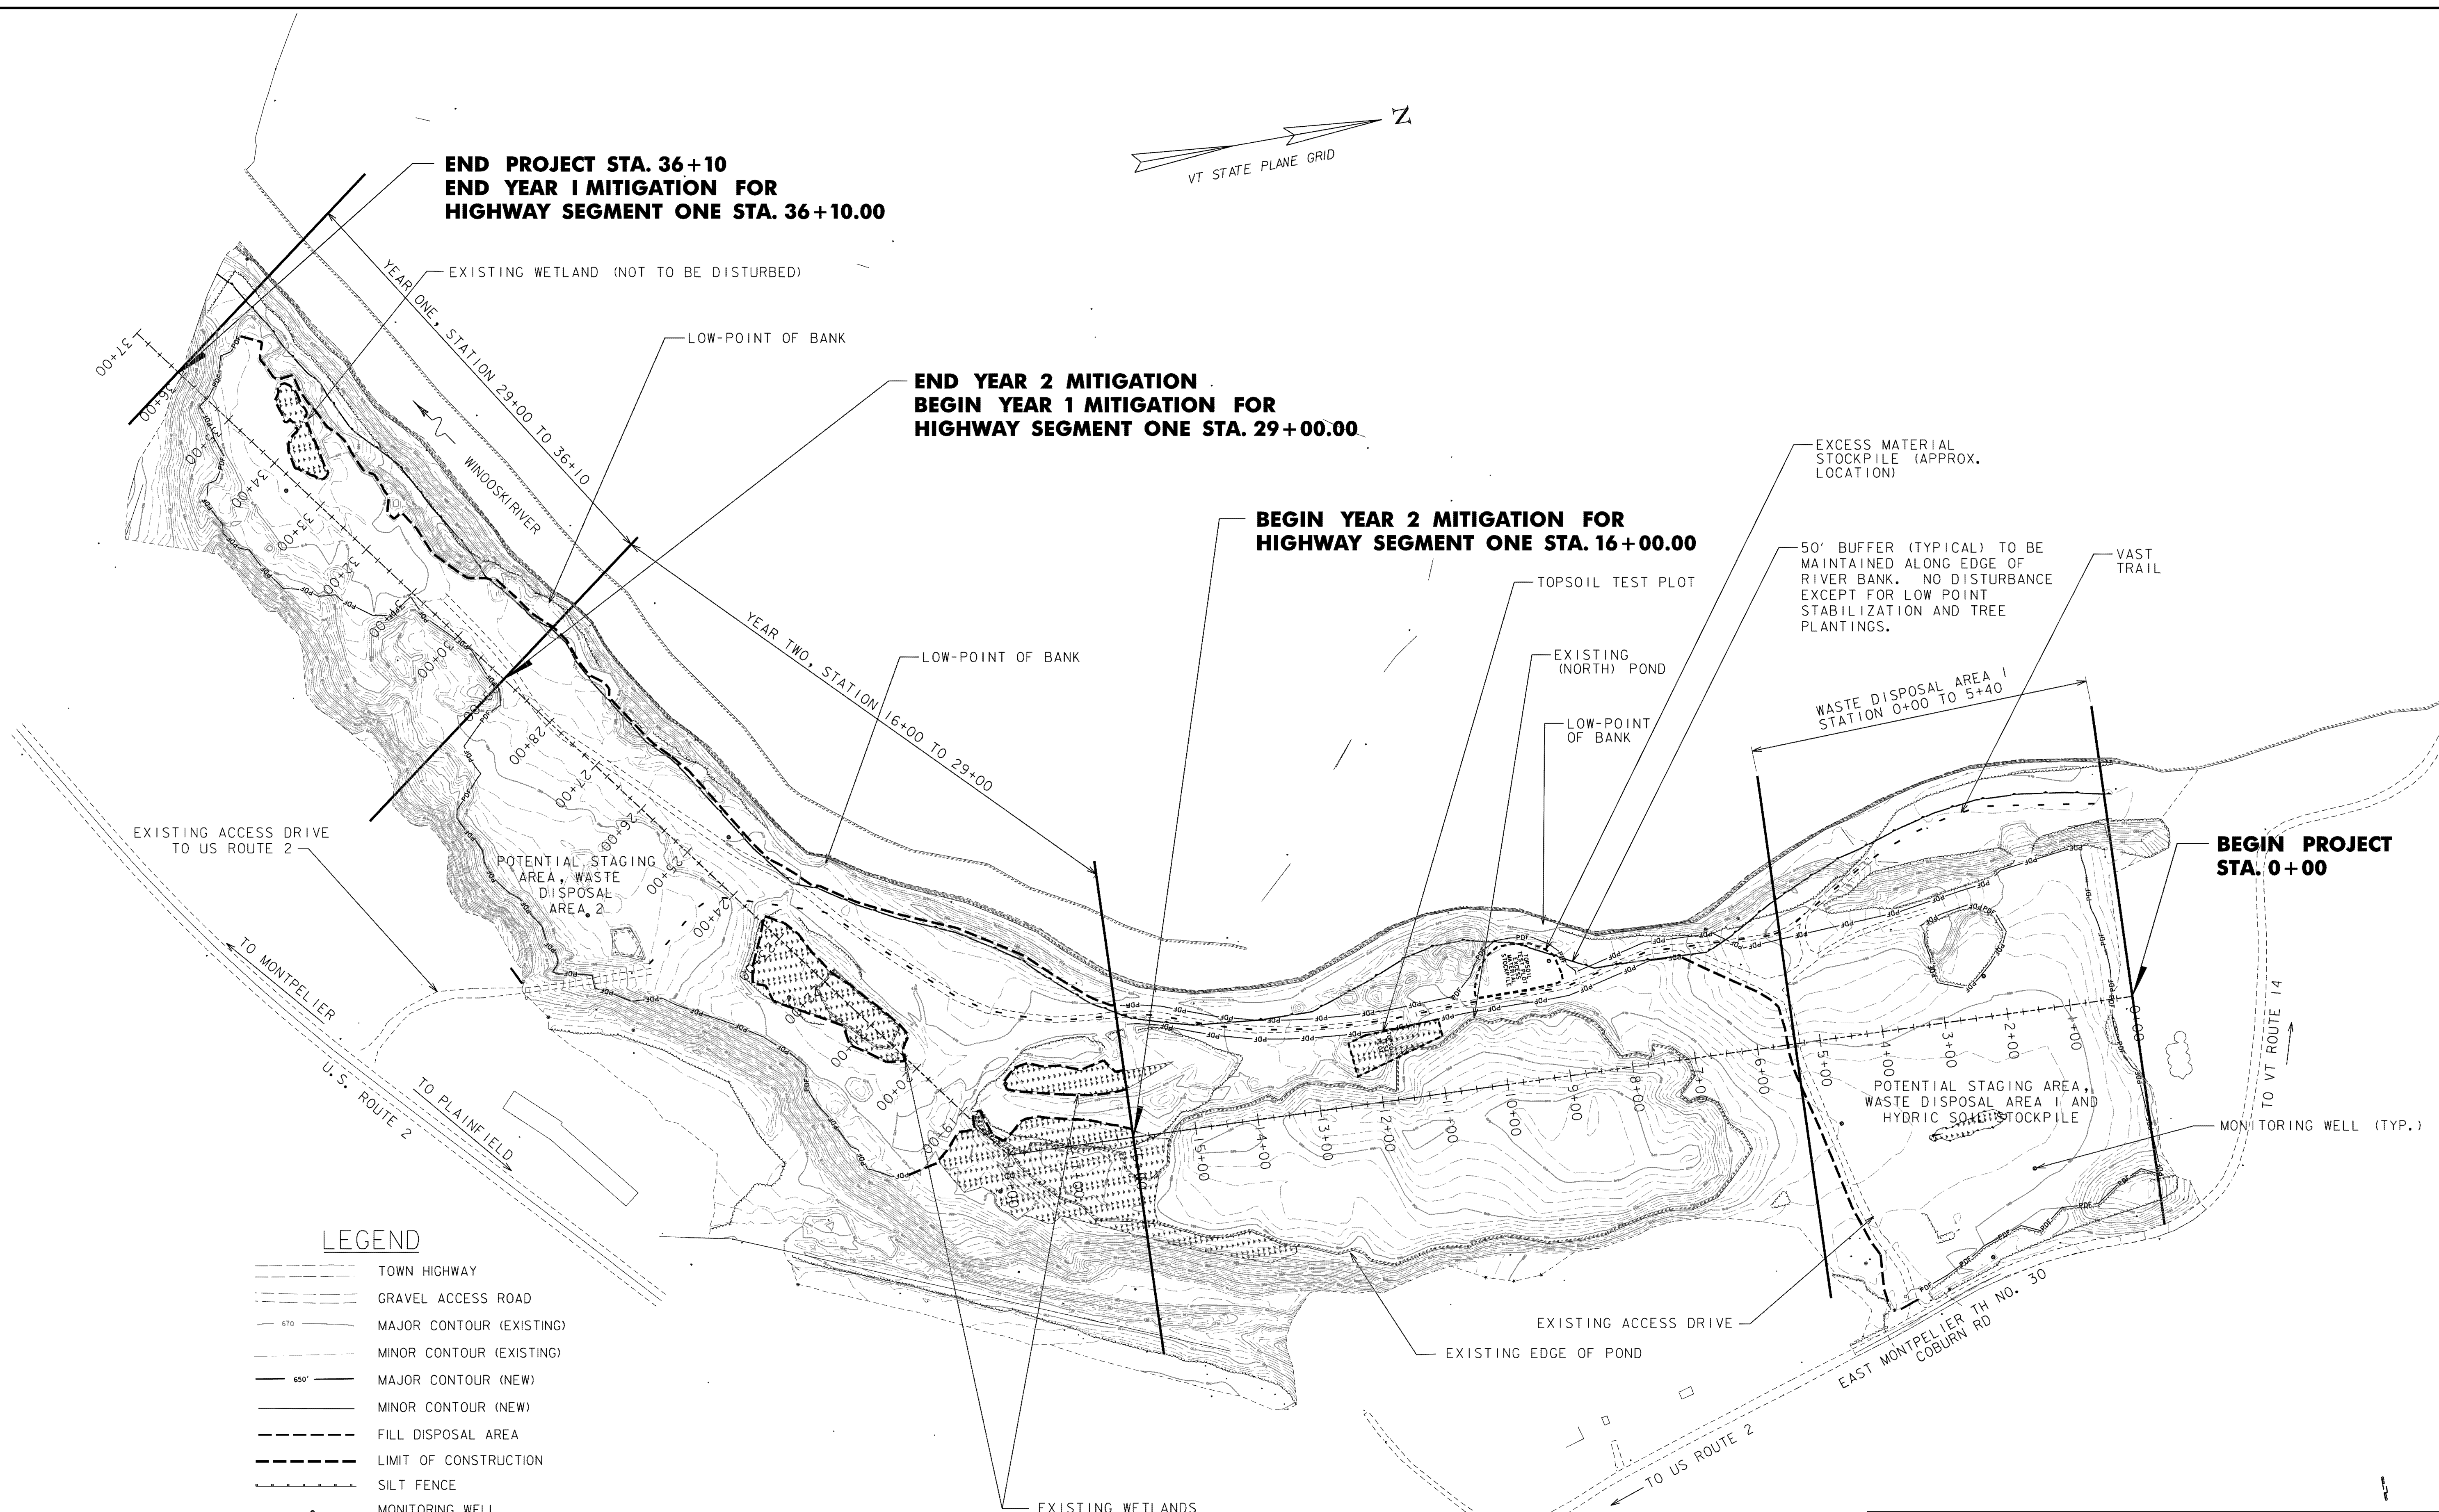

LEGEND

- TOWN HIGHWAY
- GRAVEL ACCESS ROAD
- 670 MAJOR CONTOUR (EXISTING)
- MINOR CONTOUR (EXISTING)
- 650 MAJOR CONTOUR (NEW)
- MINOR CONTOUR (NEW)
- FILL DISPOSAL AREA
- LIMIT OF CONSTRUCTION
- SILT FENCE
- MONITORING WELL
- EXISTING STRUCTURE
- VAST TRAIL
- PDF PROJECT DEMARCATION FENCE
- WETLAND

DATUM
VERTICAL NAVD 88
HORIZONTAL NAD 83 (92)

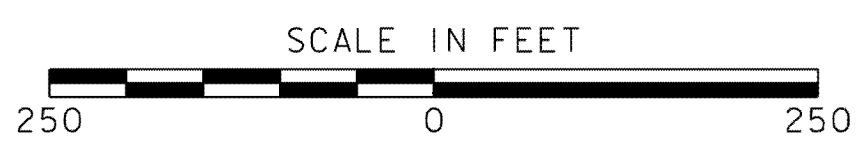

PROJECT NAME: CABOT-DANVILLE
PROJECT NUMBER: FECC F 028-3(26)
FILE NAME: xd0790Site.dgn
PROJECT LEADER: C.W. BRODIE
DESIGNED BY: C.W. BRODIE
OVERALL SITE PHASING PLAN
PLOT DATE: 10/25/2010
DRAWN BY: E.B. SMALL
CHECKED BY: J.K. BENSON
SHEET 202 OF 250