


DATUM
 VERTICAL NAVD 88
 HORIZONTAL NAD 83 (92)

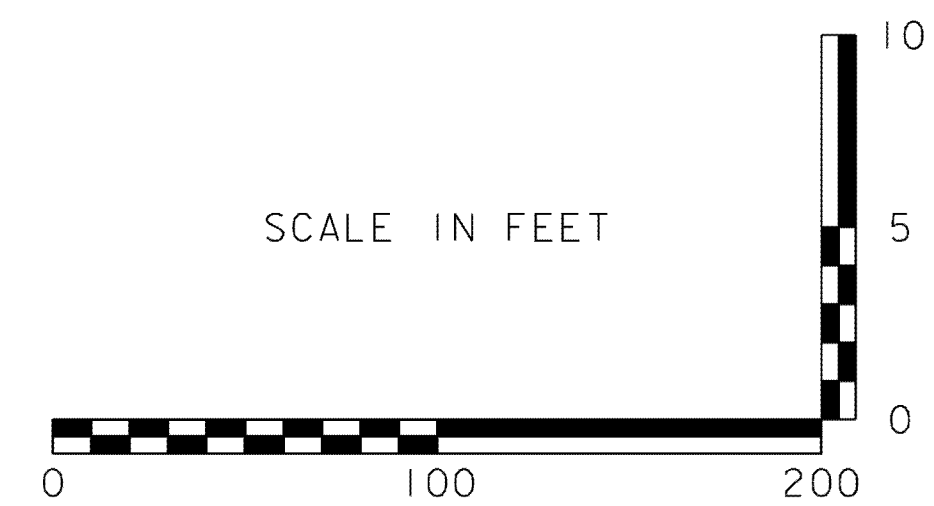

PROJECT NAME: CABOT-DANVILLE	PLOT DATE: 9/30/2010
PROJECT NUMBER: FECC F 028-3(26)	DRAWN BY: E.B. SMALL
FILE NAME: xd079xsl.dgn	CHECKED BY: J.K. BENSON
PROJECT LEADER: C.W. BRODIE	SHEET 209 OF 250
DESIGNED BY: C.W. BRODIE	
PROFILE (3)	