

N


VT STATE PLANE GRID

PLANT KEY

- AR = ACER RUBRUM (RED MAPLE)
- FR = FRAXINUS PENNSYLVANICA (GREEN ASH)
- CS = CORNUS SERICEA (RED OSIER DOGWOOD)
- IV = ILEX VERTICILLATA GRAY (COMMON WINTERBERRY)
- VR = VIBURNUM RECOGNITUM (NORTHERN ARROWWOOD)
- PD = POPLALUS DELTOIDES
- CC = CRATAEGUS CRUS-GALLI (ELEV. 662.5')
- LM = LOLIUM MULTIFLORUM (ANNUAL RYE)
- EC = NEW ENGLAND EROSION CONTROL/RESTORATION MIX

BEGIN YEAR 1 MITIGATION FOR HIGHWAY SEGMENT ONE STA. 16+00.00

NOTE: AREAS OF TOPSOIL ALTERNATE APPLICATION ADJACENT TO EXISTING POND BETWEEN APPROXIMATELY STATION 5+00 AND STATION 16+00 (SEE NOTES ON GRADING PLAN) TO BE SEEDED WITH RURAL CONSERVATION MIX (RC) AND MULCHED.

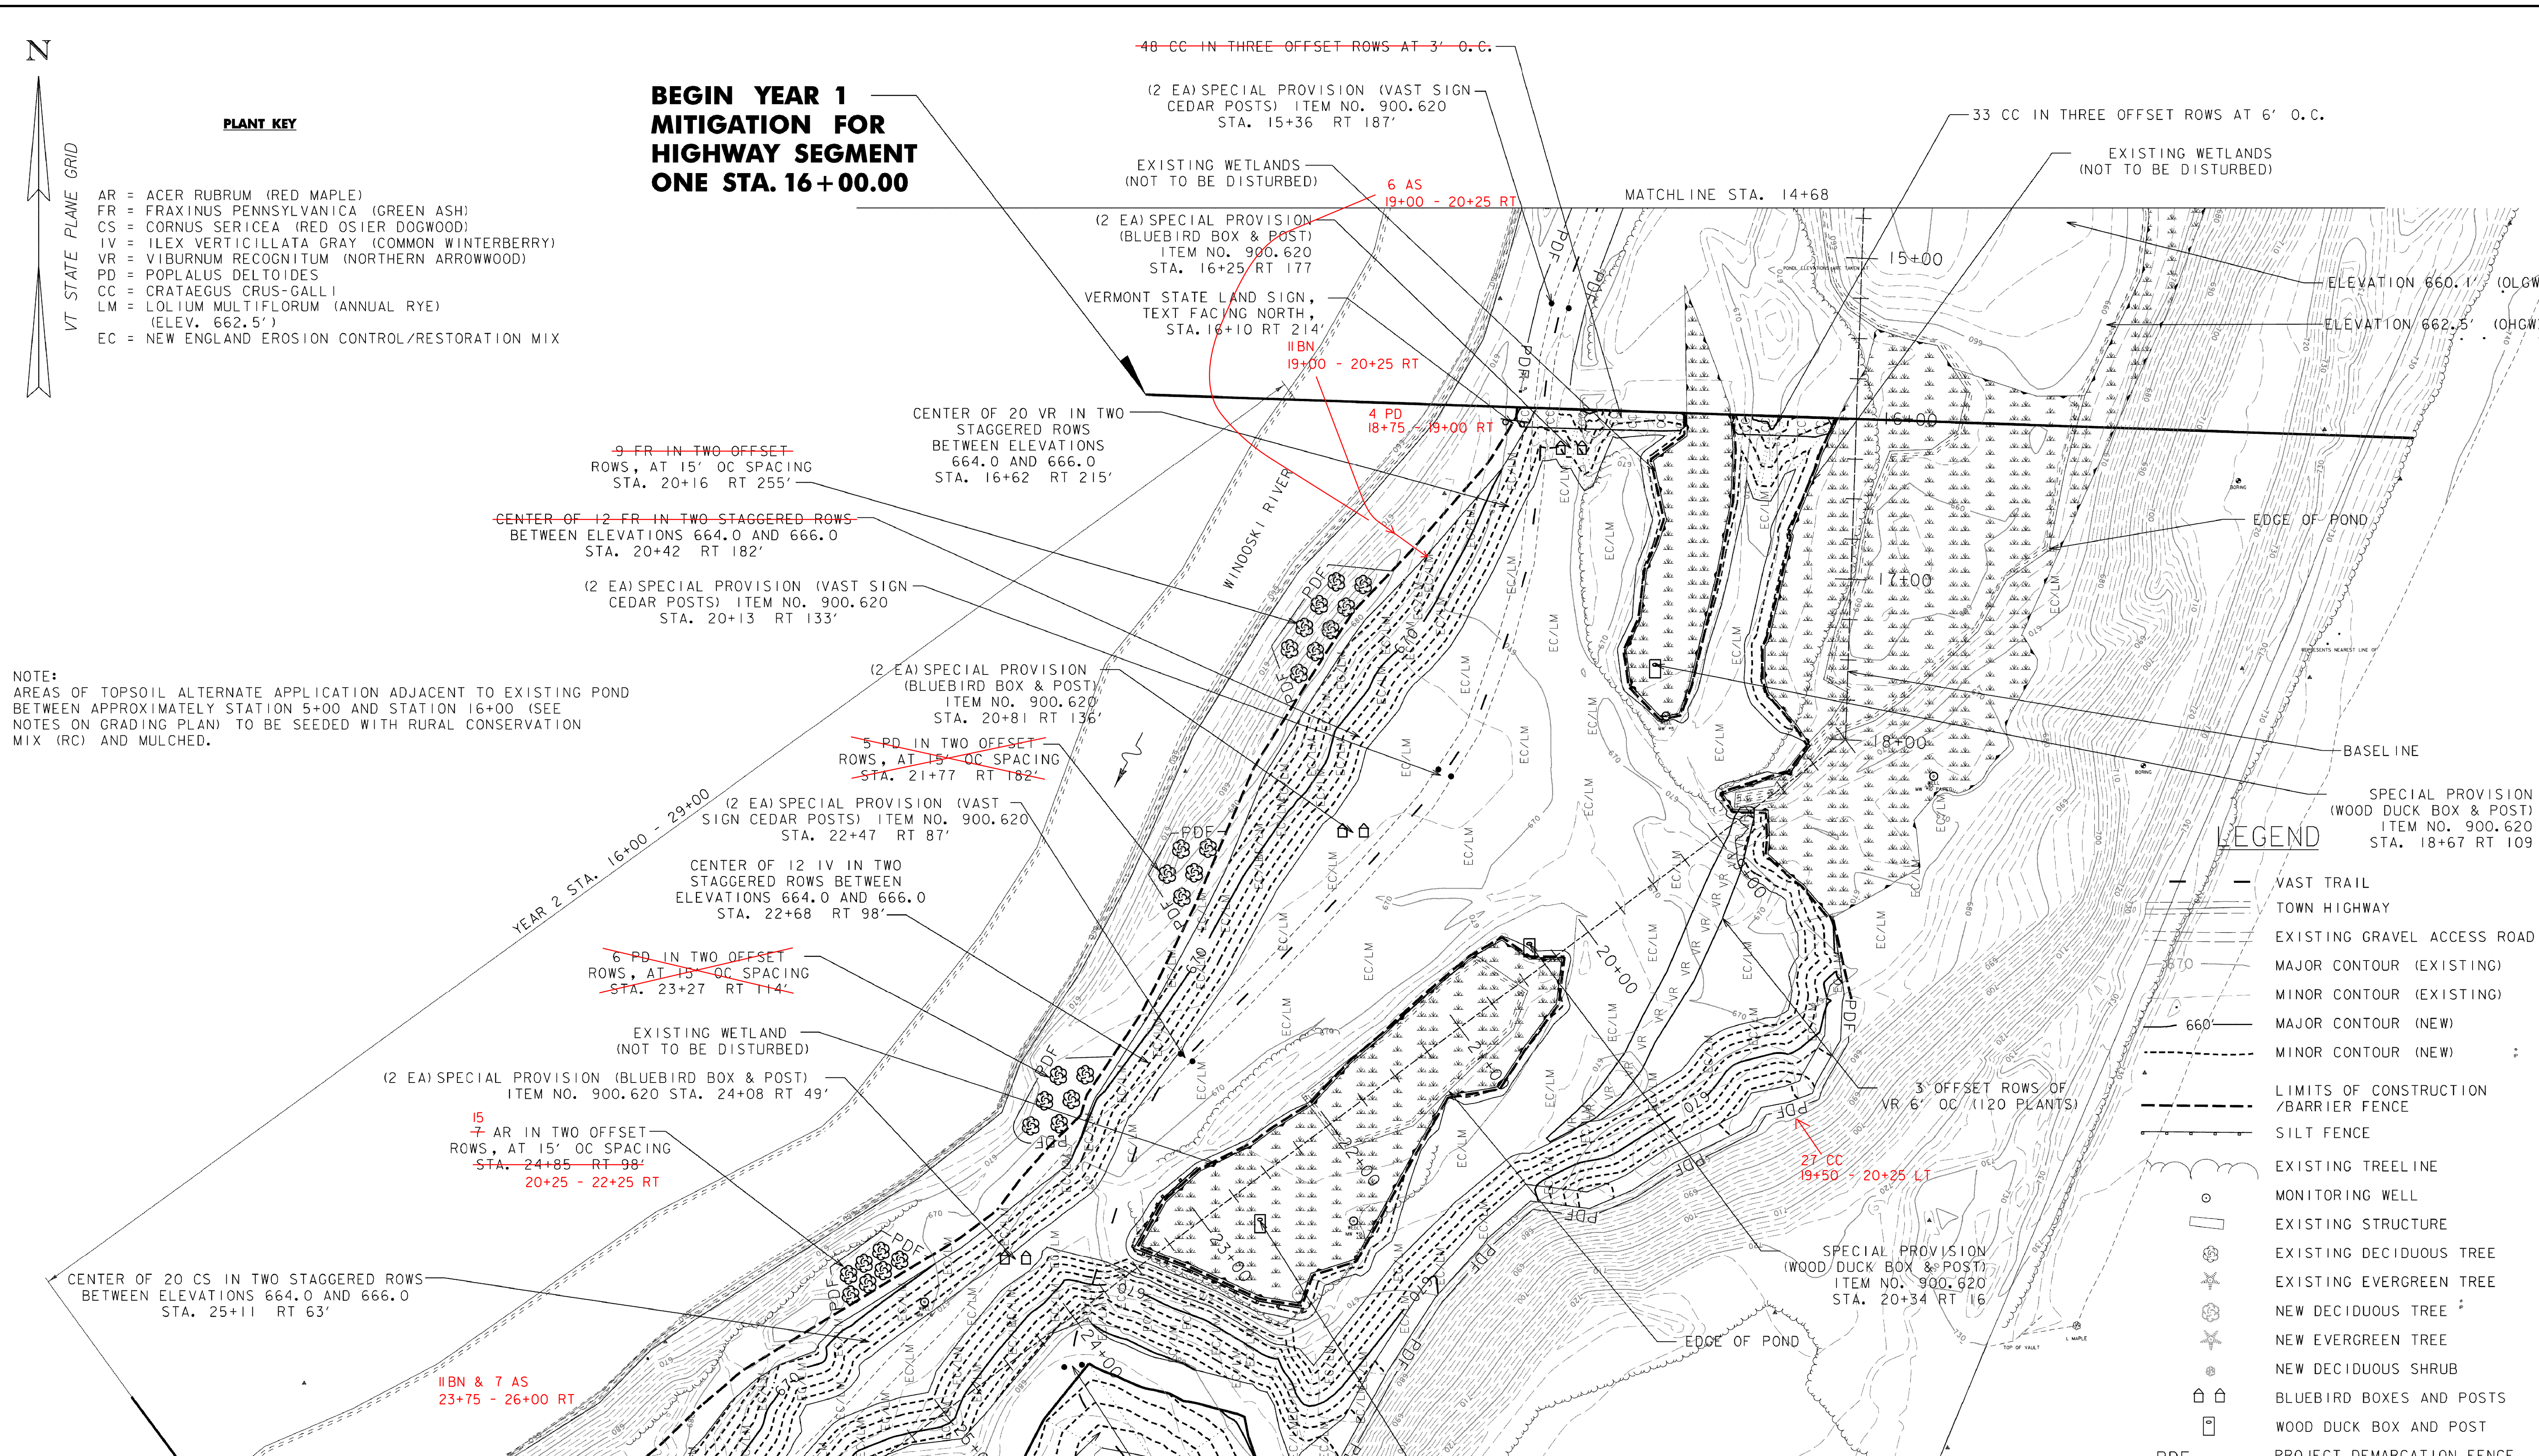


DATUM

VERTICAL NAVD 88

HORIZONTAL NAD 83 (92)

TOPSOIL ALTERNATE AREA ON ADDITIONAL WASTE DISPOSAL AREA, STATIONS 23+50 TO 28+25 LT, TO BE SEEDED WITH RURAL CONSERVATION MIX (RC) AND MULCHED UPON COMPLETION OF TOPSOIL OPTION PLACEMENT.

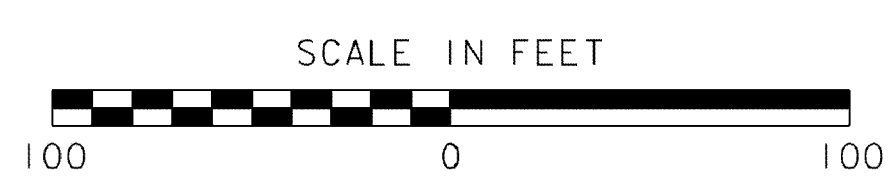

- LEGEND**
- VAST TRAIL
 - TOWN HIGHWAY
 - EXISTING GRAVEL ACCESS ROAD
 - MAJOR CONTOUR (EXISTING)
 - MINOR CONTOUR (EXISTING)
 - MAJOR CONTOUR (NEW)
 - MINOR CONTOUR (NEW)
 - LIMITS OF CONSTRUCTION /BARRIER FENCE
 - SILT FENCE
 - EXISTING TREELINE
 - MONITORING WELL
 - EXISTING STRUCTURE
 - EXISTING DECIDUOUS TREE
 - EXISTING EVERGREEN TREE
 - NEW DECIDUOUS TREE
 - NEW EVERGREEN TREE
 - NEW DECIDUOUS SHRUB
 - BLUEBIRD BOXES AND POSTS
 - WOOD DUCK BOX AND POST
 - PROJECT DEMARCATION FENCE
 - SS - SALIX SERICEA (SILKY WILLOW) FASCINE

PROJECT NAME: CABOT-DANVILLE

PROJECT NUMBER: FECC F 028-3(26)

FILE NAME: xd079land3.dgn

PROJECT LEADER: C.W.BRODIE

DESIGNED BY: C.W.BRODIE

LANDSCAPE PLAN (3)

PLOT DATE: 10/25/2010

DRAWN BY: E.B.SMALL

CHECKED BY: J.K.BENSON

SHEET 213 OF 250