


RE-ESTABLISH DITCHLINE ACROSS STABILIZED CONSTRUCTION ENTRANCE (TO BE PAID INCIDENTAL TO ITEM 653.35 VEHICLE TRACKING PAD)

SITE ACCESS STABILIZED CONSTRUCTION ENTRANCE

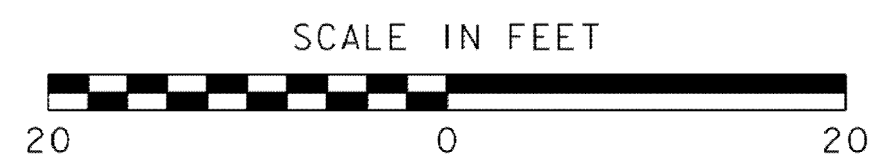

NOTES:

1. ~~6' CHAIN LINK FENCE WITH 24' LF DRIVE GATE TO BE INSTALLED CONCURRENTLY WITH CONSTRUCTION OF 24' WIDE STABILIZED CONSTRUCTION ENTRANCE IN YEAR ONE.~~
2. CONTRACTOR TO BE RESPONSIBLE FOR SITE SECURITY DURING CONSTRUCTION PERIODS.
3. CONTRACTOR TO MOVE CONCRETE MEDIAN BARRIERS FROM ROUTE 2 ACCESS AREA TO CONSTRUCTION ACCESS AREA, AND PLACE ACROSS 24' WIDE ACCESS AREA BETWEEN CONSTRUCTION SEASONS AND AT THE COMPLETION OF THE PROJECT. TO BE PAID UNDER ITEM # 621.95 REMOVE AND RESET TEMPORARY TRAFFIC BARRIER (LINEAR FEET)



EACH SIGN (VAOT ITEM 675.20) TO BE SUPPORTED BY TWO (2) SQUARE STEEL SIGN POSTS (VAOT ITEM 675.341), RATED AT TWO (2) LB/FT. BOTTOM OF SIGN TO BE SEVEN (7) FEET ABOVE FINISH GRADE.

SITE SIGN DETAIL  
NOT TO SCALE

DATUM  
VERTICAL NAVD 88  
HORIZONTAL NAD 83 (92)

PROJECT NAME: CABOT-DANVILLE  
PROJECT NUMBER: FECC F 028-3(26)

FILE NAME: xd079gate.dgn PLOT DATE: 10/25/2010  
PROJECT LEADER: C.W.BRODIE DRAWN BY: E.B. SMALL  
DESIGNED BY: C.W.BRODIE CHECKED BY: J.K. BENSON  
ENTRANCE DETAIL SHEET 225 OF 250