


DATUM  
 VERTICAL NAVD 88  
 HORIZONTAL NAD 83 (92)

LEGEND	
EXISTING GRADE	-----
NEW GRADE	_____
ORDINARY HIGH GROUND WATER	▽ OHGW =
ORDINARY LOW GROUND WATER	▽ OLGW =
WINOOSKI RIVER	

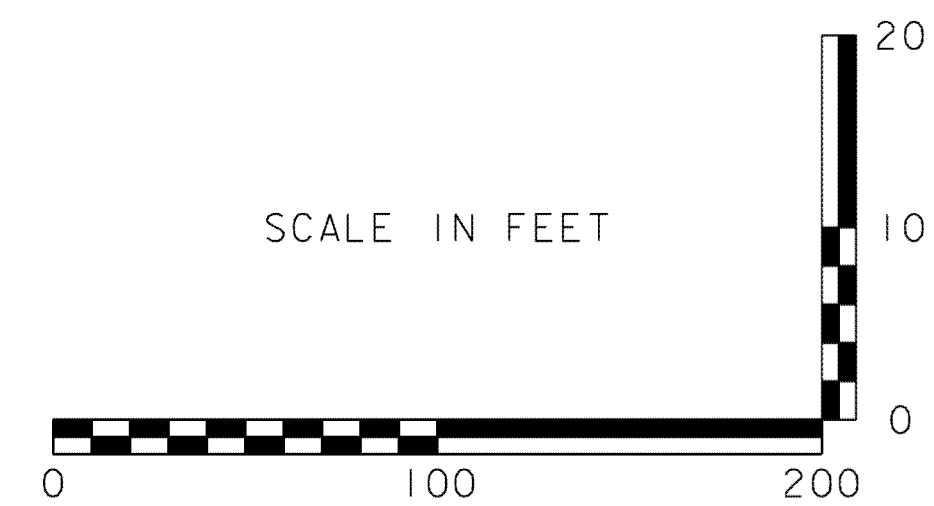

PROJECT NAME: CABOT-DANVILLE  
 PROJECT NUMBER: FECC F 028-3(26)  
 FILE NAME: xd079xsl.dgn  
 PROJECT LEADER: C.W. BRODIE  
 DESIGNED BY: C.W. BRODIE  
 CROSS SECTIONS (6)  
 PLOT DATE: 9/30/2010  
 DRAWN BY: E.B. SMALL  
 CHECKED BY: J.K. BENSON  
 SHEET 235 OF 250