


DATUM
VERTICAL NAVD 88
HORIZONTAL NAD 83 (92)

LEGEND	
EXISTING GRADE	-----
NEW GRADE	—————
ORDINARY HIGH GROUND WATER	▽ — OHGW =
ORDINARY LOW GROUND WATER	▽ — OLGW =
WINOOSKI RIVER	~~~~~

SCALE IN FEET

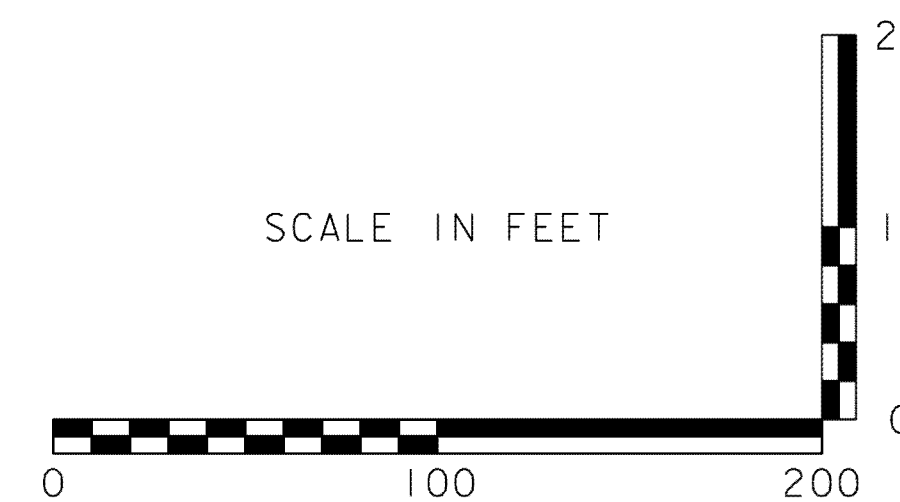

PROJECT NAME: CABOT-DANVILLE
PROJECT NUMBER: FECC F 028-3(26)

FILE NAME: xd079xsl.dgn
PROJECT LEADER: C.W. BRODIE
DESIGNED BY: C.W. BRODIE
CROSS SECTIONS (8)

PLOT DATE: 9/30/2010
DRAWN BY: E.B. SMALL
CHECKED BY: J.K. BENSON
SHEET 237 OF 250