


DATUM  
VERTICAL NAVD 88  
HORIZONTAL NAD 83 (92)

LEGEND	
EXISTING GRADE	-----
NEW GRADE	—————
ORDINARY HIGH GROUND WATER	▽ — OHGW =
ORDINARY LOW GROUND WATER	▽ — OLGW =
WINOOSKI RIVER	~~~~~

SCALE IN FEET

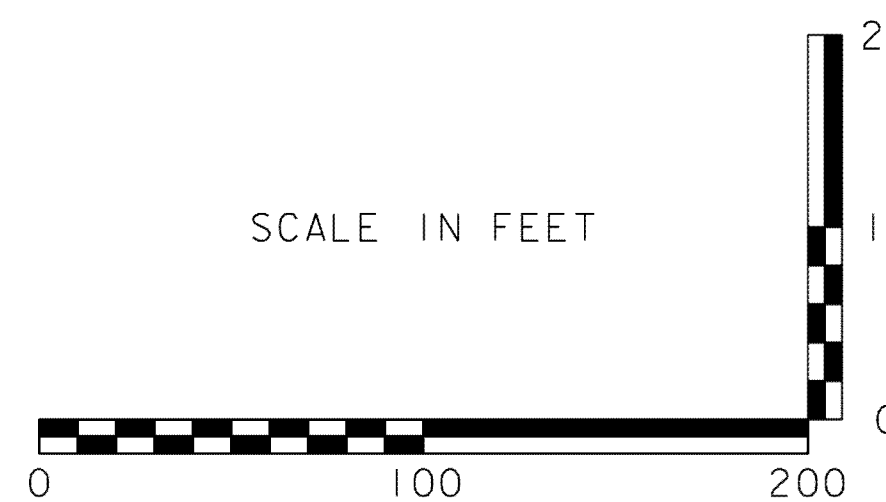

PROJECT NAME: CABOT-DANVILLE  
PROJECT NUMBER: FECC F 028-3(26)

FILE NAME: xd079xsl.dgn  
PROJECT LEADER: C.W. BRODIE  
DESIGNED BY: C.W. BRODIE  
CROSS SECTIONS (9)

PLOT DATE: 9/30/2010  
DRAWN BY: E.B. SMALL  
CHECKED BY: J.K. BENSON  
SHEET 238 OF 250