


DATUM
 VERTICAL NAVD 88
 HORIZONTAL NAD 83 (92)

LEGEND	
EXISTING GRADE	-----
NEW GRADE	—————
ORDINARY HIGH GROUND WATER	▽ — OHGW =
ORDINARY LOW GROUND WATER	▽ — OLGW =
WINOOSKI RIVER	~~~~~

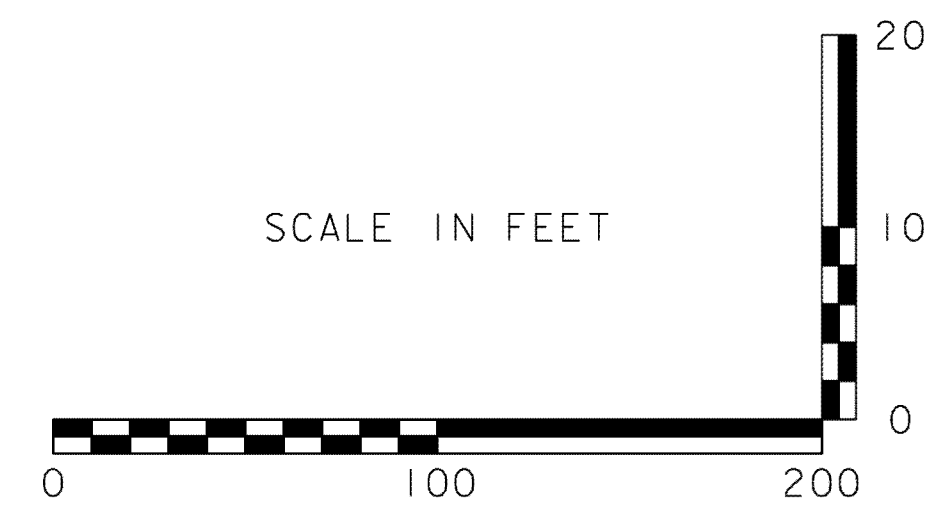

PROJECT NAME: CABOT-DANVILLE	PLOT DATE: 9/30/2010
PROJECT NUMBER: FECC F 028-3(26)	DRAWN BY: E.B. SMALL
FILE NAME: xd079xsl.dgn	CHECKED BY: J.K. BENSON
PROJECT LEADER: C.W. BRODIE	SHEET 244 OF 250
DESIGNED BY: C.W. BRODIE	CROSS SECTIONS (15)