


10 YR WATER SURFACE ELEV. = 672.80  
 5 YR WATER SURFACE ELEV. = 670.20  
 2.33 YR WATER SURFACE ELEV. = 667.00

DATUM  
 VERTICAL NAVD 88  
 HORIZONTAL NAD 83 (92)

LEGEND	
EXISTING GRADE	-----
NEW GRADE	—————
ORDINARY HIGH GROUND WATER	▽ — OHGW =
ORDINARY LOW GROUND WATER	▽ — OLGW =
WINOOSKI RIVER	~~~~~

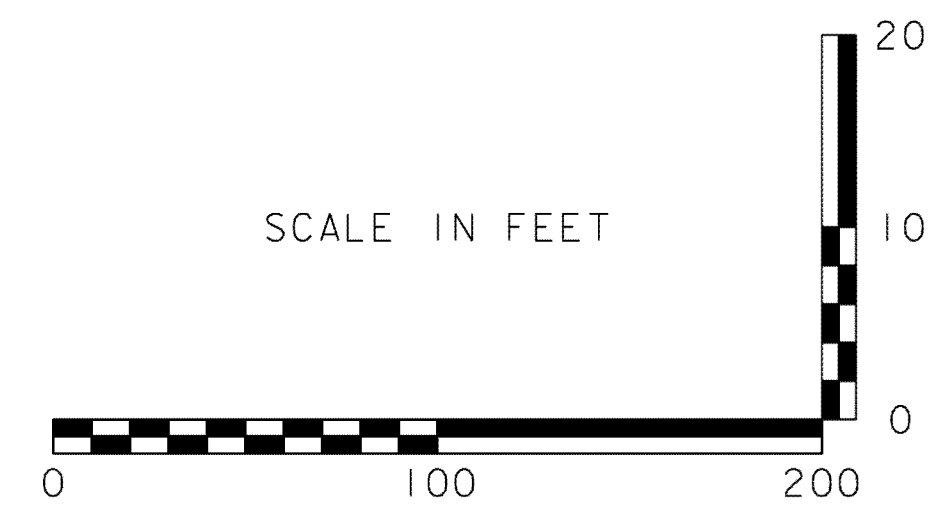

PROJECT NAME: CABOT-DANVILLE  
 PROJECT NUMBER: FECC F 028-3(26)  
 FILE NAME: xd079xsl.dgn  
 PROJECT LEADER: C.W. BRODIE  
 DESIGNED BY: C.W. BRODIE  
 CROSS SECTIONS (17)  
 PLOT DATE: 9/30/2010  
 DRAWN BY: E.B. SMALL  
 CHECKED BY: J.K. BENSON  
 SHEET 246 OF 250