

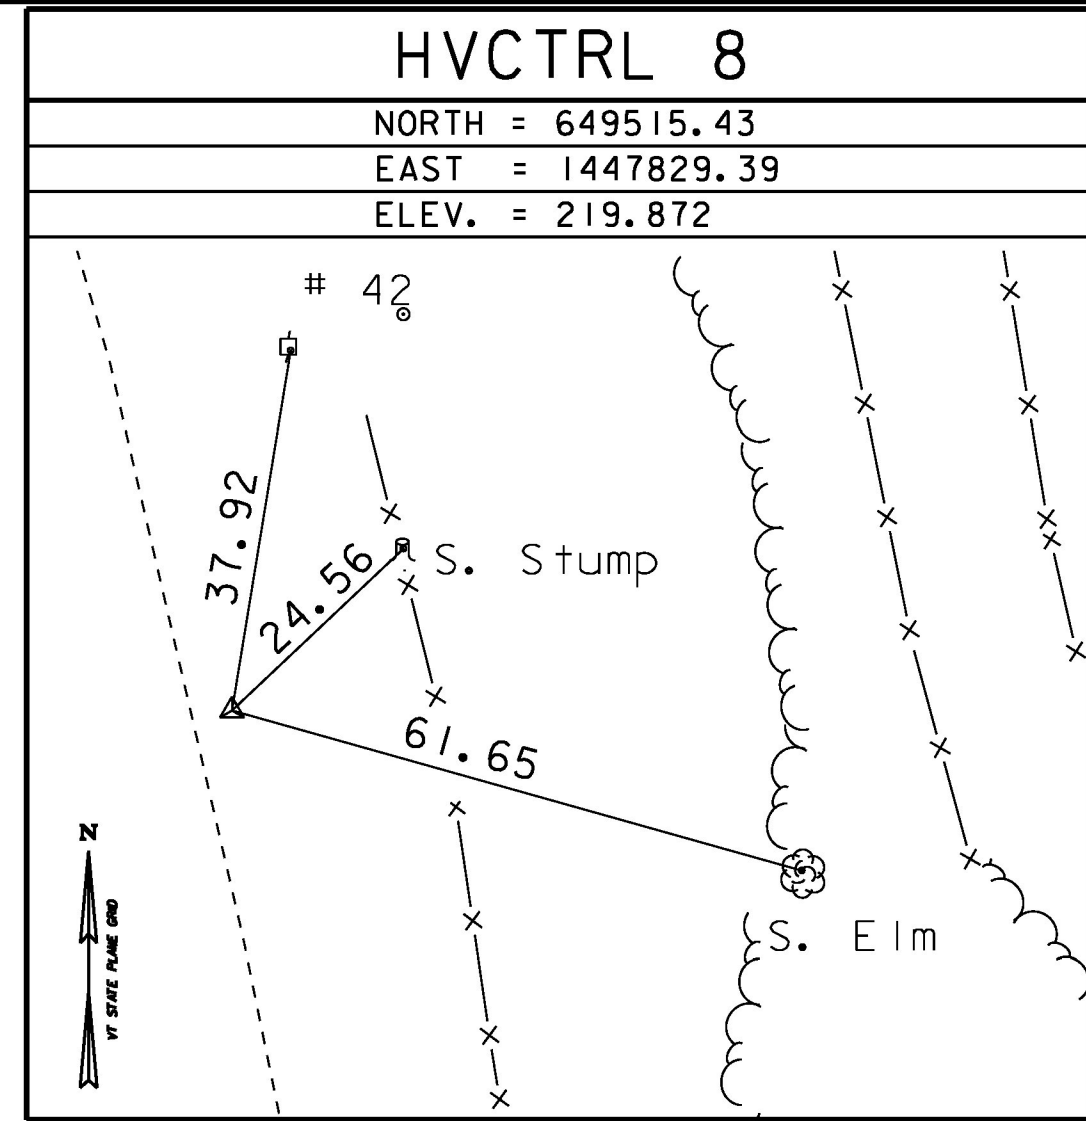
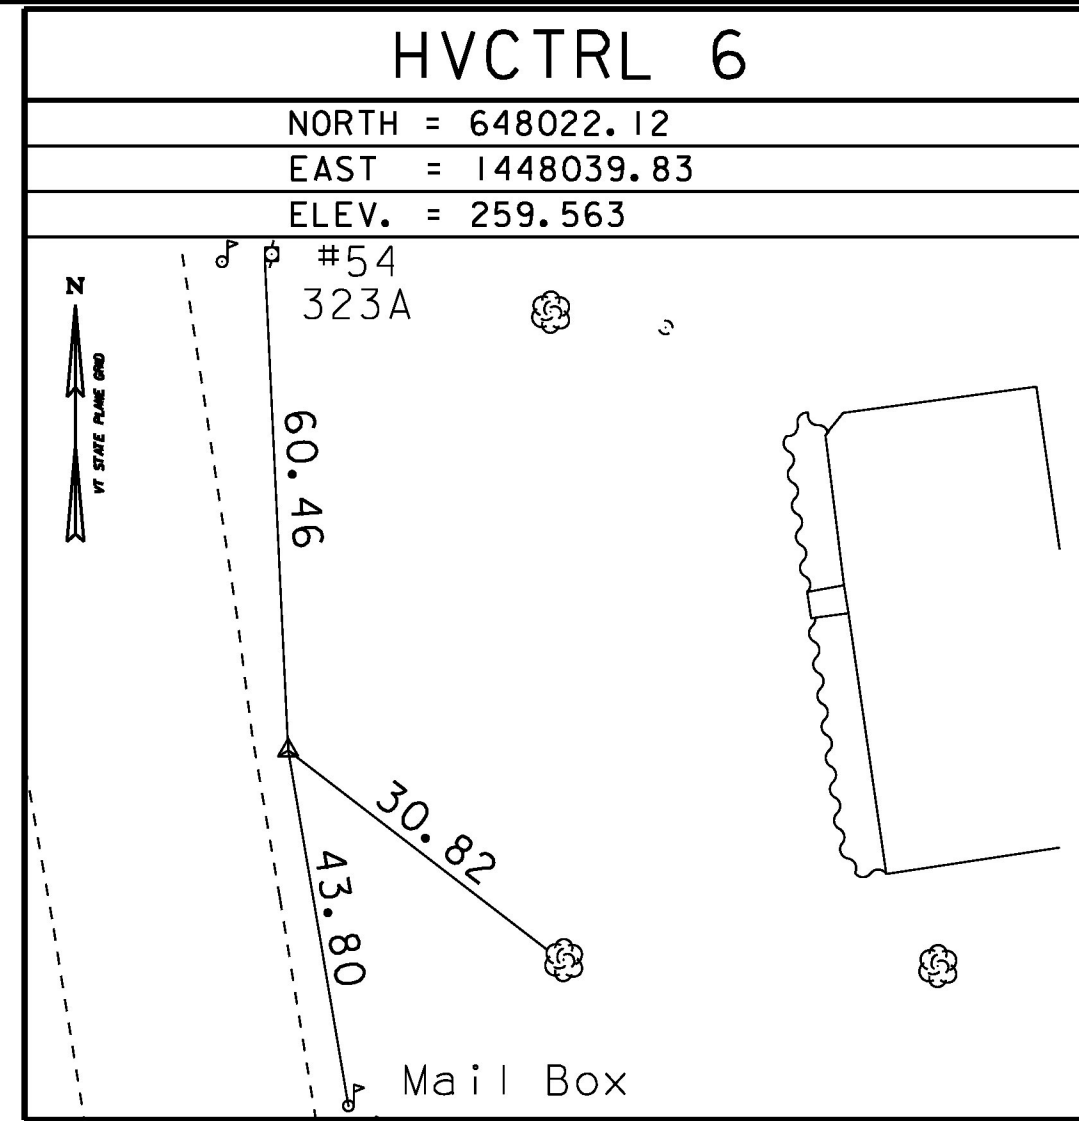
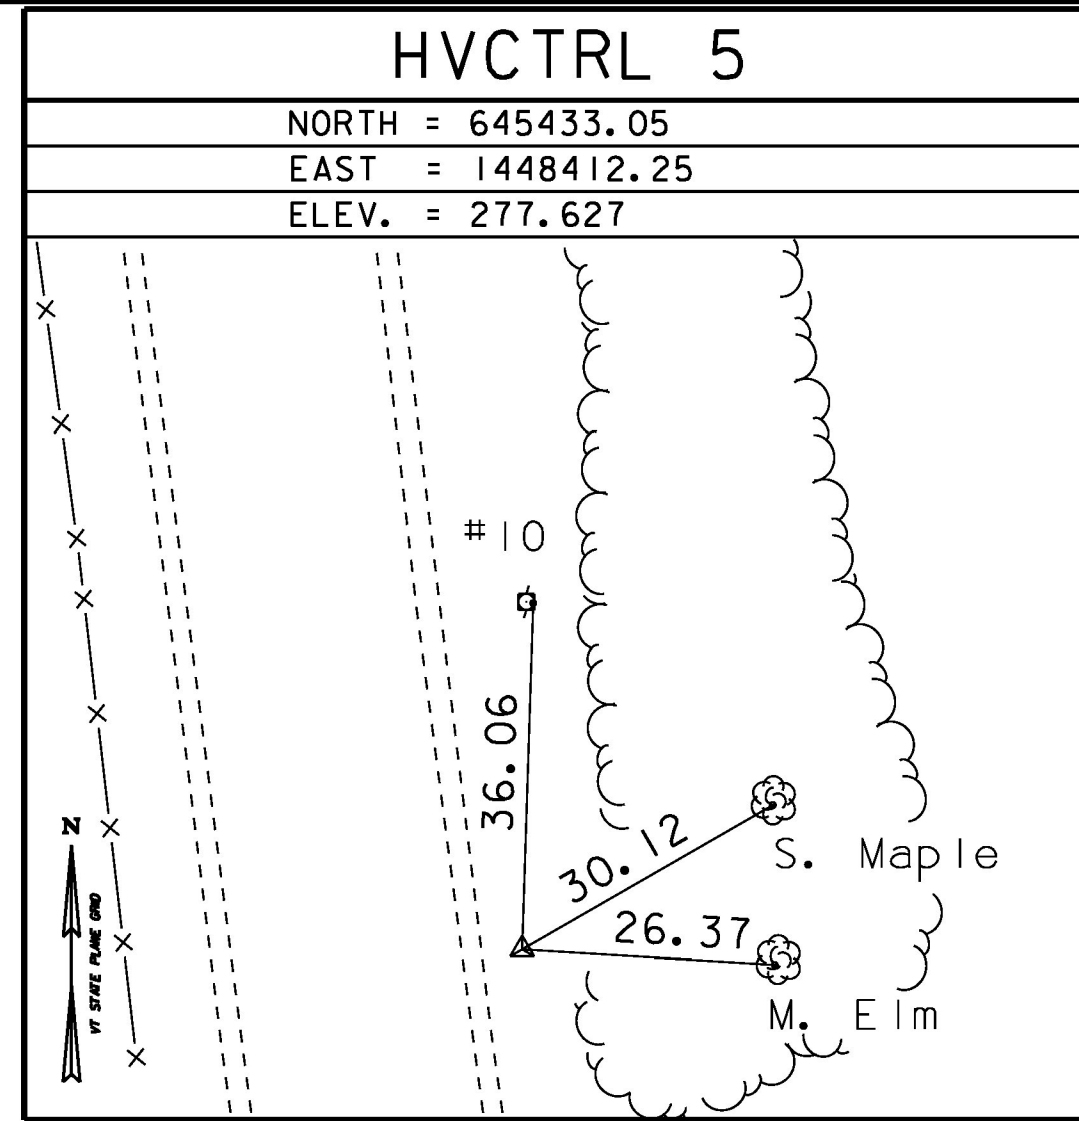
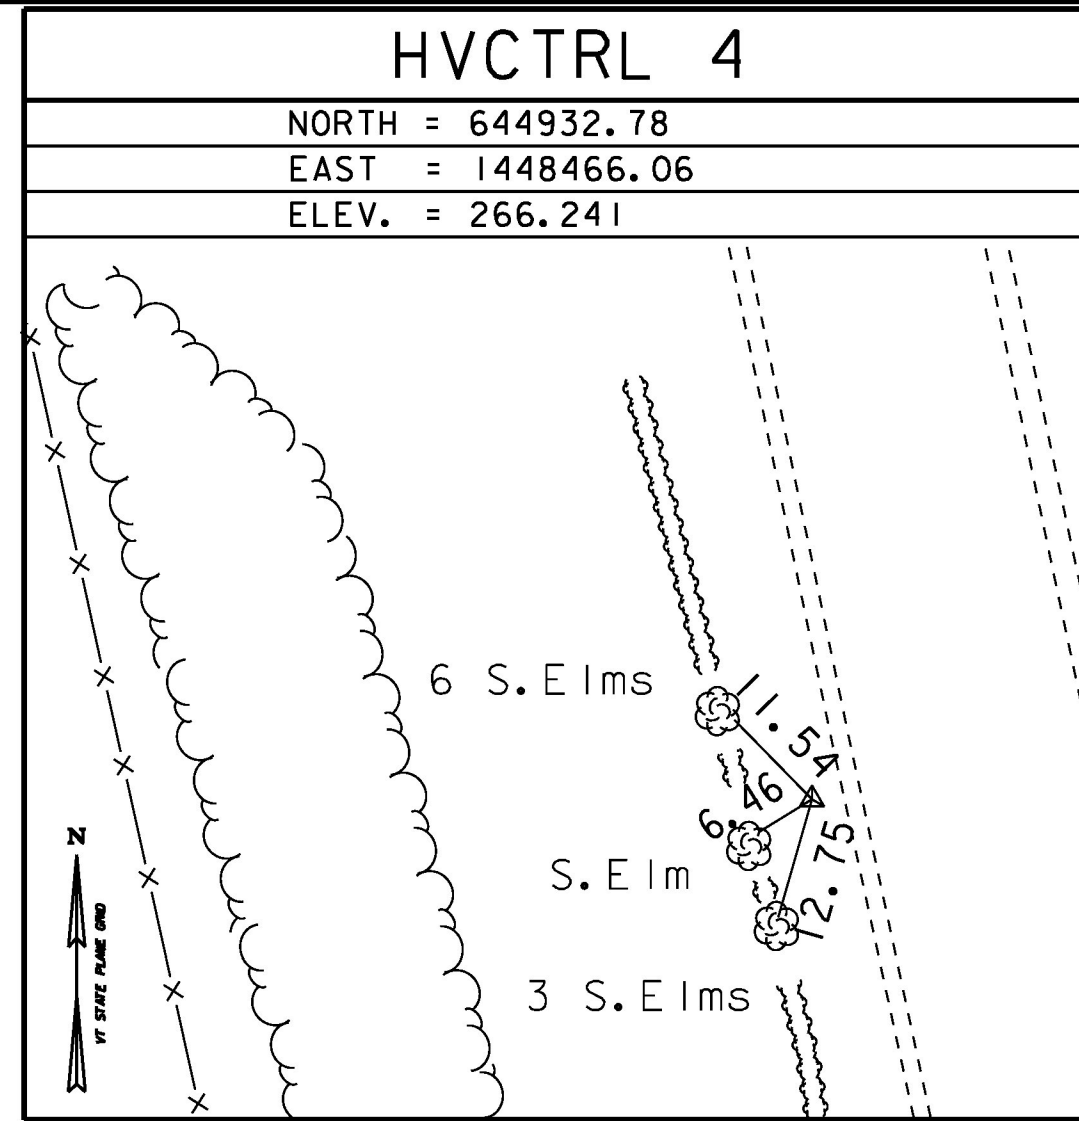
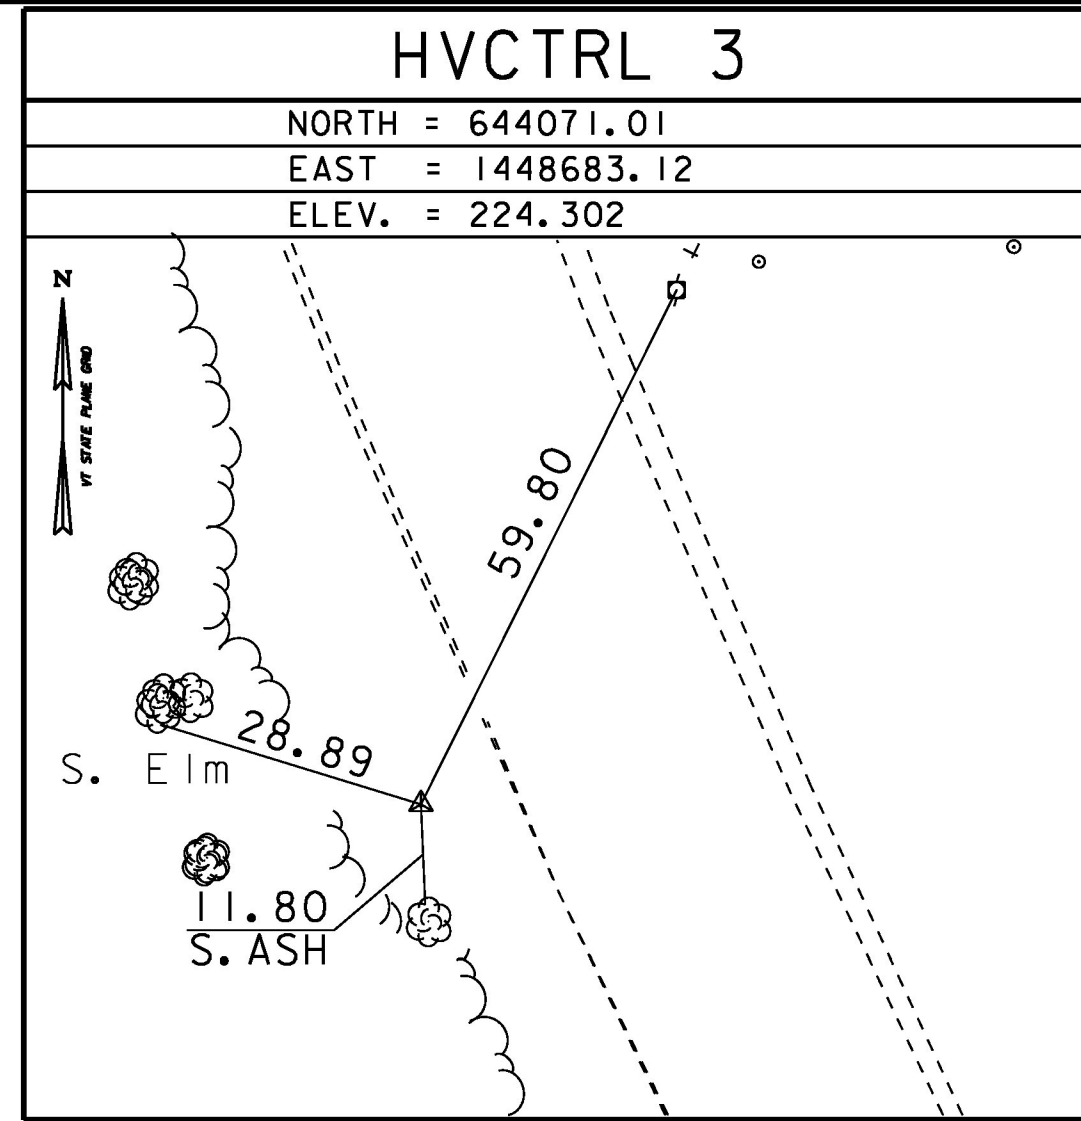
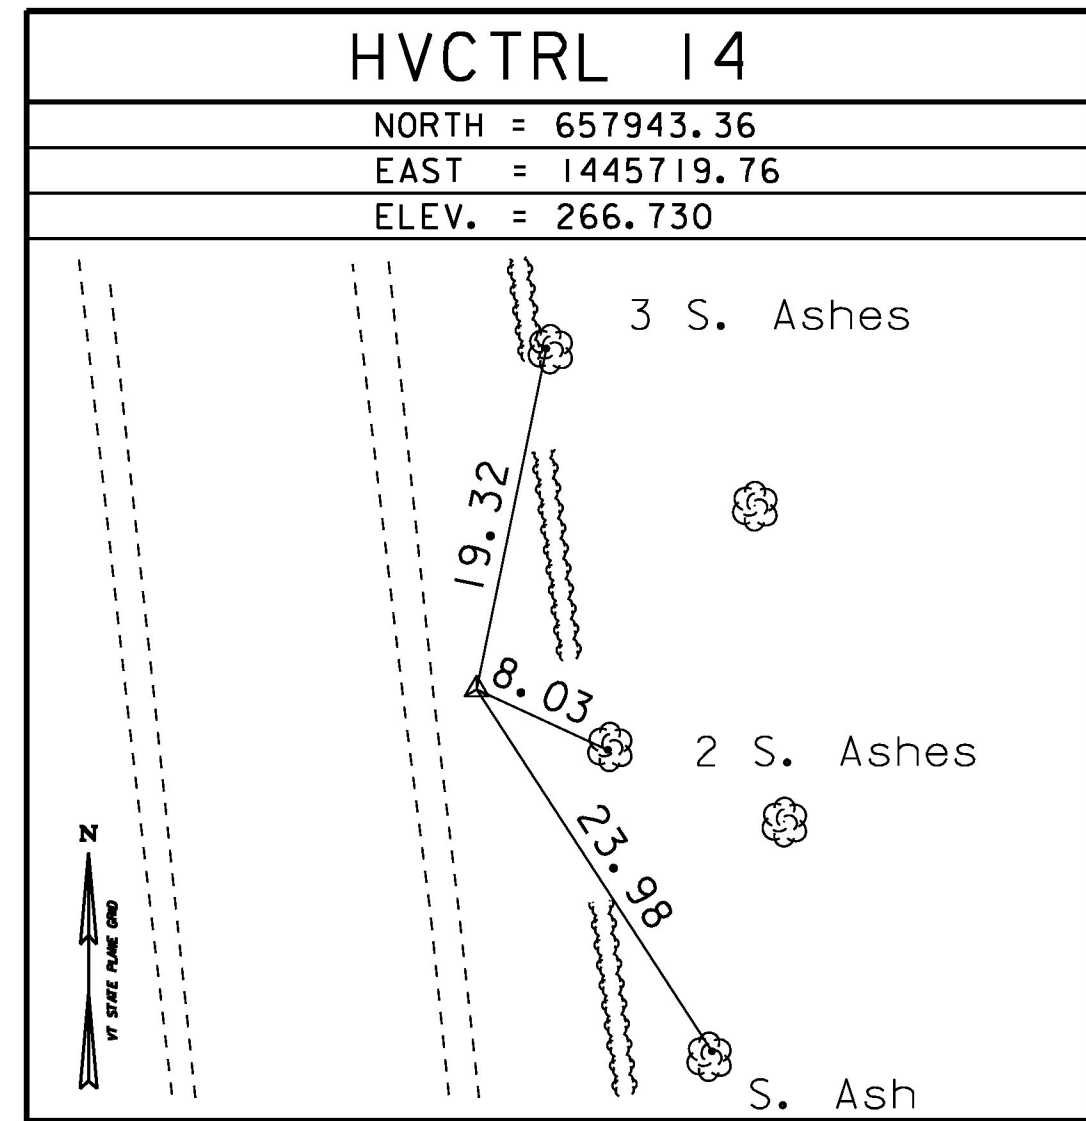
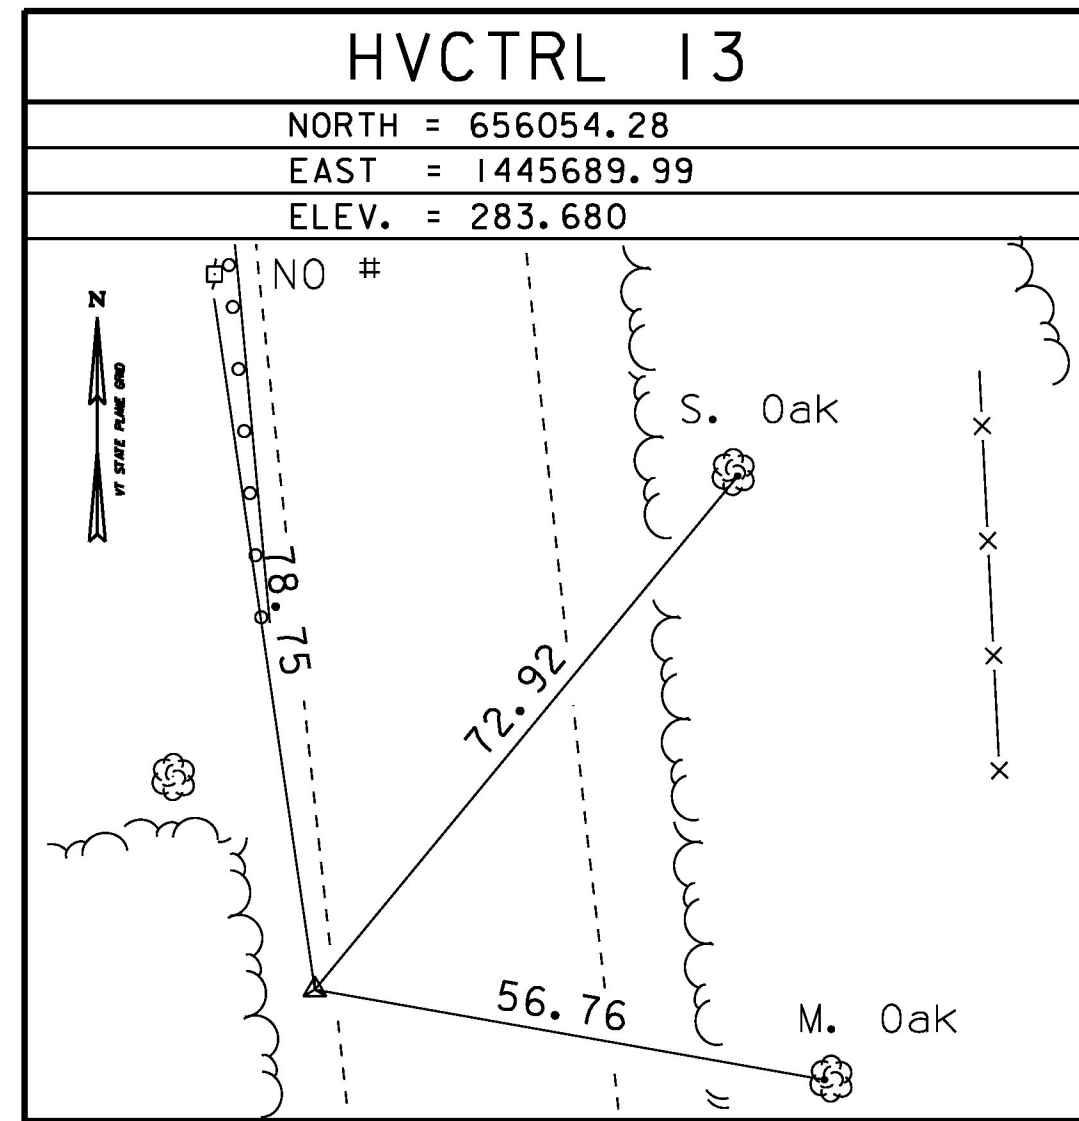
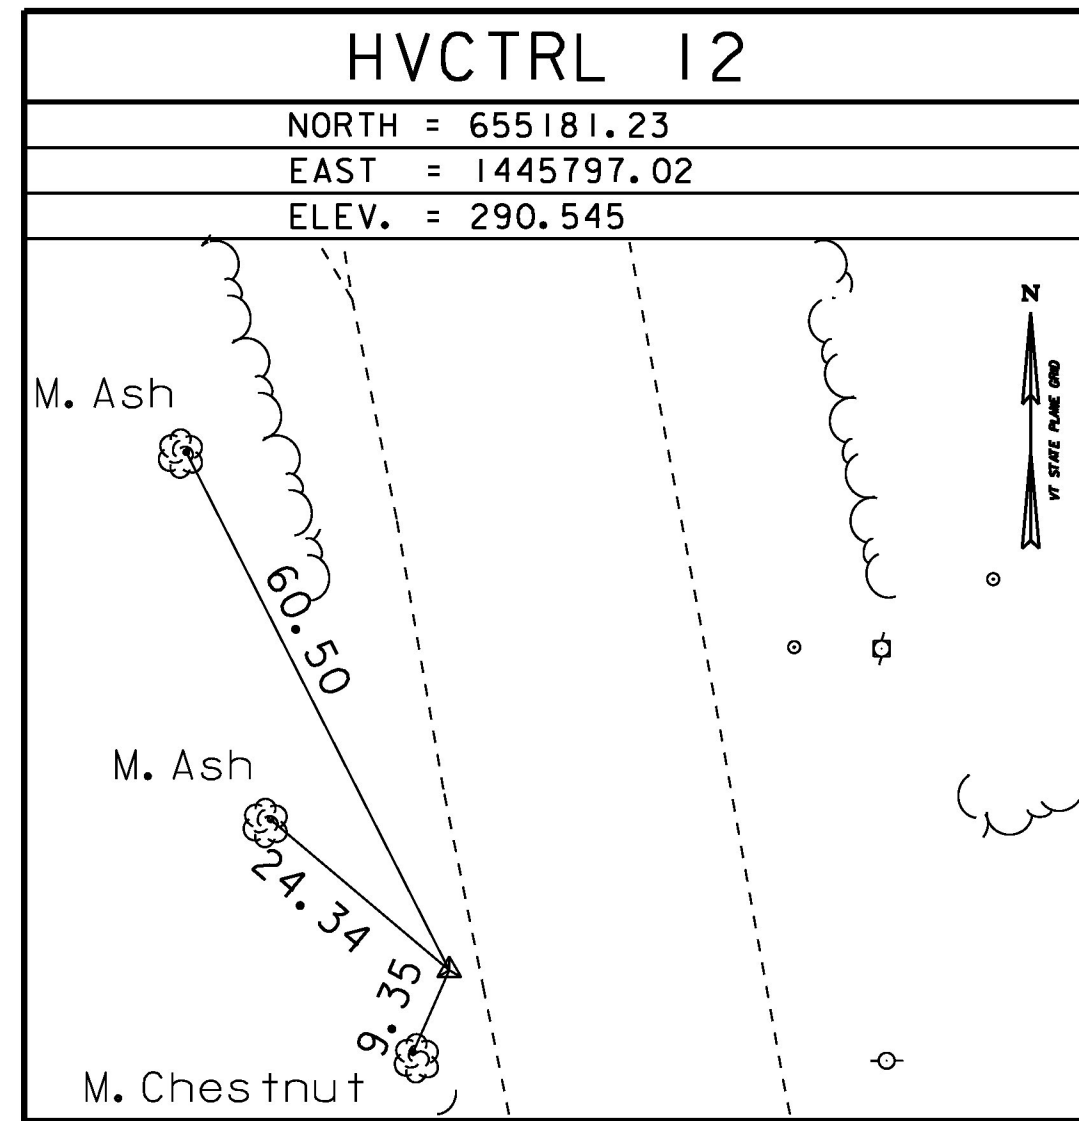


TRAVERSE TIES





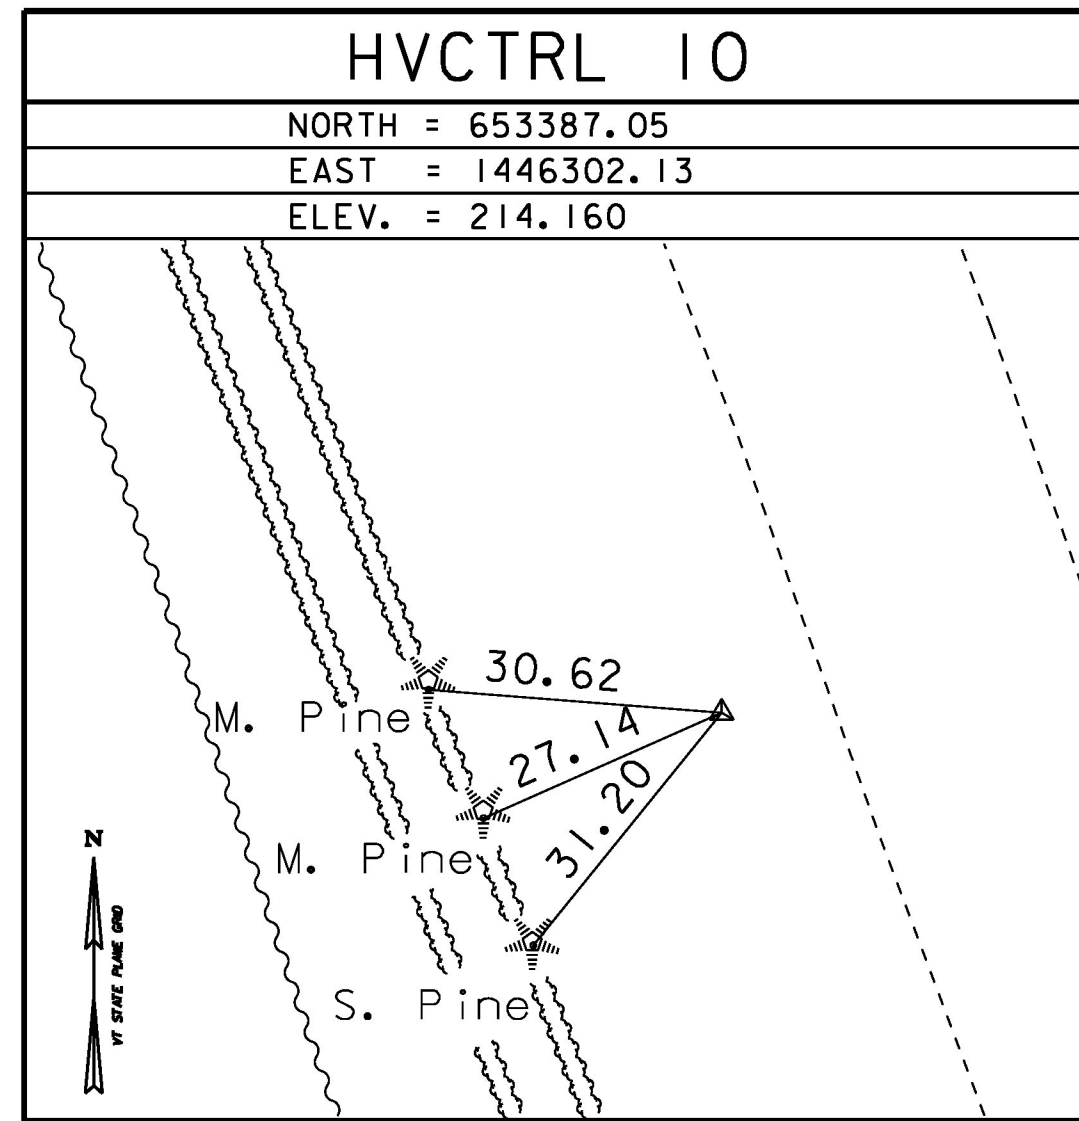


• MAIN TRAVERSE COMPLETED 01/22/03 by R. Gilman P.C. & P. Winters & D. breer

TRAVERSE TIES

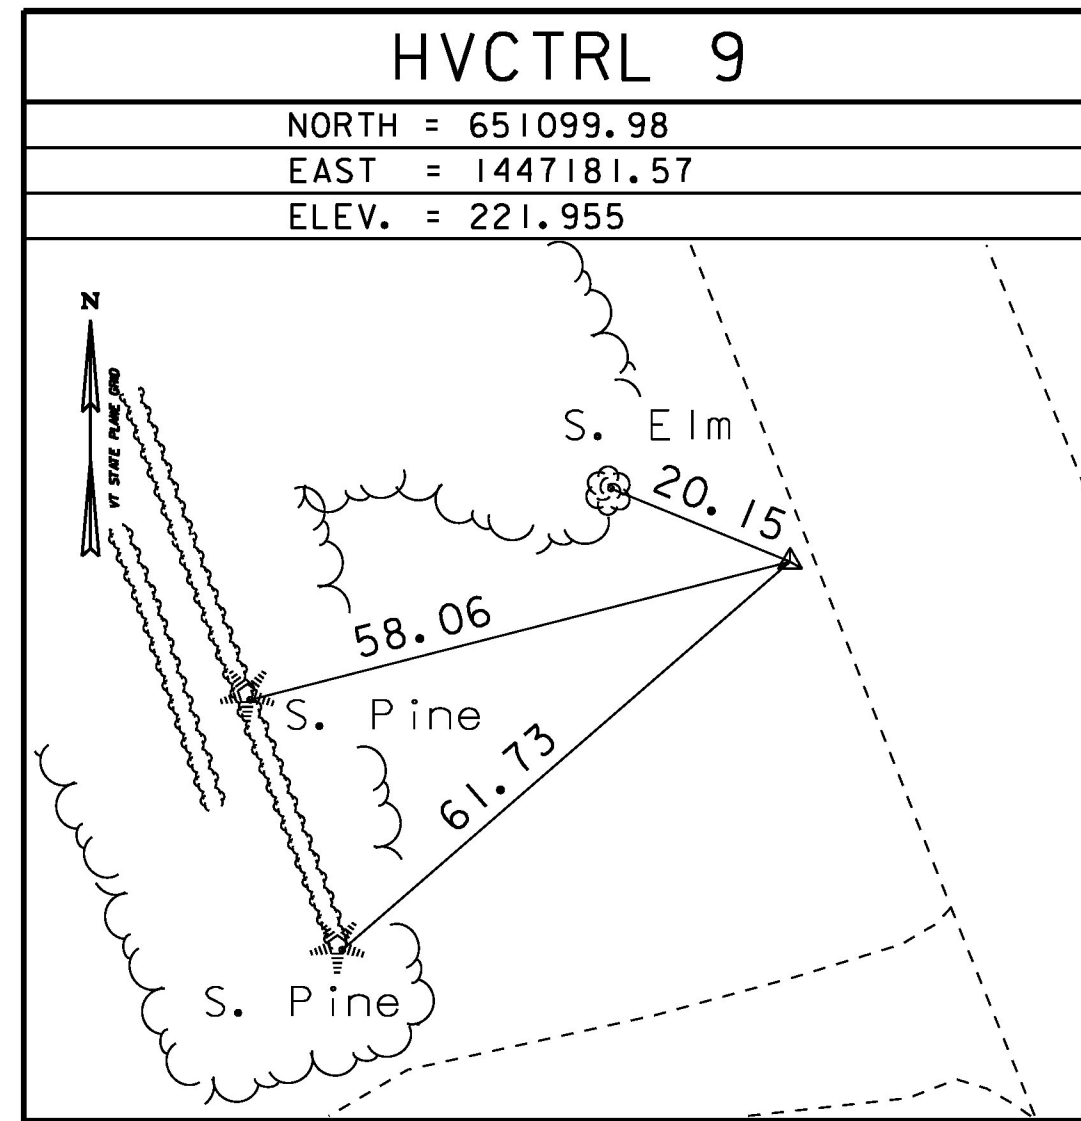

ALIGNMENT TIES

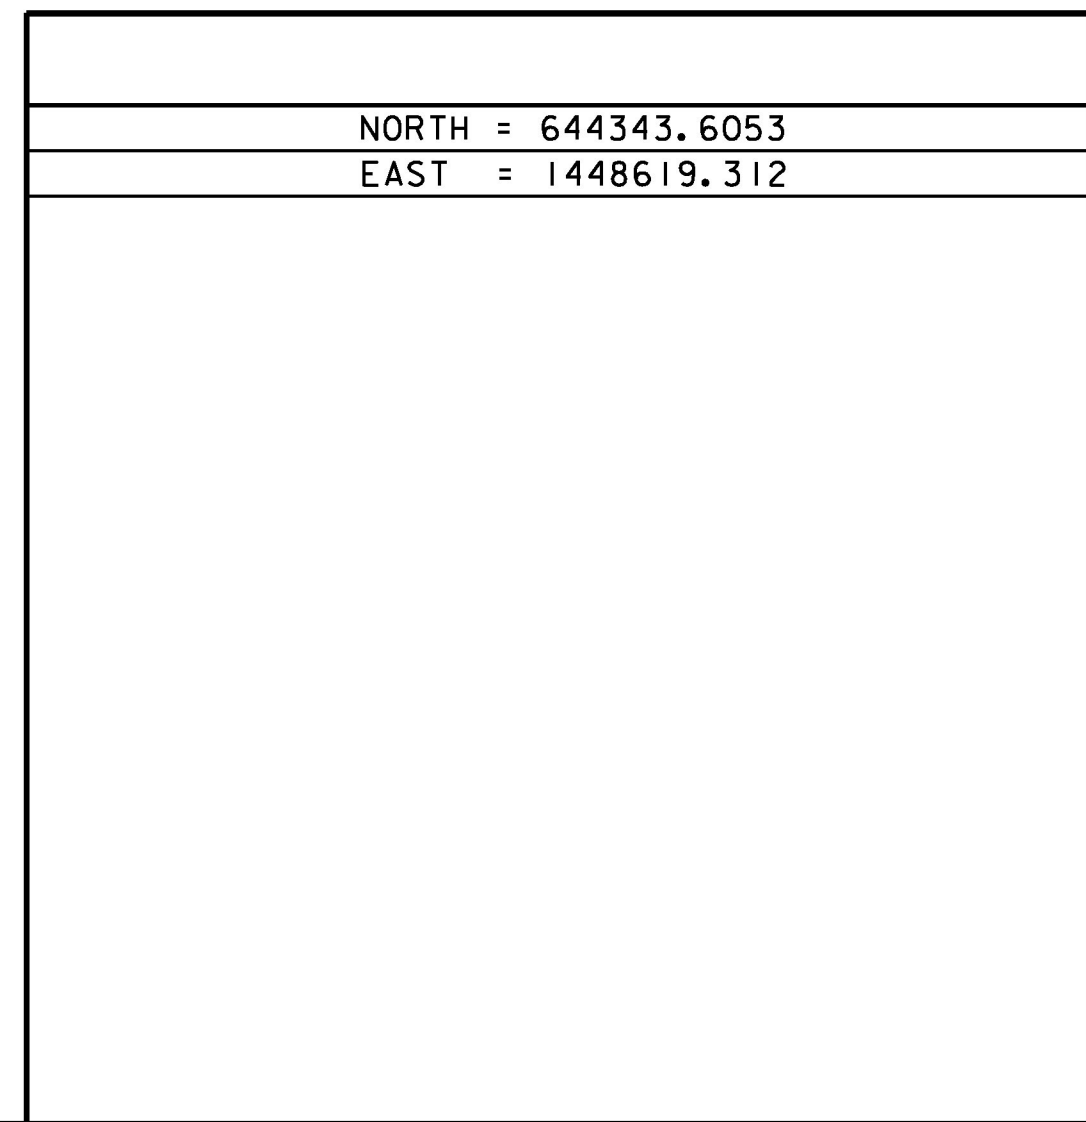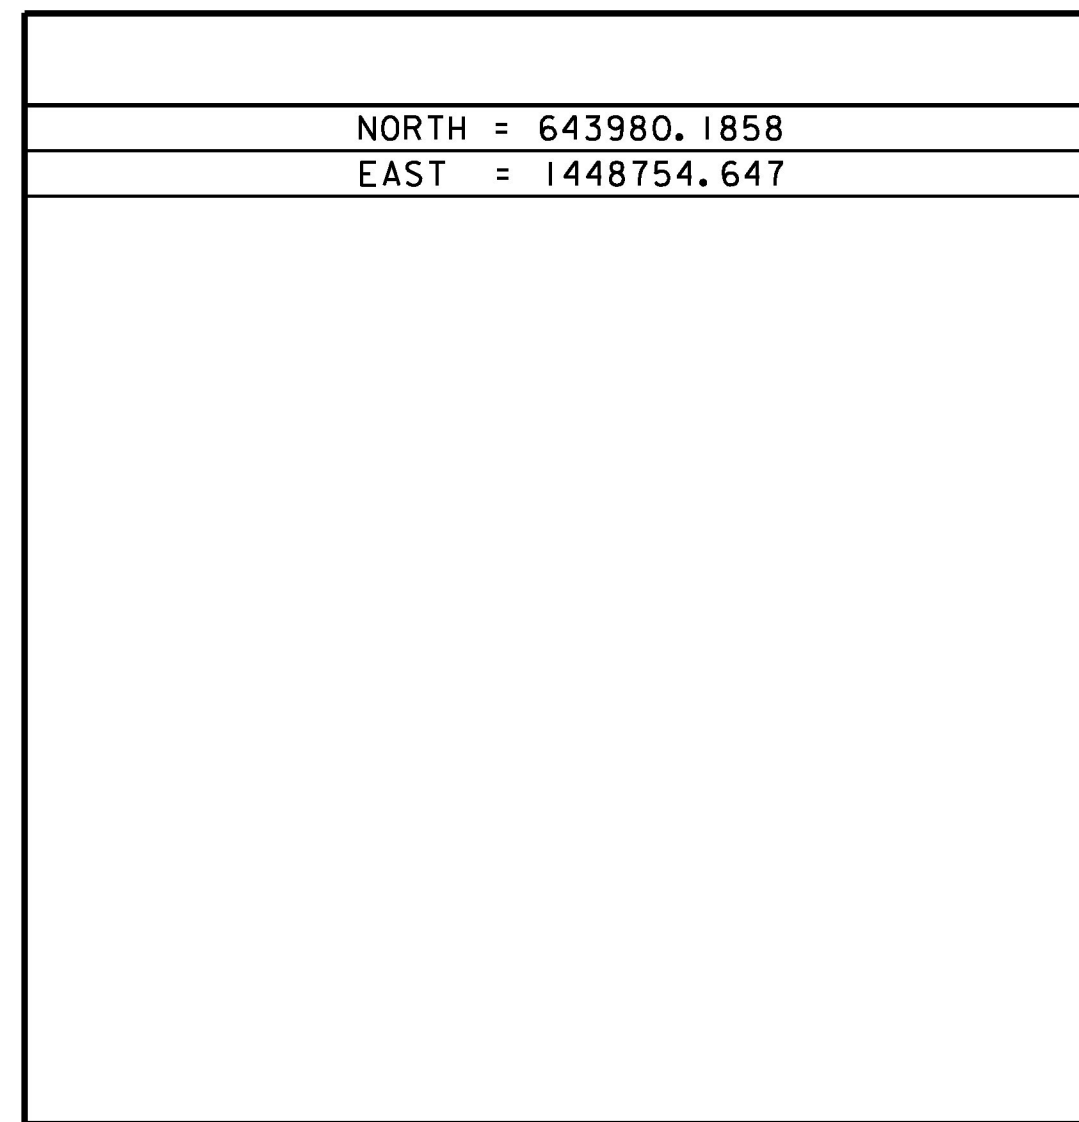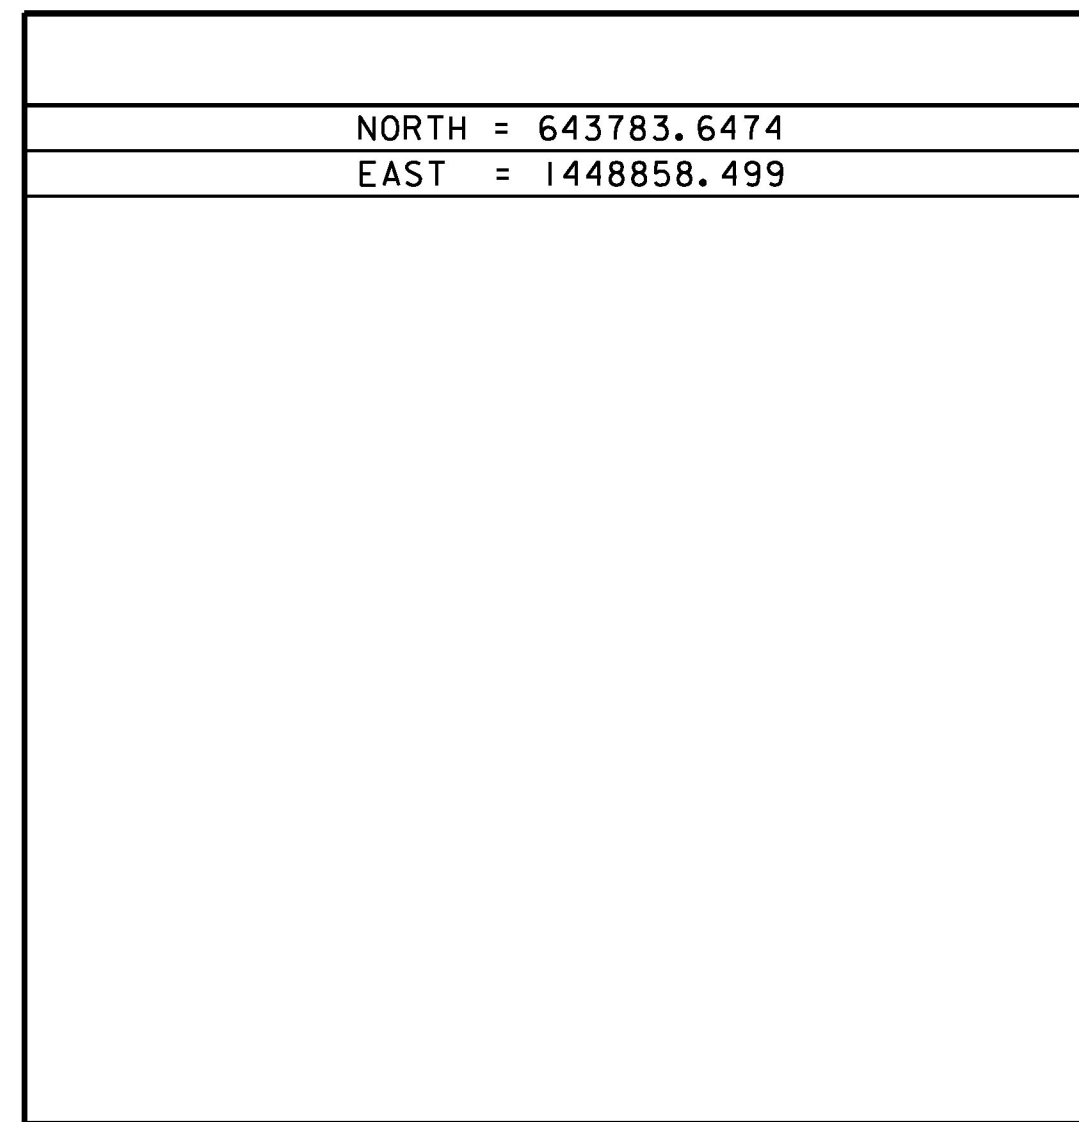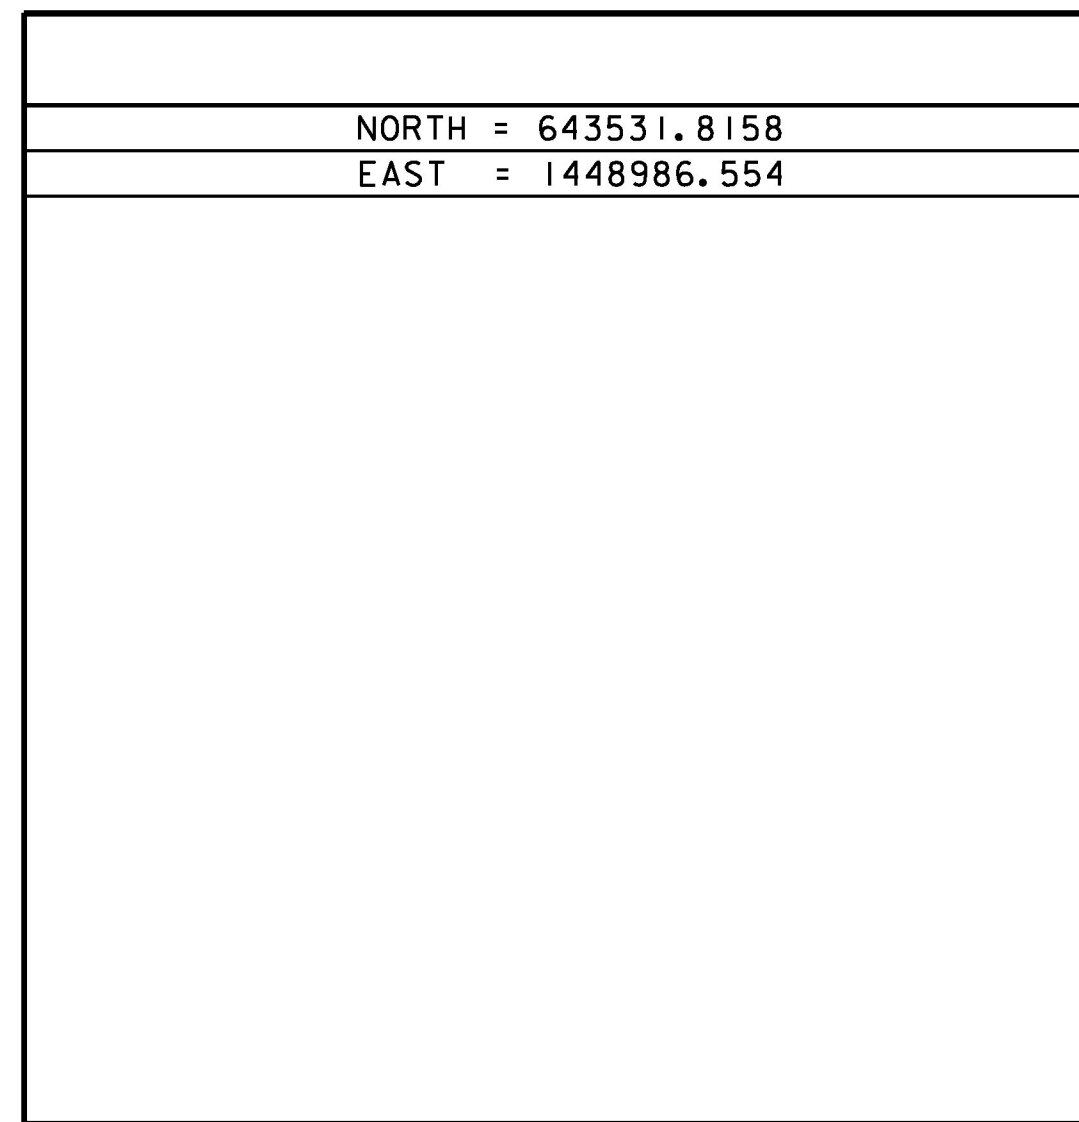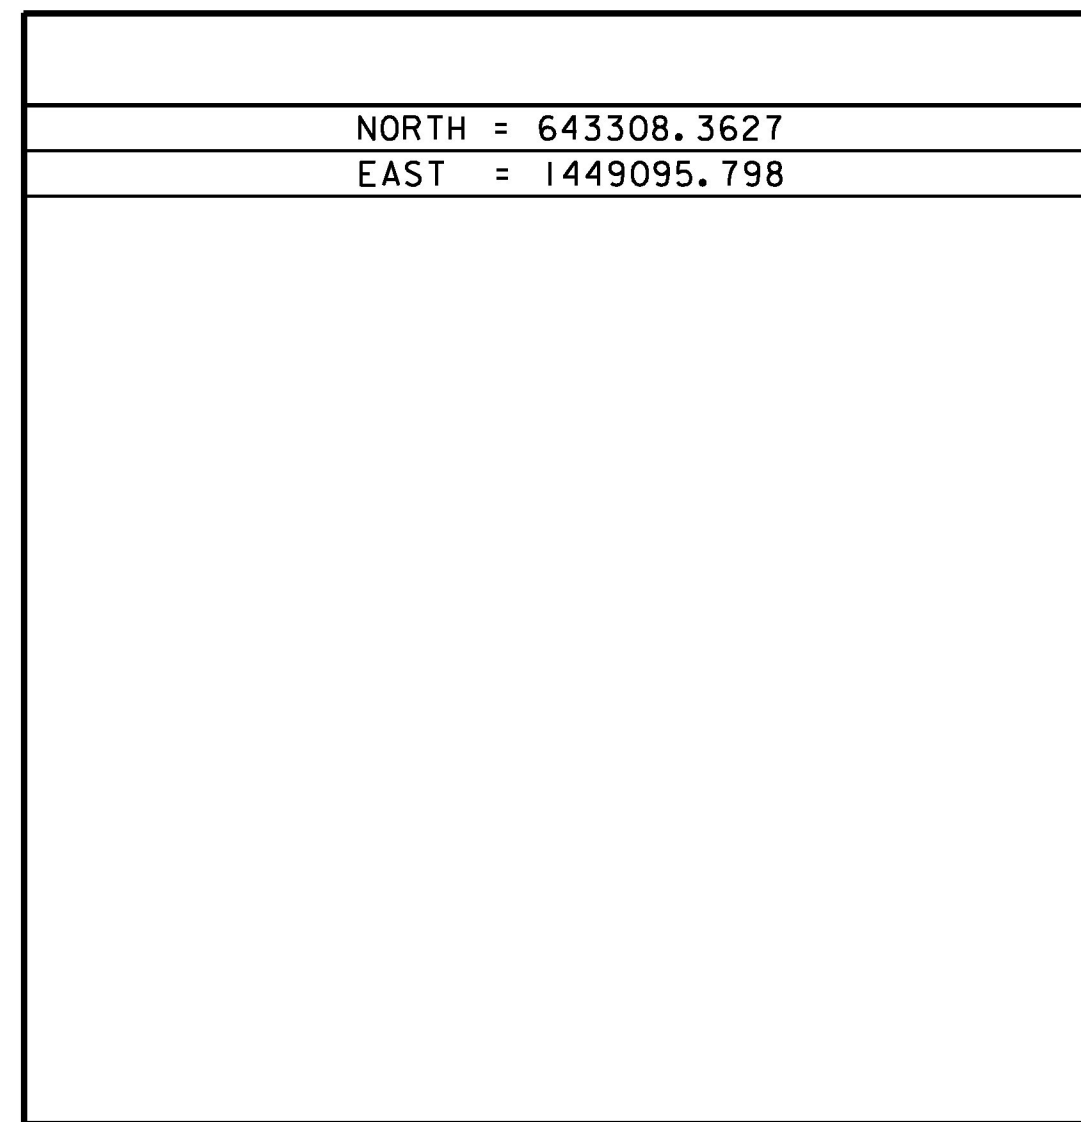

• ALIGNMENT STAKED

DATUM

VERTICAL	NAVD 88
HORIZONTAL	NAD 83 (96)
ADJUSTMENT	Compass

PROJECT NAME:	CHARLOTTE
PROJECT NUMBER:	F EGC 019-4(20)
FILE NAME:	d78d062_frm.dgn
PROJECT LEADER:	K. UPMAL
DESIGNED BY:	B. KIPP
TIE SHEET	2
PLOT DATE:	15-MAR-2016
DRAWN BY:	R. BULLOCK
CHECKED BY:	P. BEYOR
SHEET	II
OF	499