

LOCATION/TYPE	RADIUS STA/OFFSET	APPROX. WIDTH
STA 92+57 RT/(C)	STA 92+22.26/42.00 FT STA 92+78.91/42.00 FT	12 FT

CHAIN-LINK FENCE, 6 FEET
 STA 91+44 - 91+62 RT
 STA 91+44 - 91+62 LT


STEEL BEAM GUARDRAIL, GALVANIZED/NESTED
 STA 90+98 - 91+98 RT
 STA 90+98 - 91+98 LT

STONE FILL, TYPE II
 STA 3+50 - 5+87 RT
 STA 3+50 - 5+87 LT
 STA 20+20 - 20+75 RT
 STA 20+20 - 20+75 LT
 REMOVAL AND DISPOSAL OF GUIDE POSTS

REMOVAL OF EXISTING FENCE
 STA 91+48 - 92+02 LT (ABANDONED WOVEN WIRE)
 STA 92+18 - 92+21 LT (ABANDONED WOVEN WIRE)
 STA 92+35 - 93+60 LT (ABANDONED WOVEN WIRE)
 STA 94+79 - 95+15 LT (ABANDONED WOVEN WIRE)

STEEL BEAM GUARDRAIL, GALVANIZED
 STA 90+40 - 90+98 RT
 STA 90+48 - 90+98 LT
 STA 91+48 - 93+48 LT
 MANUFACTURED TERMINAL SECTION, FLARED

STA 94+85 RT
 STA 91+90 RT
 STA 92+21 RT

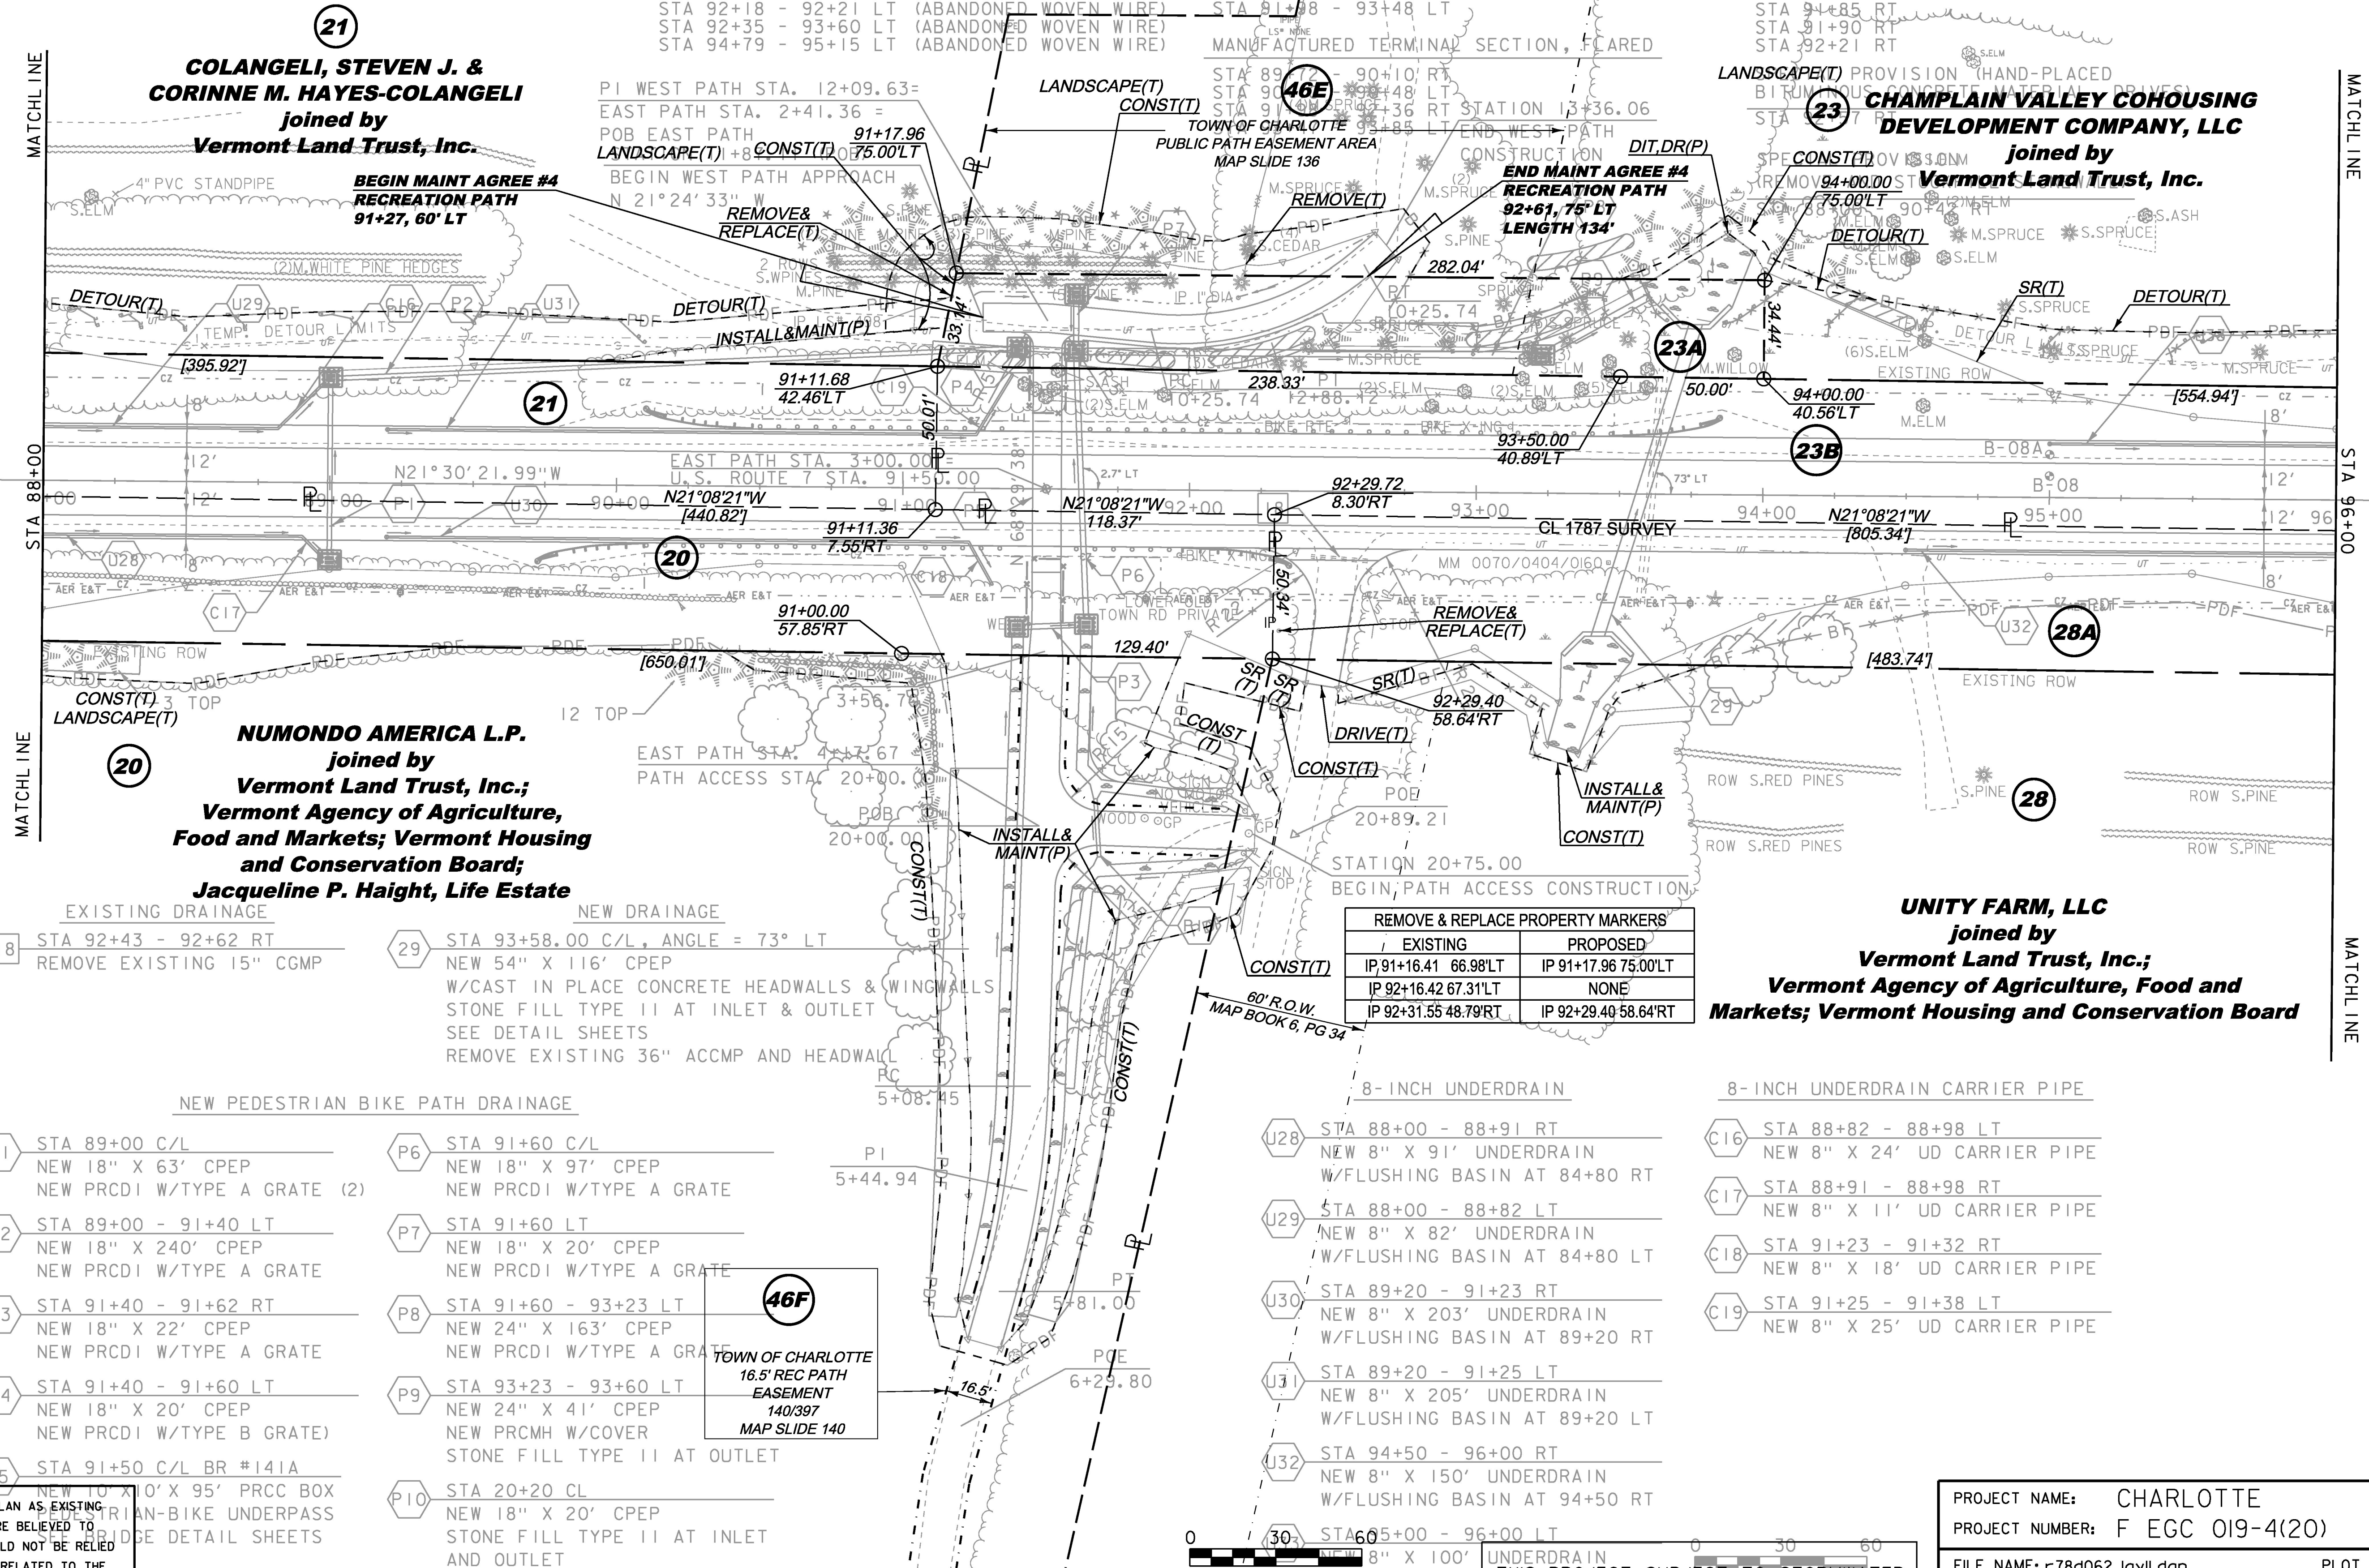

21
COLANGELI, STEVEN J. & CORINNE M. HAYES-COLANGELI
 joined by
Vermont Land Trust, Inc.

BEGIN MAINT AGREE #4 RECREATION PATH 91+27, 60' LT

20
NUMONDO AMERICA L.P.
 joined by
Vermont Land Trust, Inc.;
Vermont Agency of Agriculture, Food and Markets; Vermont Housing and Conservation Board;
Jacqueline P. Haight, Life Estate

23
CHAMPLAIN VALLEY COHOUSING DEVELOPMENT COMPANY, LLC
 joined by
Vermont Land Trust, Inc.

28
UNITY FARM, LLC
 joined by
Vermont Land Trust, Inc.;
Vermont Agency of Agriculture, Food and Markets; Vermont Housing and Conservation Board

46E
TOWN OF CHARLOTTE
16.5' REC PATH EASEMENT 140/397 MAP SLIDE 140

46F
TOWN OF CHARLOTTE
16.5' REC PATH EASEMENT 140/397 MAP SLIDE 140

23A
23B
28A
28

18
 STA 92+43 - 92+62 RT
 REMOVE EXISTING 15" CGMP

29
 STA 93+58.00 C/L, ANGLE = 73° LT
 NEW 54" X 116' CPEP
 W/CAST IN PLACE CONCRETE HEADWALLS & WING WALLS
 STONE FILL TYPE II AT INLET & OUTLET
 SEE DETAIL SHEETS
 REMOVE EXISTING 36" ACCMP AND HEADWALL

NEW PEDESTRIAN BIKE PATH DRAINAGE

P1 STA 89+00 C/L
 NEW 18" X 63' CPEP
 NEW PRCDI W/TYPE A GRATE (2)

P2 STA 89+00 - 91+40 LT
 NEW 18" X 240' CPEP
 NEW PRCDI W/TYPE A GRATE

P3 STA 91+40 - 91+62 RT
 NEW 18" X 22' CPEP
 NEW PRCDI W/TYPE A GRATE

P4 STA 91+40 - 91+60 LT
 NEW 18" X 20' CPEP
 NEW PRCDI W/TYPE B GRATE)

P5 STA 91+50 C/L BR #141A
 NEW 10' X 95' PRCC BOX
 NEW PEDESTRIAN-BIKE UNDERPASS
 SEE DETAIL SHEETS

P6 STA 91+60 C/L
 NEW 18" X 97' CPEP
 NEW PRCDI W/TYPE A GRATE


P7 STA 91+60 LT
 NEW 18" X 20' CPEP
 NEW PRCDI W/TYPE A GRATE

P8 STA 91+60 - 93+23 LT
 NEW 24" X 163' CPEP
 NEW PRCDI W/TYPE A GRATE

P9 STA 93+23 - 93+60 LT
 NEW 24" X 41' CPEP
 NEW PRCDI W/COVER
 STONE FILL TYPE II AT OUTLET

P10 STA 20+20 CL
 NEW 18" X 20' CPEP
 STONE FILL TYPE II AT INLET AND OUTLET

REMOVE & REPLACE PROPERTY MARKERS	
EXISTING	PROPOSED
IP 91+16.41 66.98'LT	IP 91+17.96 75.00'LT
IP 92+16.42 67.31'LT	NONE
IP 92+31.55 48.79'RT	IP 92+29.40 58.64'RT

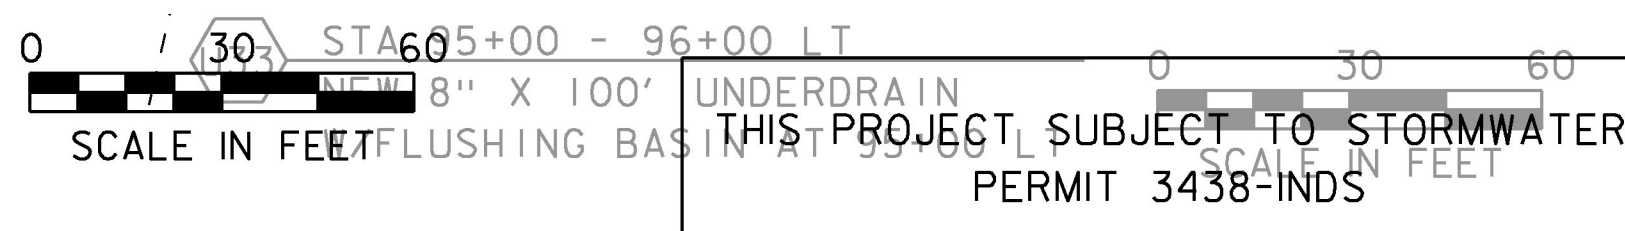

LINES SHOWN ON THIS PLAN AS EXISTING PROPERTY LINES P/L ARE BELIEVED TO BE ACCURATE BUT SHOULD NOT BE RELIED UPON FOR PURPOSES UNRELATED TO THE STATE OF VERMONT'S ACQUISITION OF LAND AND RIGHTS FOR THIS PROJECT.

PROJECT NAME: CHARLOTTE
 PROJECT NUMBER: F EGC 019-4(20)
 FILE NAME: r78d062_lay11.dgn
 PROJECT LEADER: K. UPMAL
 DESIGNED BY: B. KIPP
 ROW LAYOUT SHEET 11 OF 20
 PLOT DATE: 15-MAR-2016
 DRAWN BY: E. PIERCE
 CHECKED BY: E. PIERCE
 SHEET 53 OF 499

FOR R.O.W. USE ONLY